SITE PLAN

Concord Twp, LAKE COUNTY, OHIO

for: KAY Homes
CLIENT OWNER
7701 Southmeadow Dr Concord
ADDRESS STREET CITY ZIP

Lancaster Ridge Sub. #3	5-31	LOT	TRACT
SUBDIVISION NAME	VOL. PG.	VOLUME	PAGE
47	Tiffany Dr	PERM. PARCEL NO.	STREET
SUBLOT NO.	STREET		

Grading Plan Approved as shown and/or noted
THOMAS P. GILLES, P.E.
Lake County Engineer
By TPG Date 8-25-86

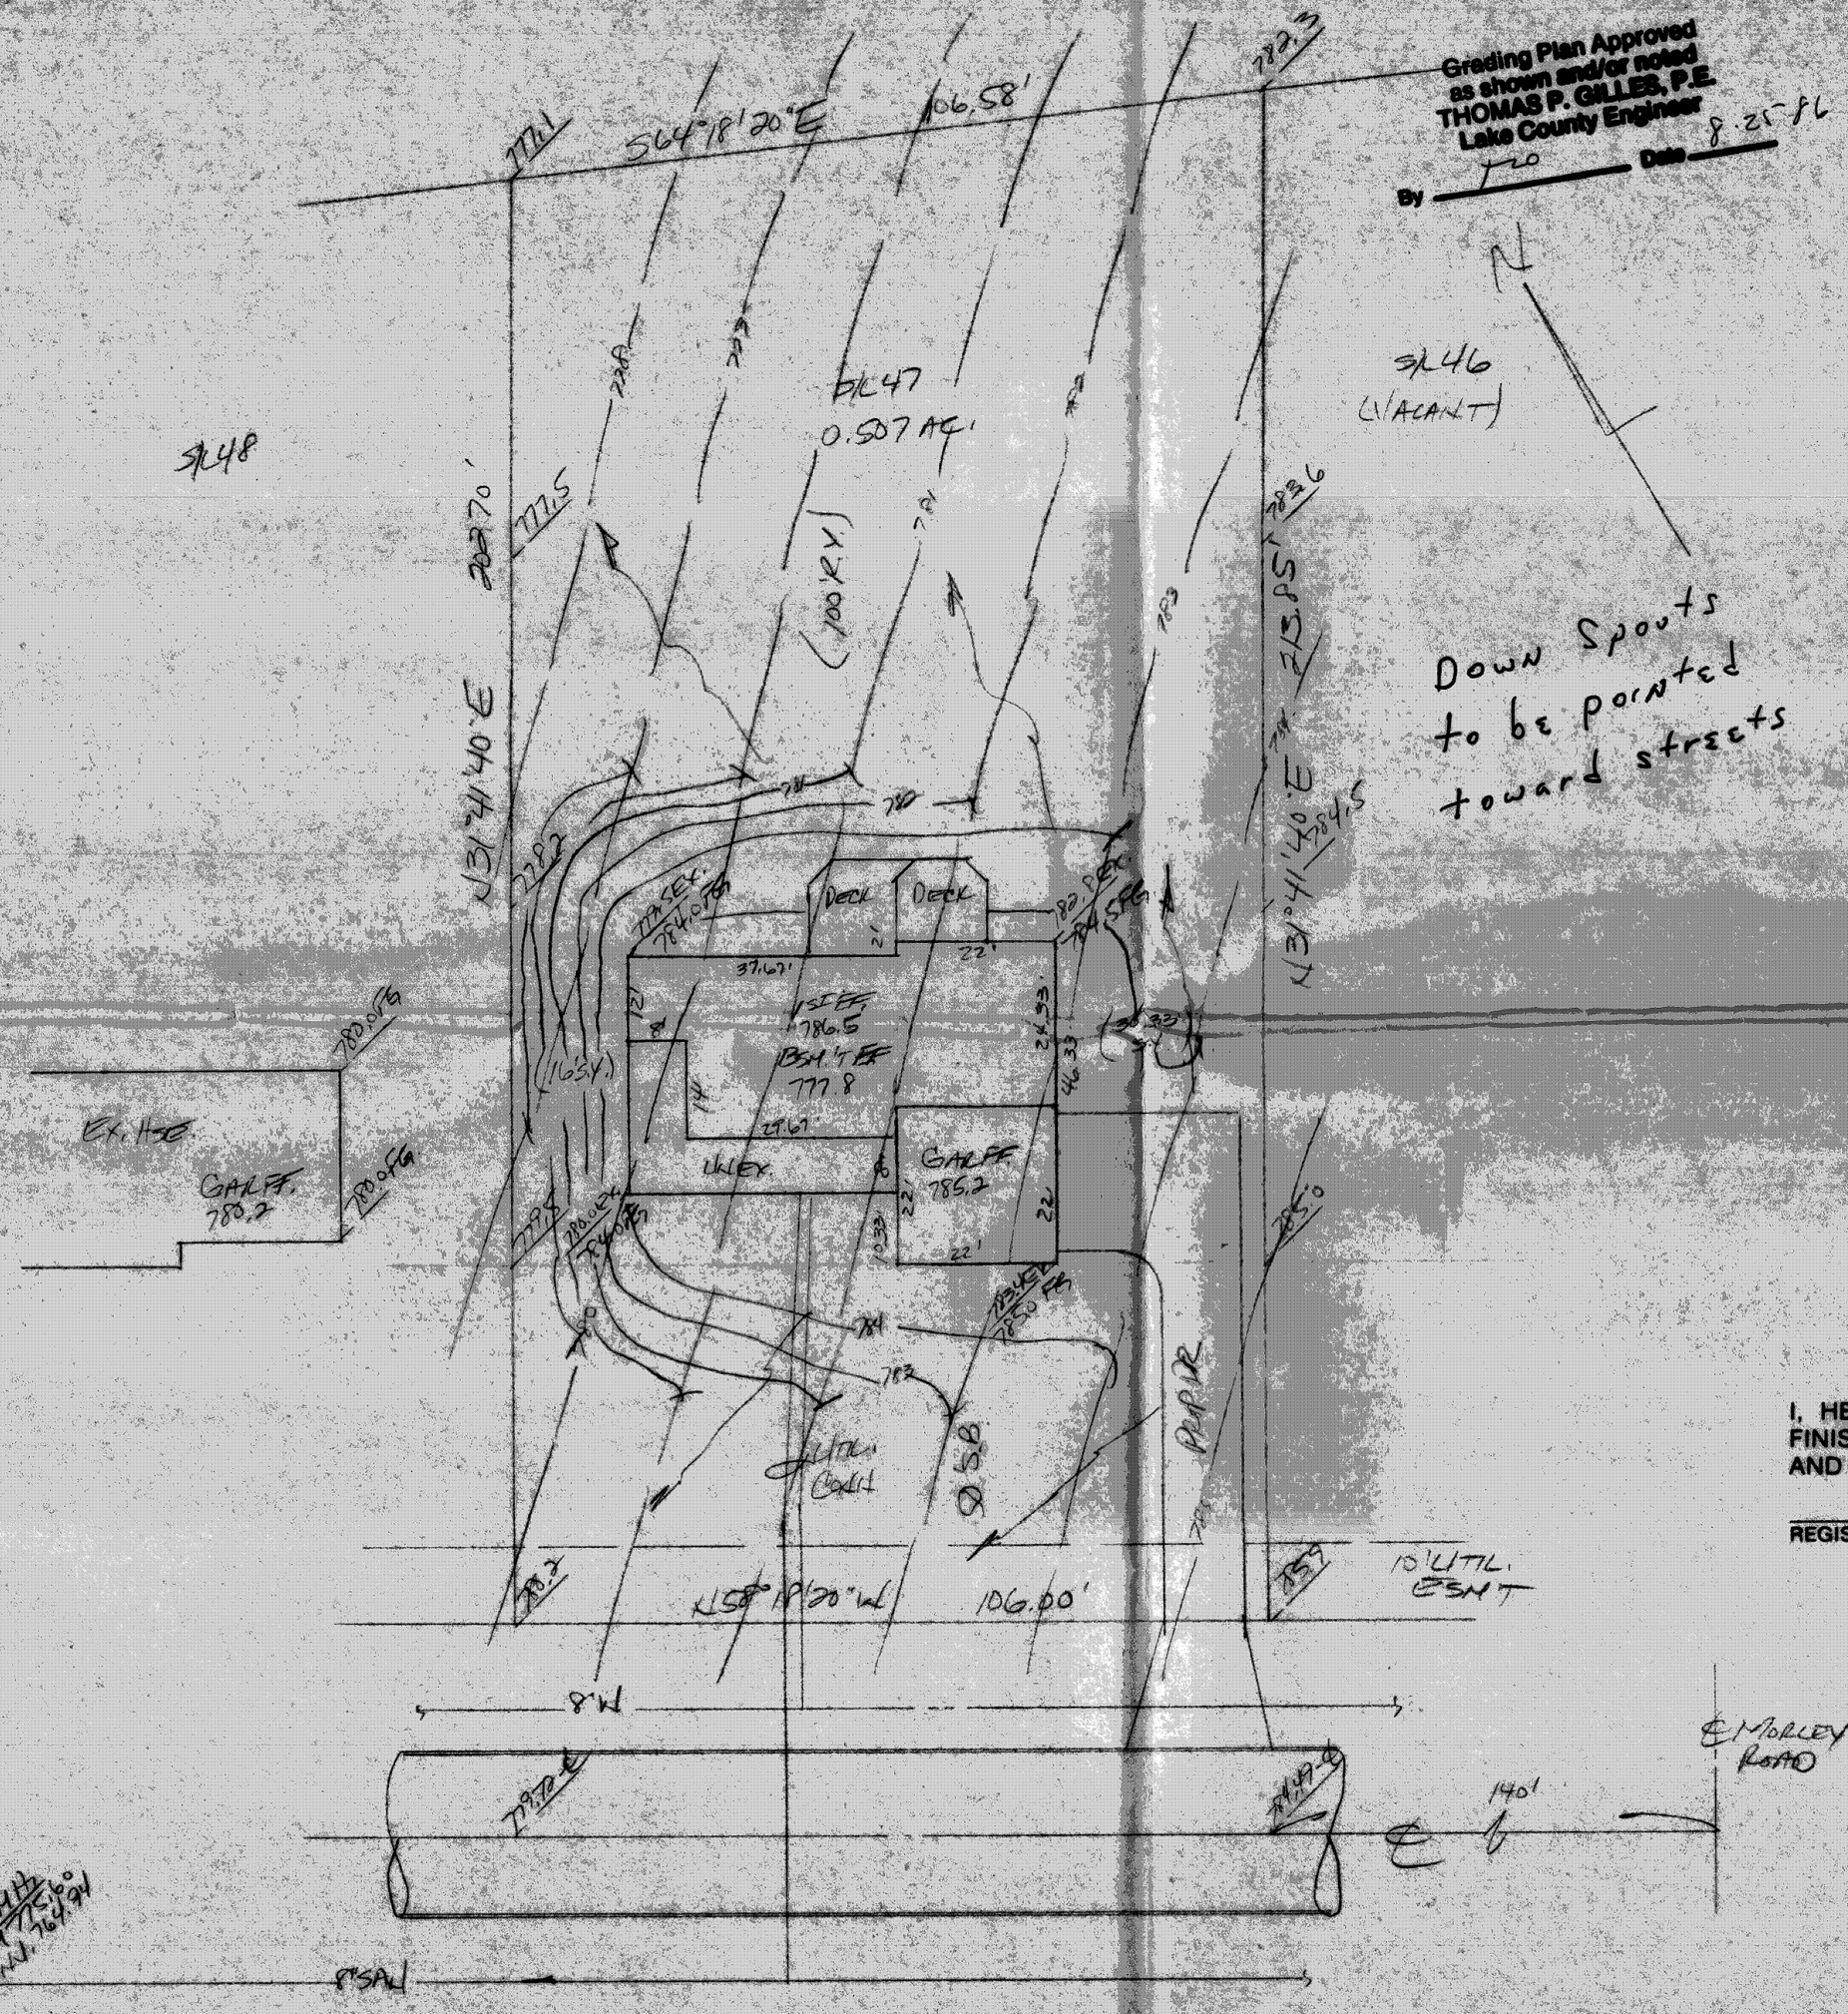
S64°18'20"E 106.58'
S31°41'40"E 207.70'
N31°41'40"E 215.85'
SL48
SL47
0.507 AC.
(100'R/W)
SL46
(VACANT)
Down Spouts to be pointed toward streets
DECK
DECK
PATIO
PATIO
37.67'
22'
24'
24.93'
46.33'
GAR. FF 786.5
BSMT EL 777.8
GAR. FF 785.2
GAR. FF 780.2
EX. HSE
UNEX.
UNEX.
22'
22'
24'
27.67'
780.0FG
780.0FG
780.0FG
784.0FG
784.0FG
784