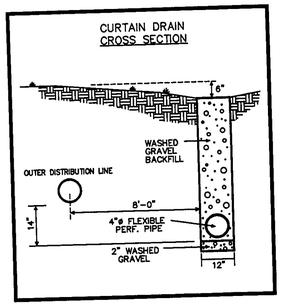

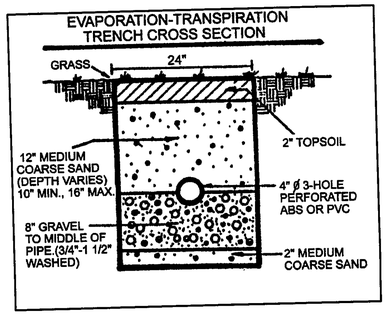

Grading Plan Approved as shown and/or noted
THOMAS P. GILLES, P.E.
Lake County Engineer
by TPM Date 6/3/99

REVIEWED AND ACCEPTED
LAKE COUNTY GENERAL
HEALTH DISTRICT
Date 7-21-99 By
Russell B. Norris
SEWAGE DISPOSAL PERMIT MUST BE OBTAINED BY A LAKE COUNTY LICENSED INSTALLER BEFORE INSTALLATION IS STARTED.

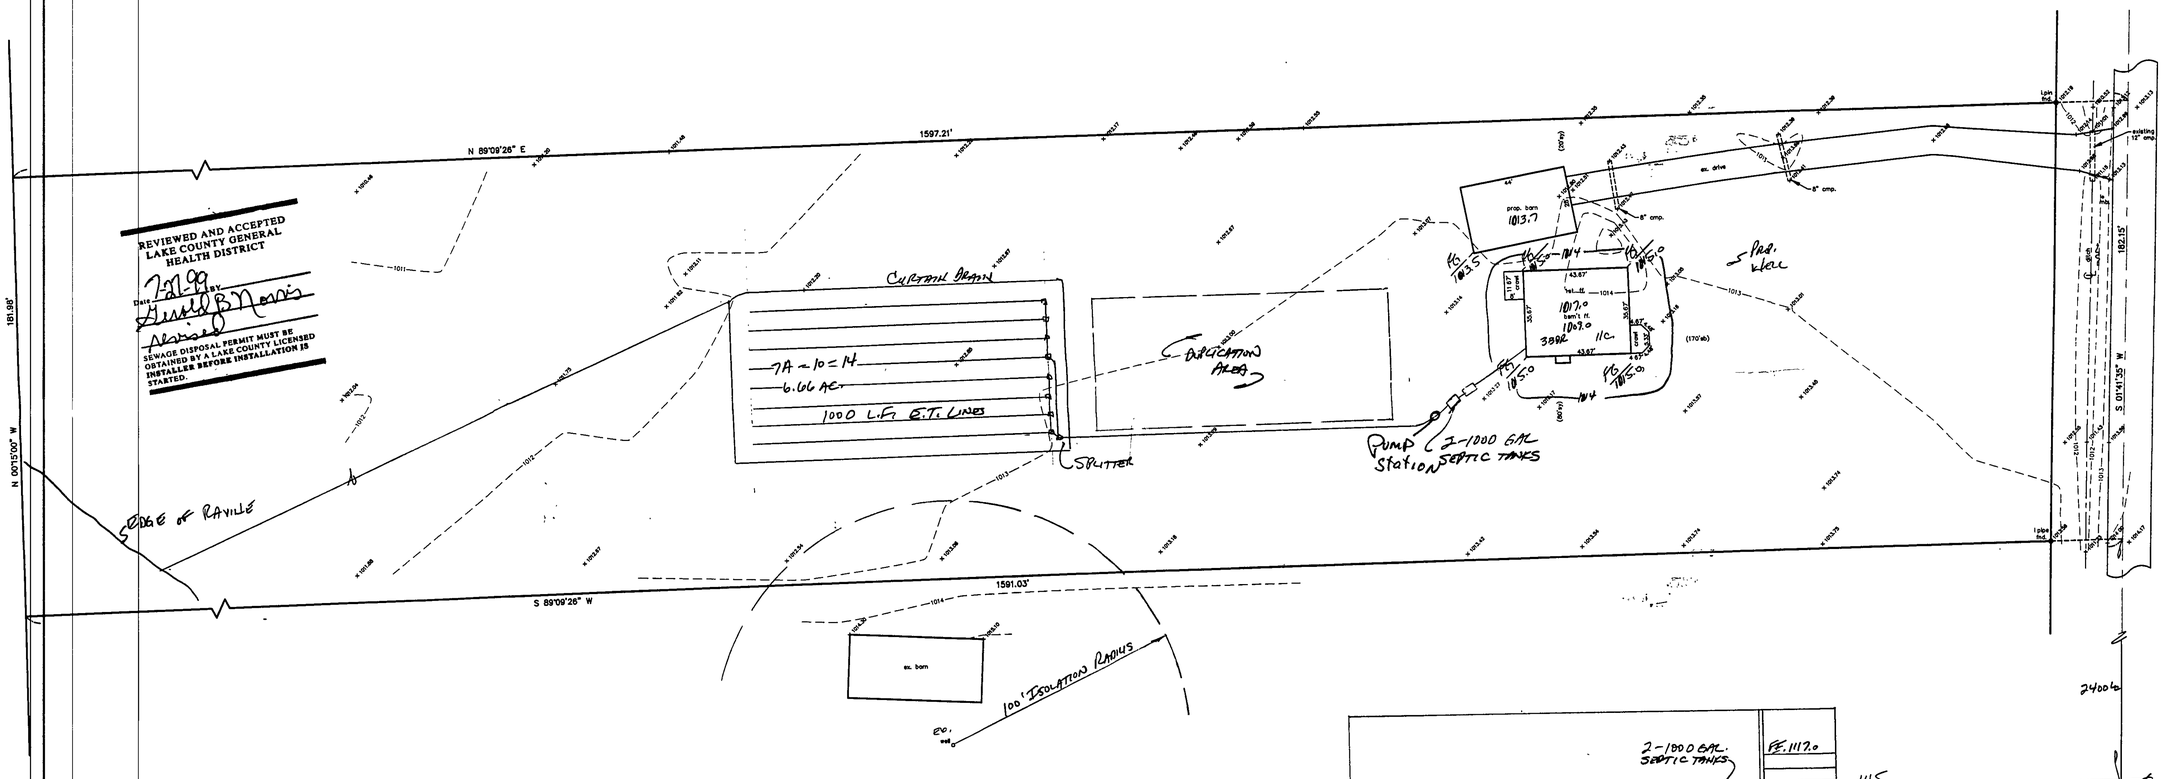

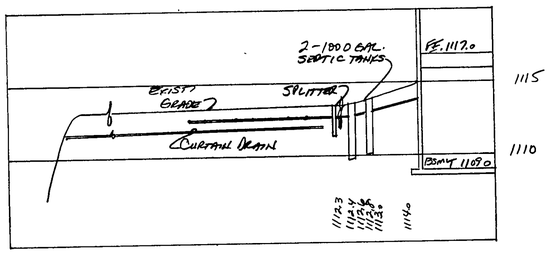

HYDRAULIC PROFILE
HORZ: 1"=30' VERT: 1"=5'

"I, the undersigned hereby certify that this topography indicated by 6", 1', or 2' contours, and elevations shown hereon represent an actual field survey made by me on the 23rd day of JUNE, 1999 and that the elevations were taken at appropriate intervals and that as of that date they existed as indicated hereon."
Name Reg. No. #6343

"I, the undersigned hereby certify that this topography indicated by 6", 1' or 2' contours, and elevations shown hereon represent an actual field survey made by me on the 23rd day of JUNE, 1999 and that the elevations were taken at appropriate intervals and that as of that date they existed as indicated hereon."
Name Reg. No. #6343

STATE OF OHIO HARRY S. JONES, JR. 6343 REGISTERED PROFESSIONAL SURVEYOR

REV NO.	DESCRIPTION	DATE	BY	CHK'D
1	REVISED SEPTIC	7/19/99	HJ	HJ

BABCOCK, JONES AND ASSOCIATES, INC
CIVIL ENGINEERS – SURVEYORS – LAND PLANNERS
PAINESVILLE OHIO 44077

DATE	6/22/99
DESIGN BY	H.J.
DRAWN BY	T.R.
APPROVED BY	H.J.

SITE PLAN
FOR
TOM SHIKNER

LEROY TOWNSHIP LAKE COUNTY

SCALE: 1"=30'
JOB NO 99-154
SHEET 1 OF 1

BROCKWAY ROAD – 40'