SITE PLAN FOR LOU PIRC
BEING PART OF LOT 4, TRACT 1 IN MADISON TWP., LAKE COUNTY, OHIO

DRAWN BY:	JFT	DATE:	06/17/94
CHECKED BY:	JCS	DRAWING NO:	AZT-039
JOB NO.:	94044	SHEET	1 OF 1

REVISIONS:
⚠ SEPT 19,94 LOCATE DITCH. STATEMENT C.D. OUTLET

7011 CENTER STREET MENTOR OHIO 44060
216-974-0555
FAX 974-5054
AZTECH
SURVEYORS and ENGINEERS
Civil Engineering · Land Surveying

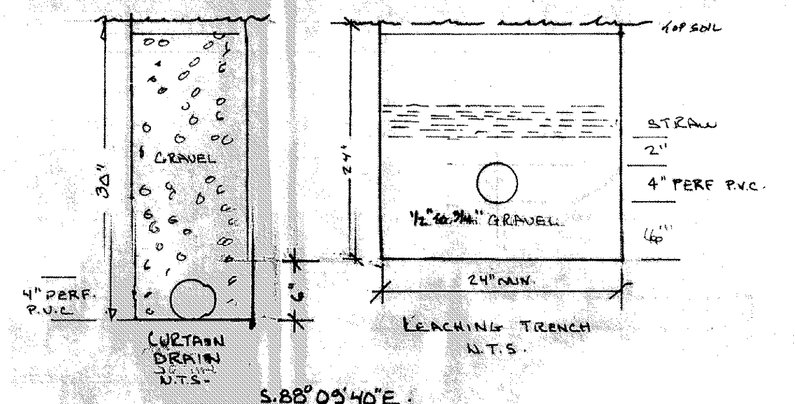

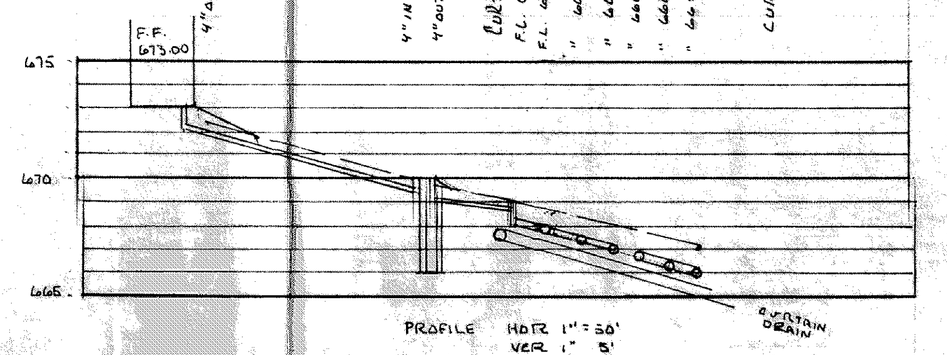

"I, the undersigned hereby certify that this topography, indicated by 5', 1' or 2' contours, and elevations shown hereon represent an actual field survey made by me on the 6 day of June, 19 94 and that the elevations were taken at appropriate intervals and that as of that date they existed as indicated hereon."

John C. Skonieczny — S-6356
Name — Reg. No

Reviewed and Accepted
as shown and/or noted
THOMAS P. GILLES, P.E.
Lake County Engineer
BJH Date 10/7/94

DITCH LOCATED WITH A FLOOD ZONE
MAP # 390771 0016C

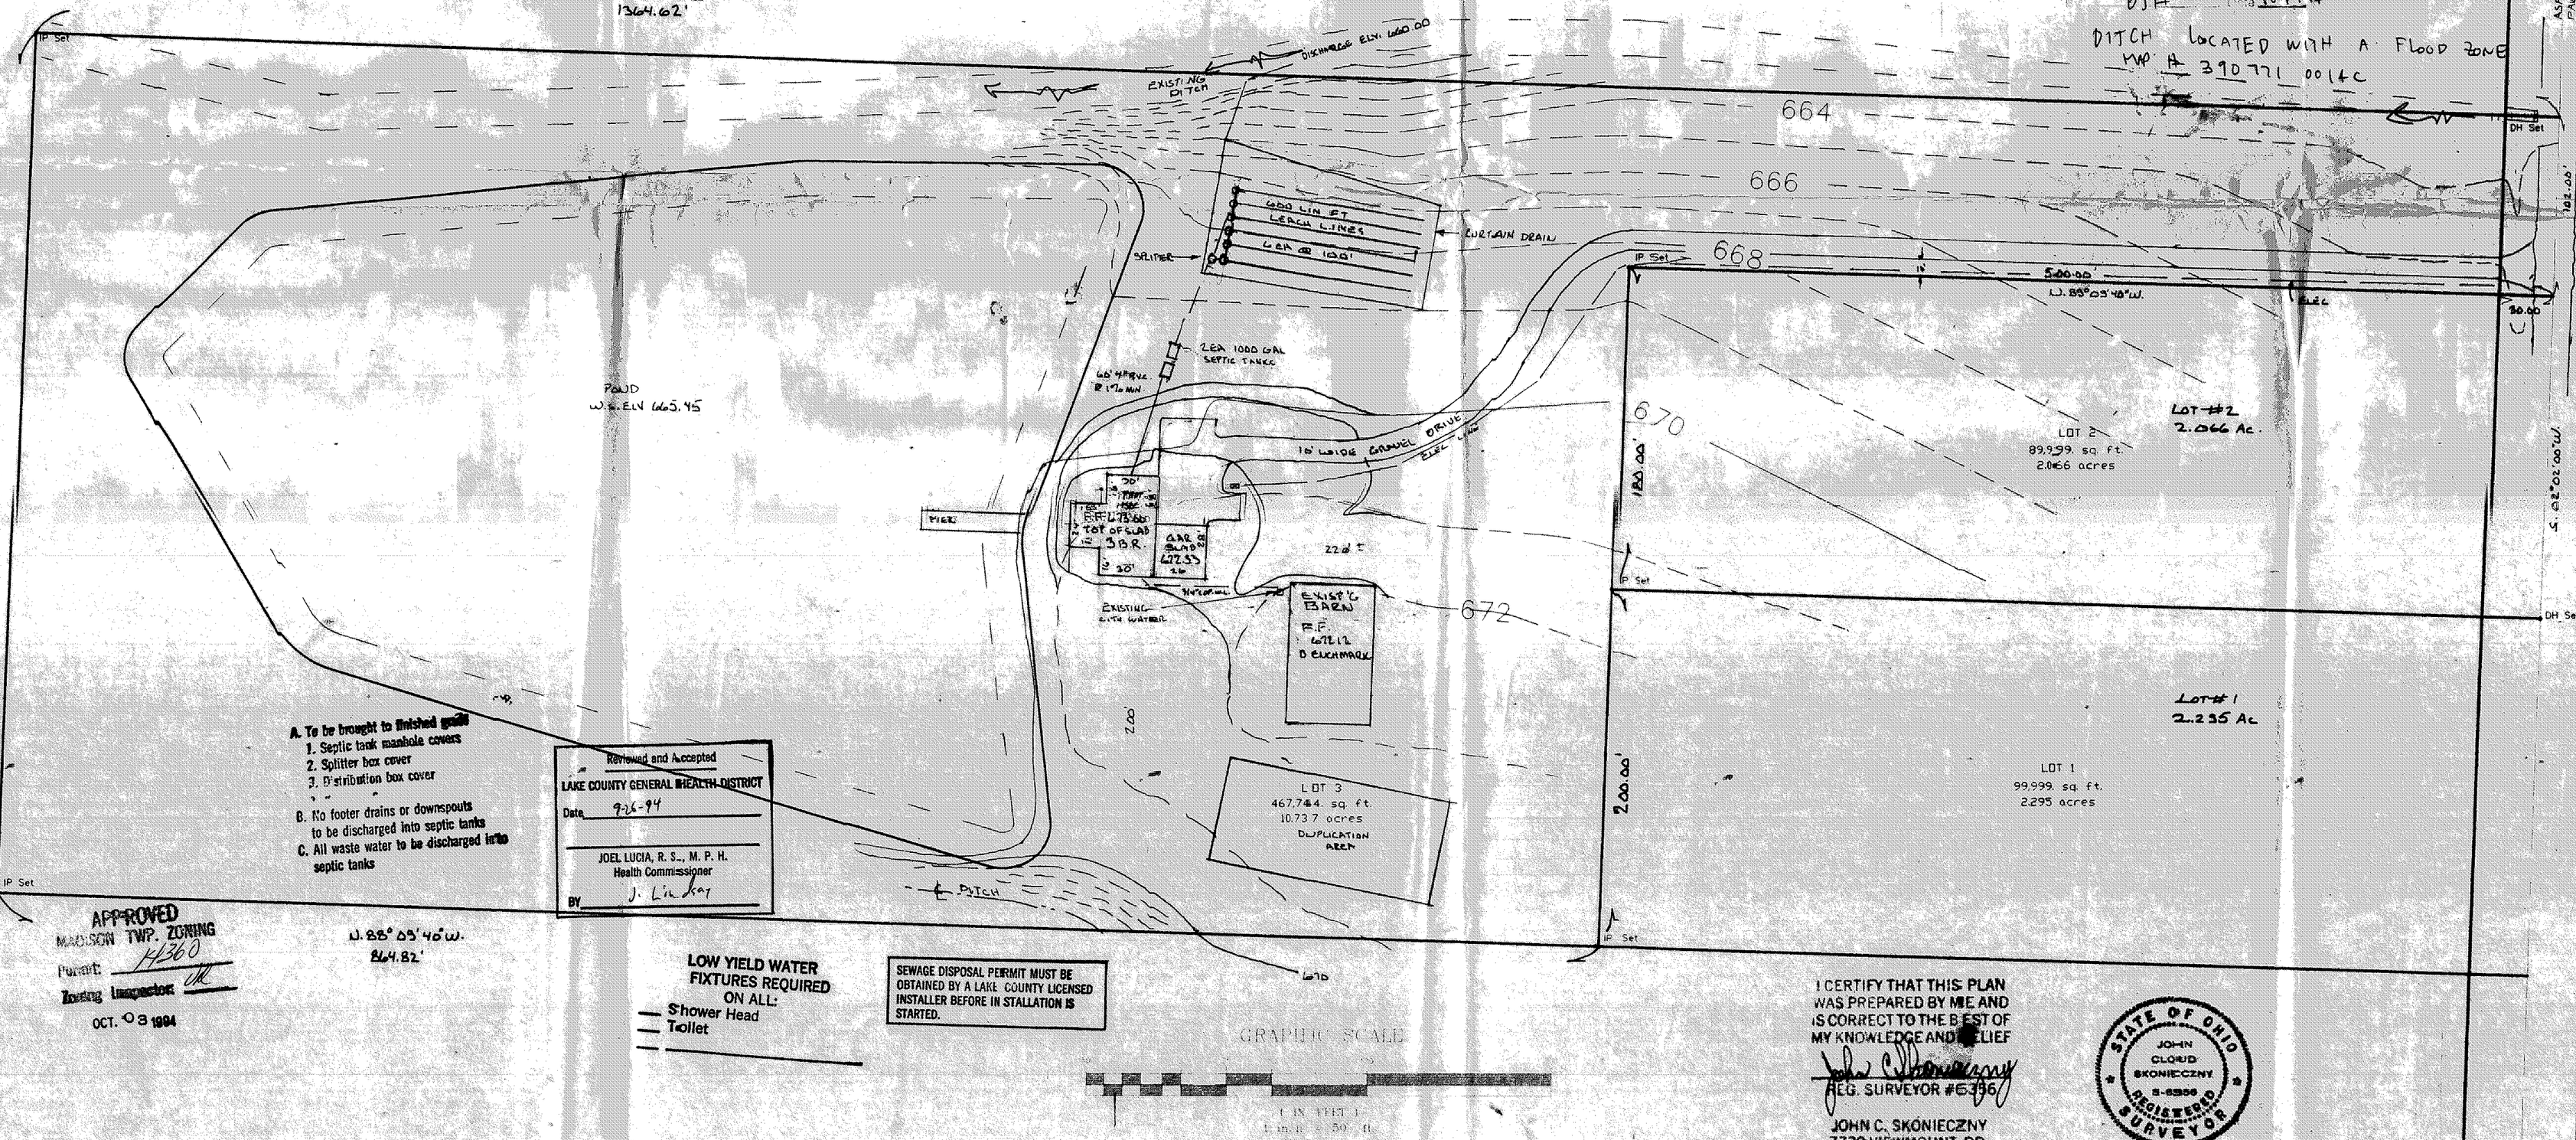

A. To be brought to finished grade
1. Septic tank manhole covers
2. Splitter box cover
3. Distribution box cover
B. No footer drains or downspouts to be discharged into septic tanks
C. All waste water to be discharged into septic tanks

Reviewed and Accepted
LAKE COUNTY GENERAL HEALTH DISTRICT
Date 9-28-94
JOEL LUCIA, R. S., M. P. H.
Health Commissioner
BY J. Lucia

APPROVED
MADISON TWP. ZONING
Permit: #4360
Zoning Inspector: MK
OCT. 03 1994

LOW YIELD WATER FIXTURES REQUIRED ON ALL:
— Shower Head
— Toilet
—

SEWAGE DISPOSAL PERMIT MUST BE OBTAINED BY A LAKE COUNTY LICENSED INSTALLER BEFORE IN STALLATION IS STARTED.

GRAPHIC SCALE
1 IN FEET
1 inch = 50 ft.

I CERTIFY THAT THIS PLAN WAS PREPARED BY ME AND IS CORRECT TO THE BEST OF MY KNOWLEDGE AND BELIEF
John C. Skonieczny
REG. SURVEYOR #6356
JOHN C. SKONIECZNY
7739 VIEWMOUNT DR.
PAINESVILLE, OHIO 44077

STATE OF OHIO
JOHN CLOUD SKONIECZNY
S-6356
REGISTERED SURVEYOR