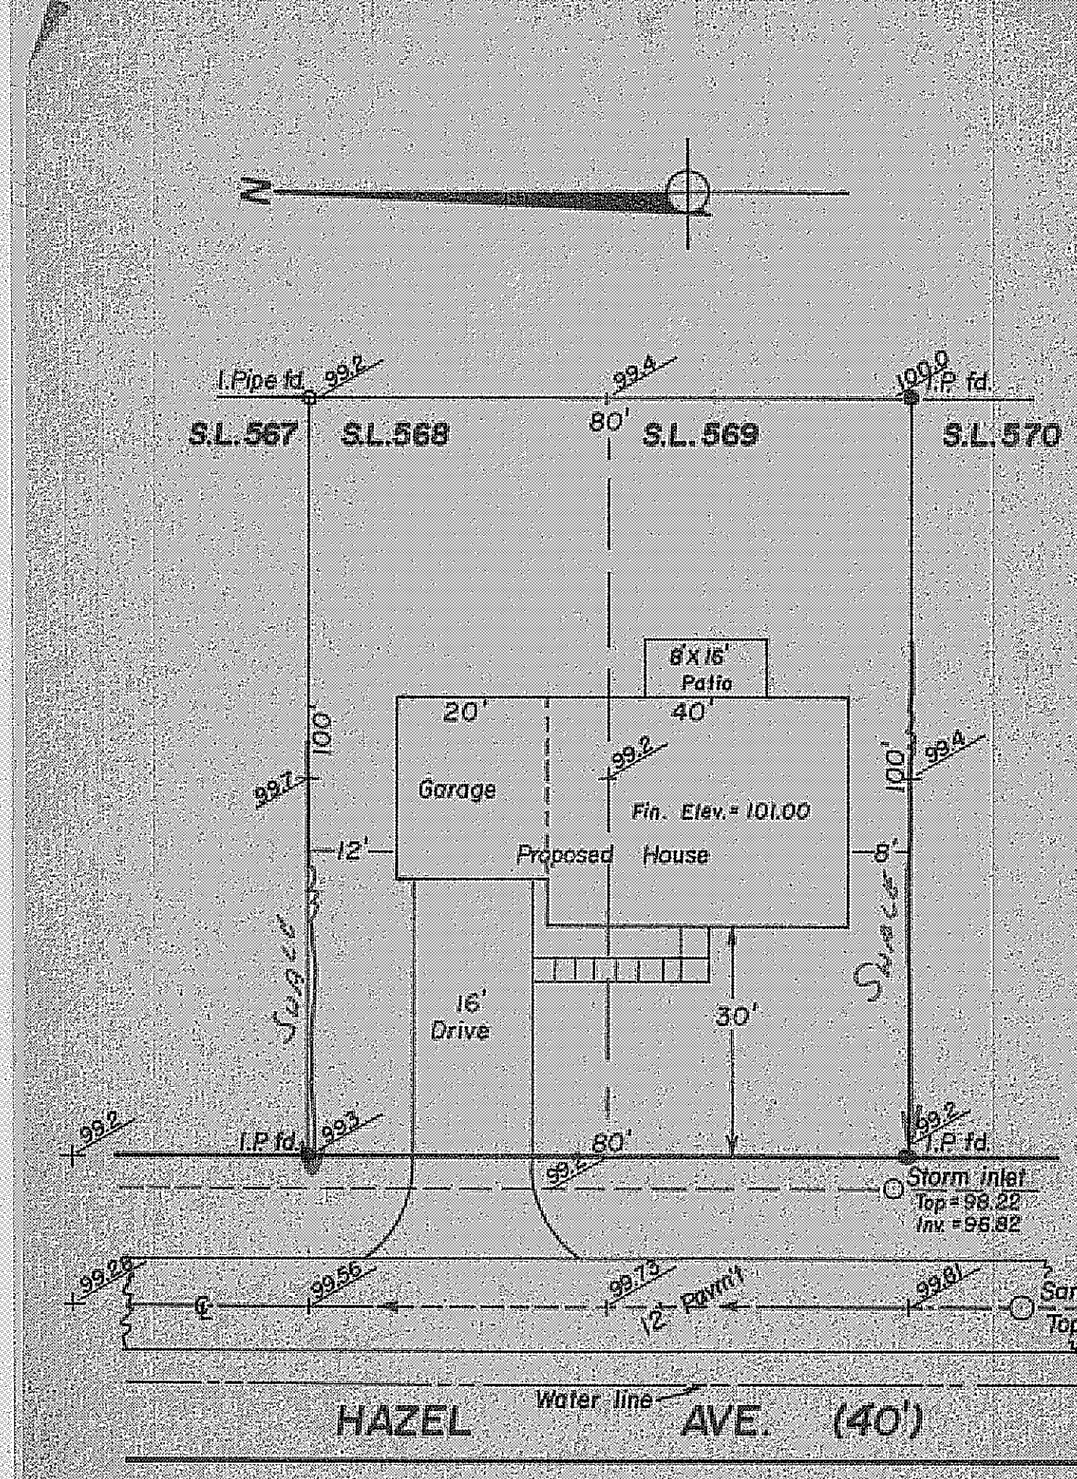

SITE PLAN
for
Pac Homes

Sublots 568 & 569, Madison Lakeland Subd.
Madison Twp., Lake Co., Ohio
Aug., 1978 1"=20'

Grading Plan Approved
as shown and/or noted
THOMAS P. GILLES, P.E.
Lake County Engineer
By _____ Date 8-7-78

Res.
Top of Foundation
101.90

STATE OF OHIO
THOMAS
GROMLEY
4848
REGISTERED
SURVEYOR

Thomas L. Gromley & Assoc.
Jefferson, Ohio