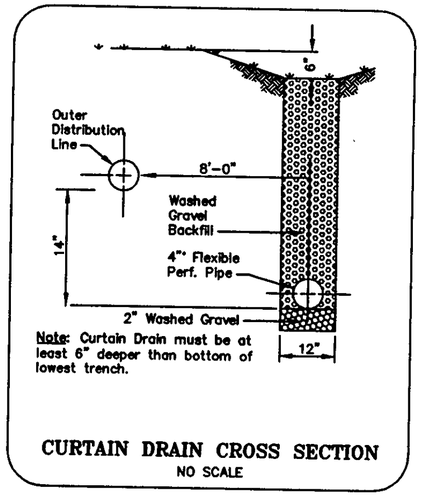

CURTAIN DRAIN CROSS SECTION
NO SCALE

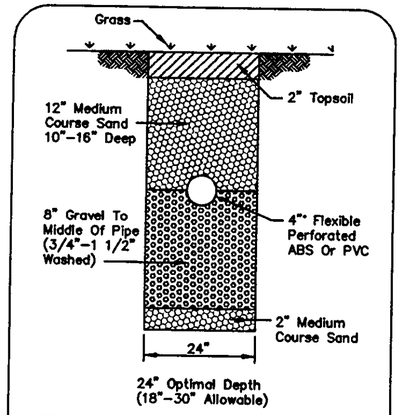

EVAPORATION-TRANSPIRATION TRENCH CROSS-SECTION
NO SCALE

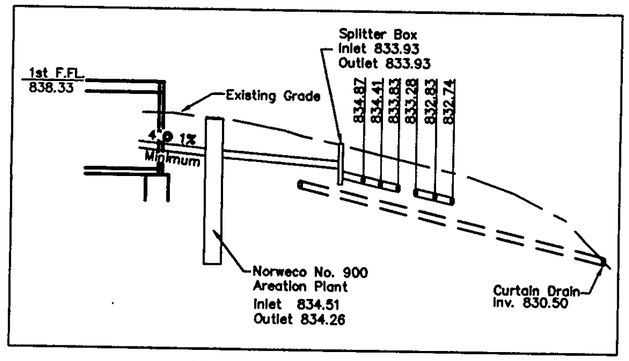

Hydraulic Profile

SITE PLAN

for : J.W. Betteley Building Co.
CLIENT

411 North State St. Painesville OH 44077
ADDRESS CITY STATE ZIP

9 Silver Ash Subdivision
SUBLOT No. SUBDIVISION NAME VOL. PAGE

LOT TRACT Madison Twp. CITY Ohio STATE

Foresight Engineering Group
440 286-1010
440 286-1034 fax
320 Center Street, Unit F
Chardon, Ohio 44024
Engineers & Surveyors

SCALE : 1" = 40'	1
FILE NAME: I:\Bet10102\SL-9	2
DATE : October 12, 2001	3

BENCHMARK: Top of Mon. Elev. = 831.76

SHEET NO. 1/2

REVIEWED AND ACCEPTED
LAKE COUNTY GENERAL HEALTH DISTRICT
Date 10-31-01 BY Gerald B Morris
SEWAGE DISPOSAL PERMIT MUST BE OBTAINED BY A LAKE COUNTY LICENSED INSTALLER BEFORE INSTALLATION IS STARTED

Foresight Engineering Group, Inc.

STATE OF OHIO
STEVEN N. ROESSNER S-7070 REGISTERED PROFESSIONAL SURVEYOR

"I, the undersigned hereby certify that this topography, indicated by 6", 1' or 2' contours, and the elevations shown hereon represent an actual field survey made by Foresight Engineering Group, Inc. on the 4 day of October, 1999 and that the elevations were taken at appropriate intervals and that as of that date they existed as indicated hereon."

Steven N. Roessner
NAME

GRAPHIC SCALE
40 0 20 40 80 160
(IN FEET)
1 inch = 40 ft.

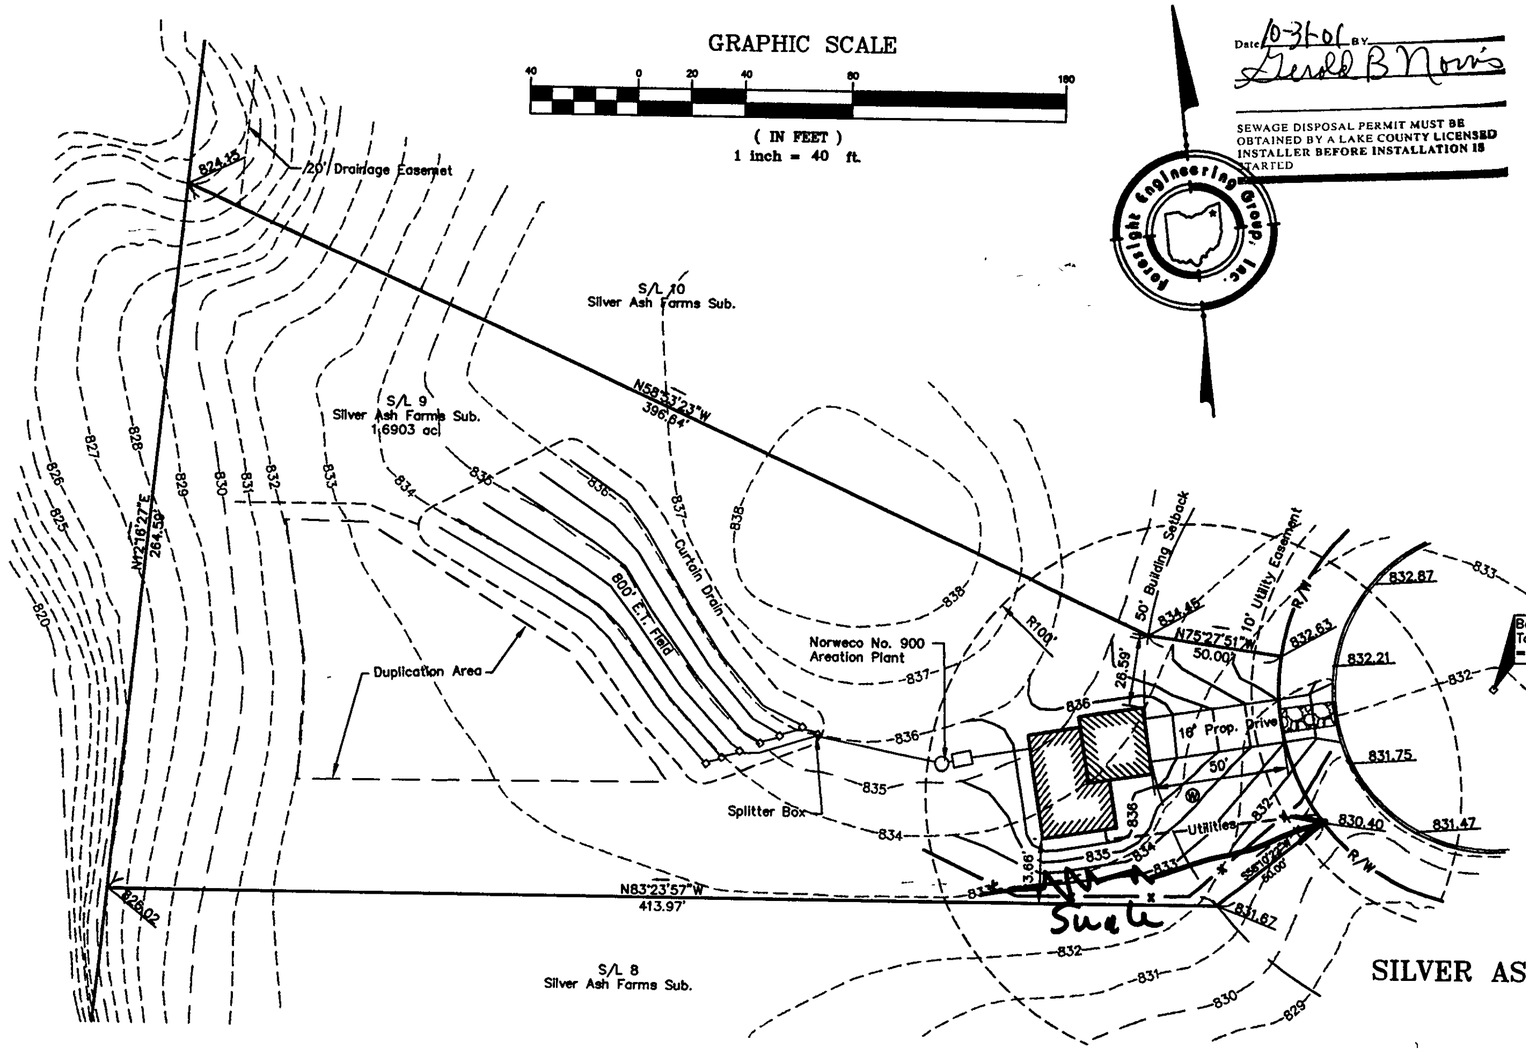

SILVER ASH TRAIL ~ 60'

CONTOUR LEGEND
- Existing 1' Contours
- Existing 5' Contours
- Proposed 1' Contours
- Proposed 5' Contours

EROSION CONTROL SYMBOLS
- Silt Fence
- Construction Entrance

Grading Plan Approved as shown and/or noted
JAMES R. GILLS, P.E.
Lake County Engineer
By GJH Date 11-16-01
Swale as shown

ROOF DRAINS SHALL DISCHARGE TO SPLASH BLOCKS.