


NOTE: UNDERLINED ELEVATIONS ARE PROPOSED FINISHED GRADES.

PAINESVILLE TOWNSHIP
ZONING O.K.
PENDING DRAINAGE

R. M. Hark
Zoning Inspector

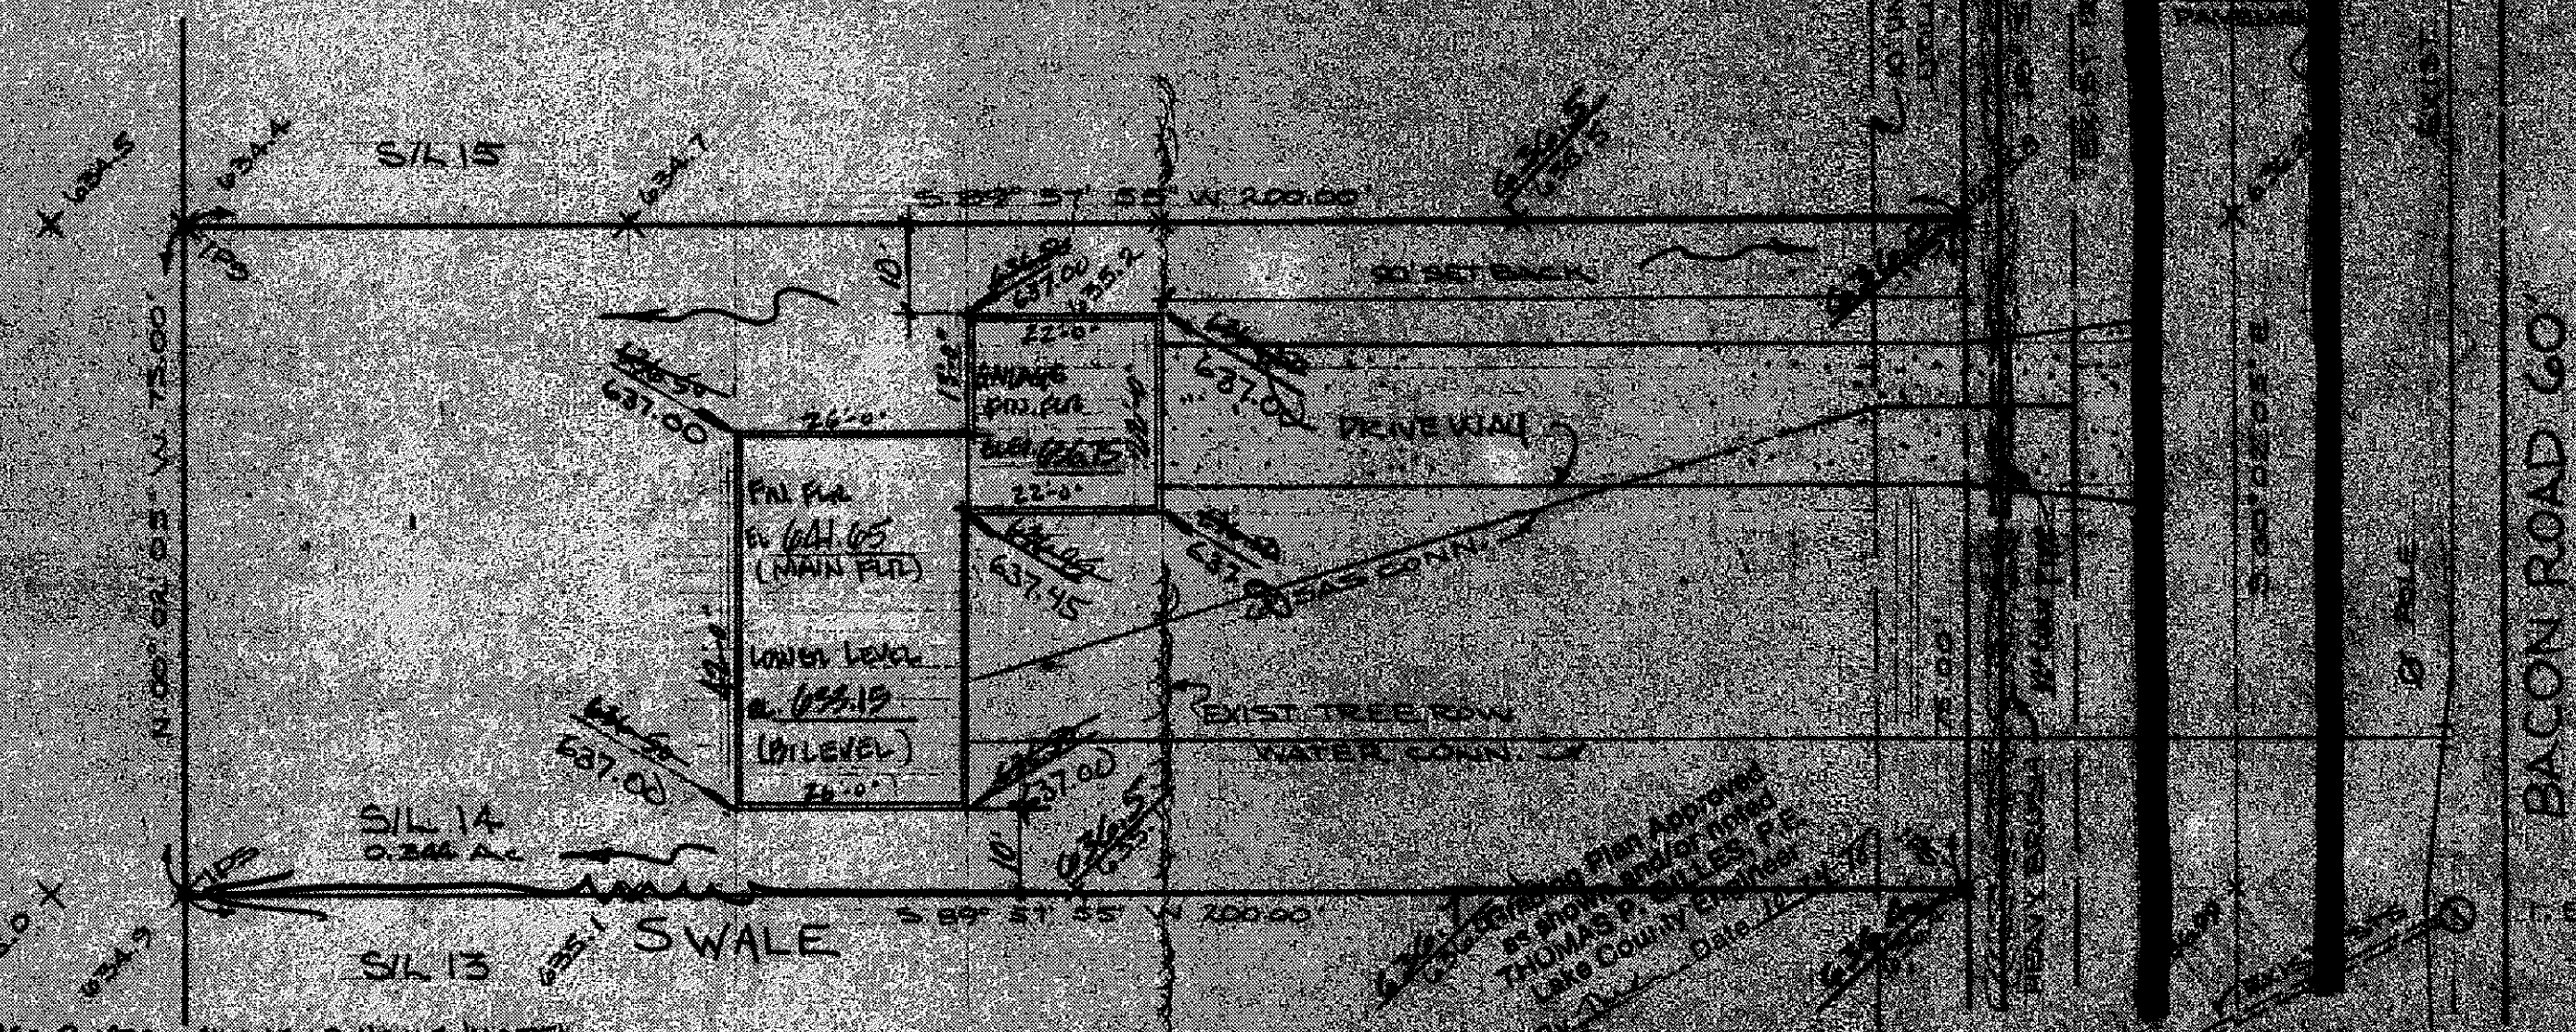

Grading Plan Approved
as shown and for record
THOMAS P. SULLS, P.E.
Lake County Engineer
By *[Signature]* Date 12/21/78

REVISED: 06/3/1978 CHANGED HOUSE MODEL.

DESIGN CERTIFICATION
THIS PLAN WAS PREPARED BY ME AND IS CORRECT TO THE BEST OF MY KNOWLEDGE AND BELIEF.
[Signature]
REG. SURVEYOR NO. 4285

AS BUILT CERTIFICATION
I HEREBY CERTIFY THAT THE CIRCLED GRADES ARE EXISTING FINISH GRADES CHECKED IN THE FIELD ON _____ AND THAT SURVEY IS CORRECT TO THE BEST OF MY KNOWLEDGE AND BELIEF.
REG. SURVEYOR NO. _____

COLPETZER WOODS
CONSULTANTS, INC.
193 SOUTH STATE STREET • PAINESVILLE, OHIO 44077 • (419) 337-7500

DATE: 12/21/78
SCALE: 1"=20'
SHEET: 1 OF 1
JOB NO. 78014
BY: [Signature]

EDWARD TRESSER, INC.
3100 DEERWOOD BLVD. MENTOR, OHIO
BEING LOTS 13 & 14 THE SULLS SUBDIVISION
PAINESVILLE TWP. LAKE COUNTY OHIO