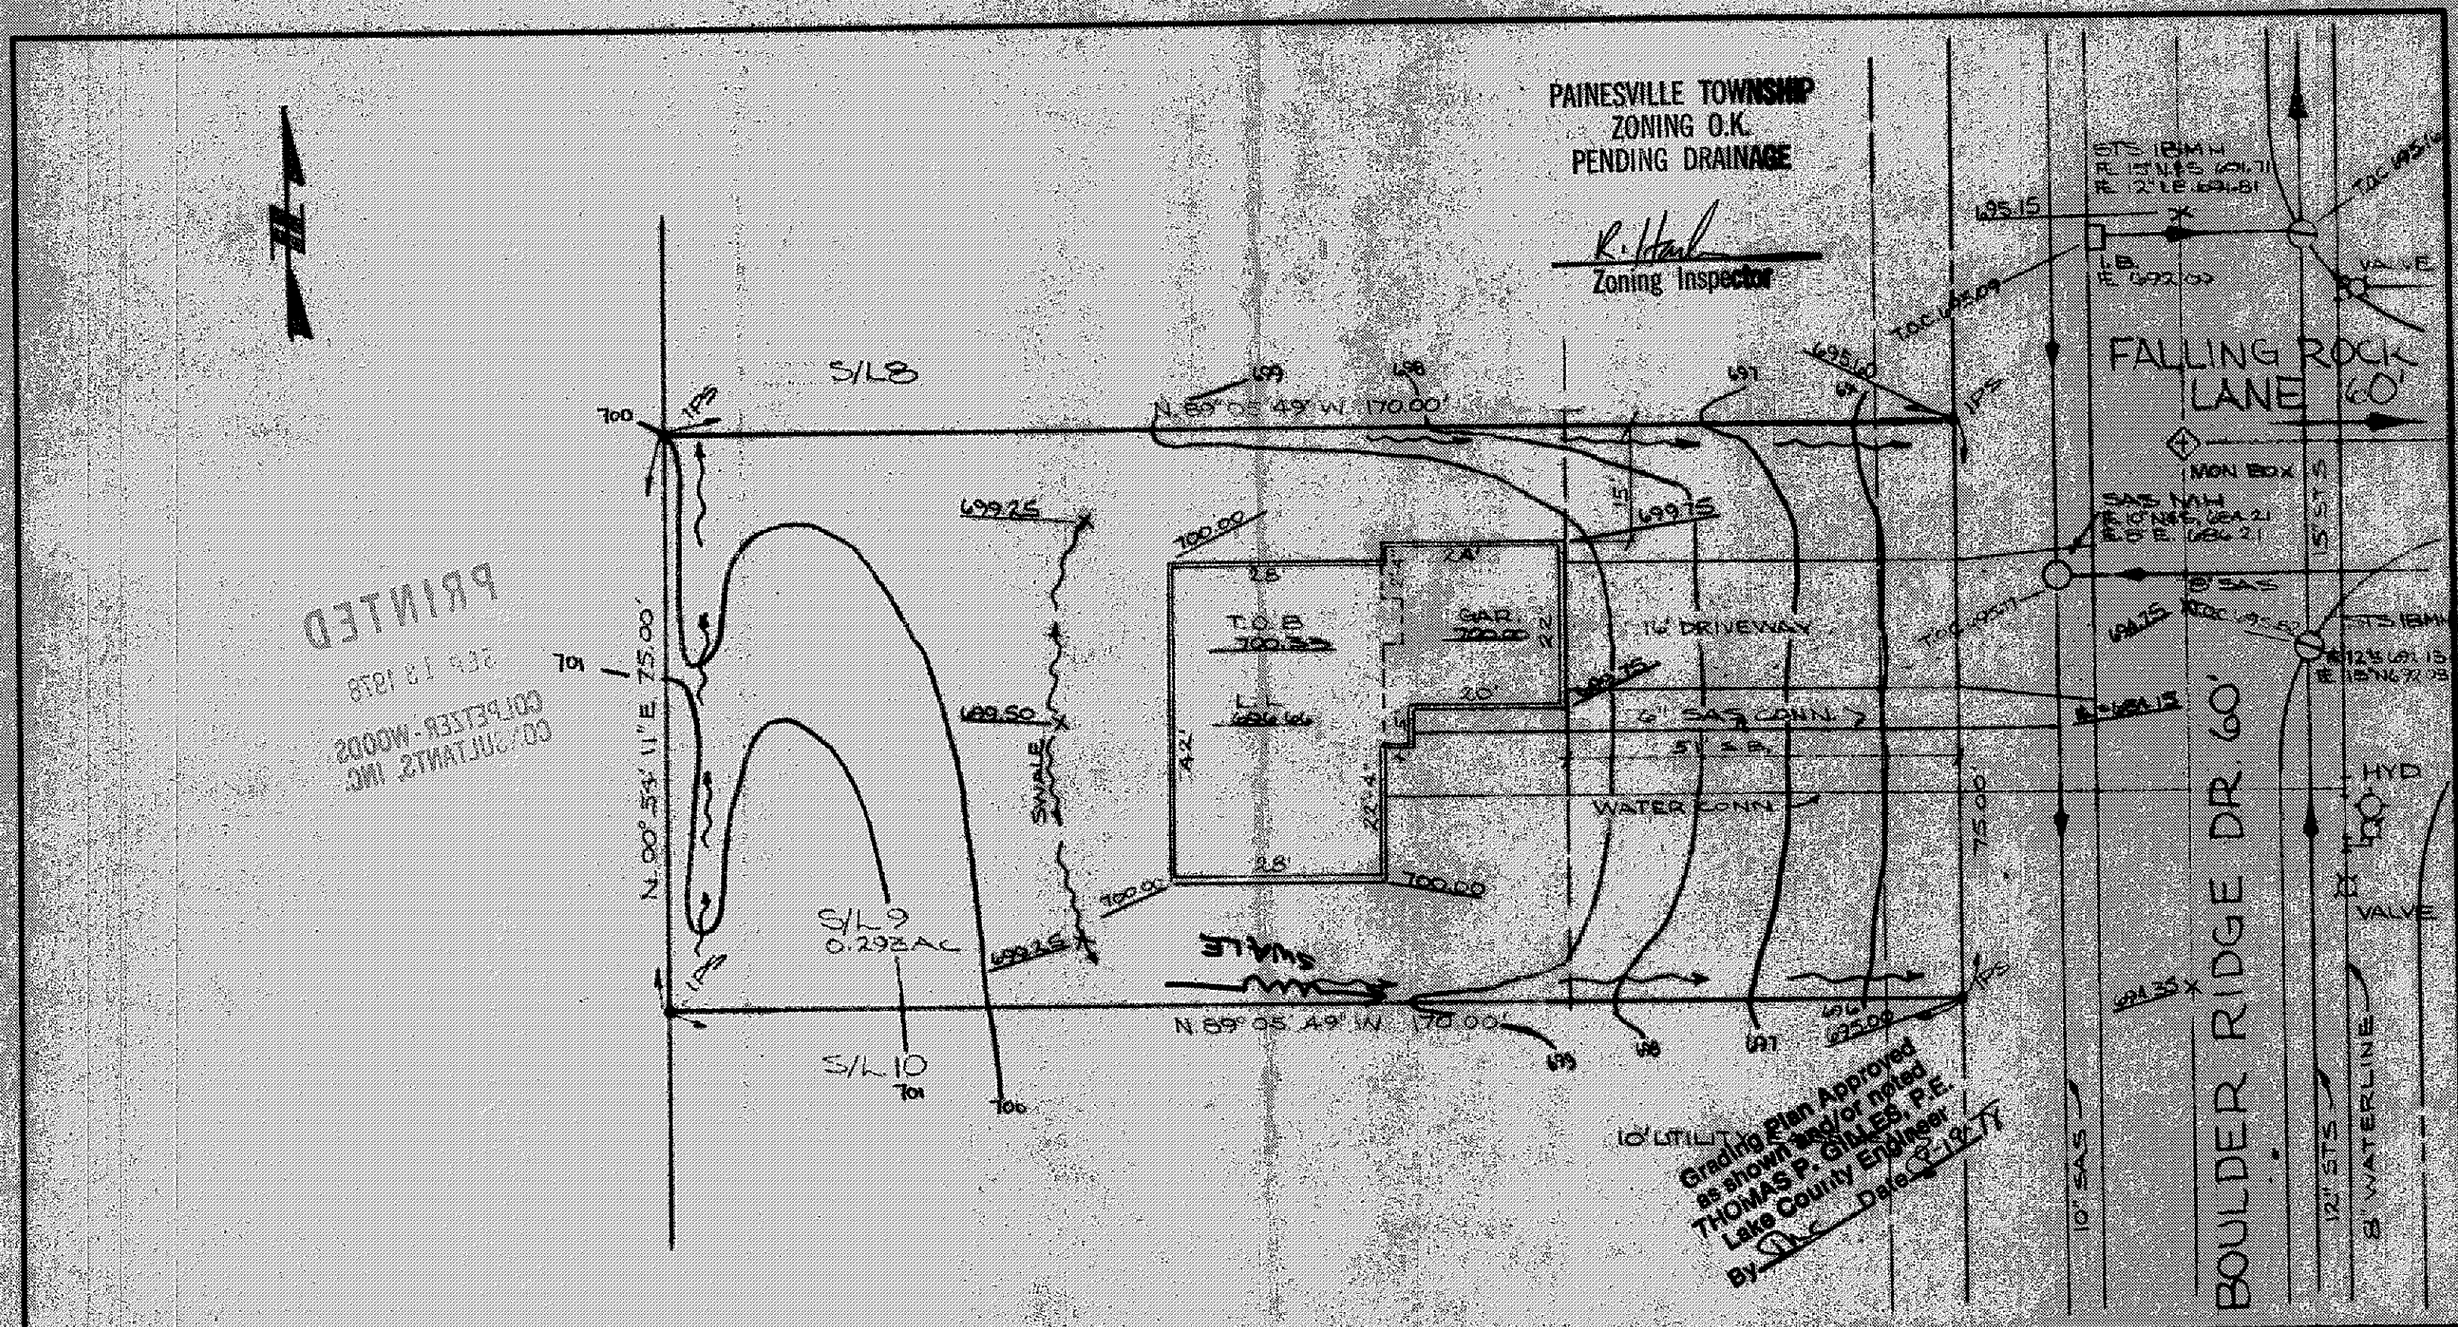

DESIGN CERTIFICATION

THIS PLAT WAS PREPARED BY ME, AND IS CORRECT TO THE BEST OF MY KNOWLEDGE AND BELIEF.

REG. SURVEYOR NO. _____

AS BUILT CERTIFICATION

I HEREBY CERTIFY THAT THE CIRCLED GRADES ARE EXISTING FINISH GRADES CHECKED IN THE FIELD ON _____ AND THAT SURVEY IS CORRECT TO THE BEST OF MY KNOWLEDGE AND BELIEF.

REG. SURVEYOR NO. _____

COLPETZER · WOODS
CONSULTANTS, INC.
(216) 357-7589

DATE 17 AUG 78
SCALE 1" = 20'
DRWN BY KAL
CHKD BY
JOB NO. 78282
FB — PG —

SITE PLAN FOR:

CASEMENT HOMES

1251 MADISON AVE. PAINESVILLE, OHIO
BEING SUBLOT 9 OF BOULDER RIDGE SUBDIVN
PAINESVILLE TWP LAKE COUNTY OHIO