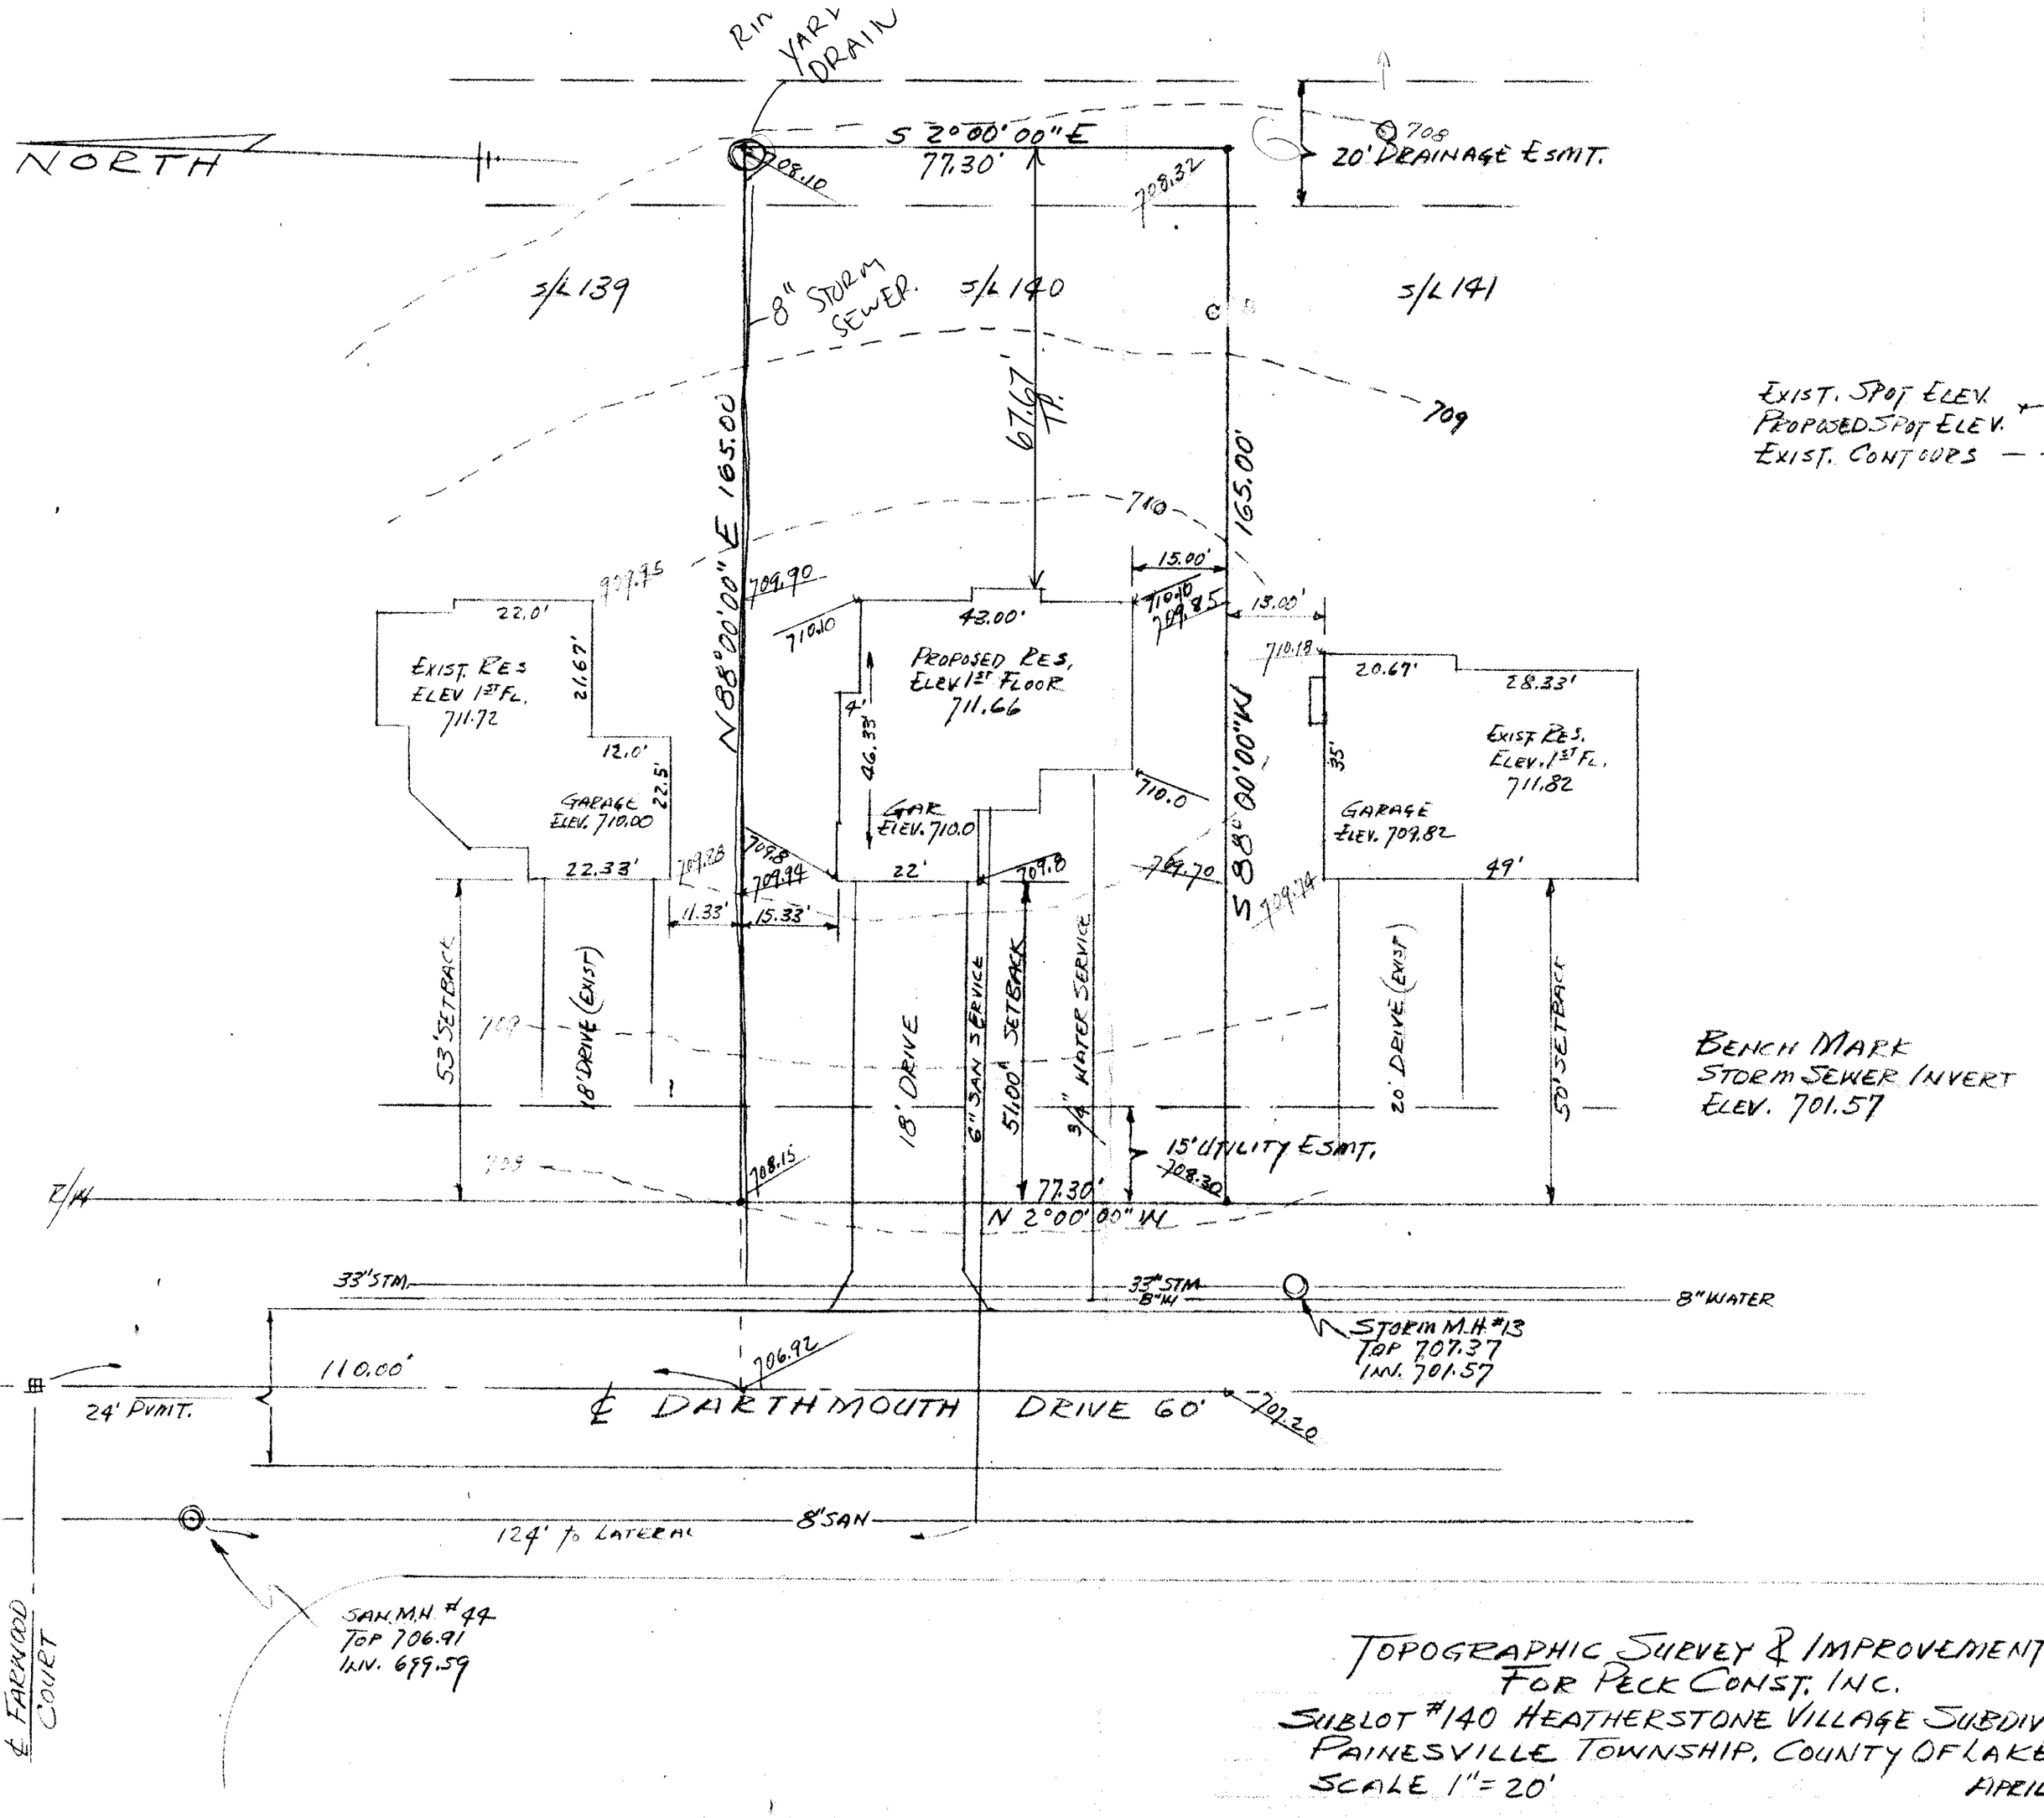

EXIST. SPOT ELEV. 709.50
PROPOSED SPOT ELEV. 710.00
EXIST. CONTOURS ----- 708 ---

BENCH MARK
STORM SEWER INVERT
ELEV. 701.57

TOPOGRAPHIC SURVEY & IMPROVEMENT PLAN
FOR PECK CONST. INC.
SUBLOT #140 HEATHERSTONE VILLAGE SUBDIVISION NO. 1
PAINESVILLE TOWNSHIP, COUNTY OF LAKE, OHIO
SCALE 1" = 20'
APRIL 2 1991

Pat Salango
PAT SALANGO, REG. SURV. No. 4504

STATE OF OHIO
PAT SALANGO
REGISTERED
SURVEYOR

This Permit Expires
4-5-92
PAINESVILLE TOWNSHIP
ZONING APPROVED
7742 DHRust
Zoning Inspector

Grading Plan Approved as shown and/or noted
THOMAS P. CRILLEY
Lake County Engineer
By GJH 4/10/91

INSTALL 8" STORM SEWER AND YARD DRAIN AS SHOWN.