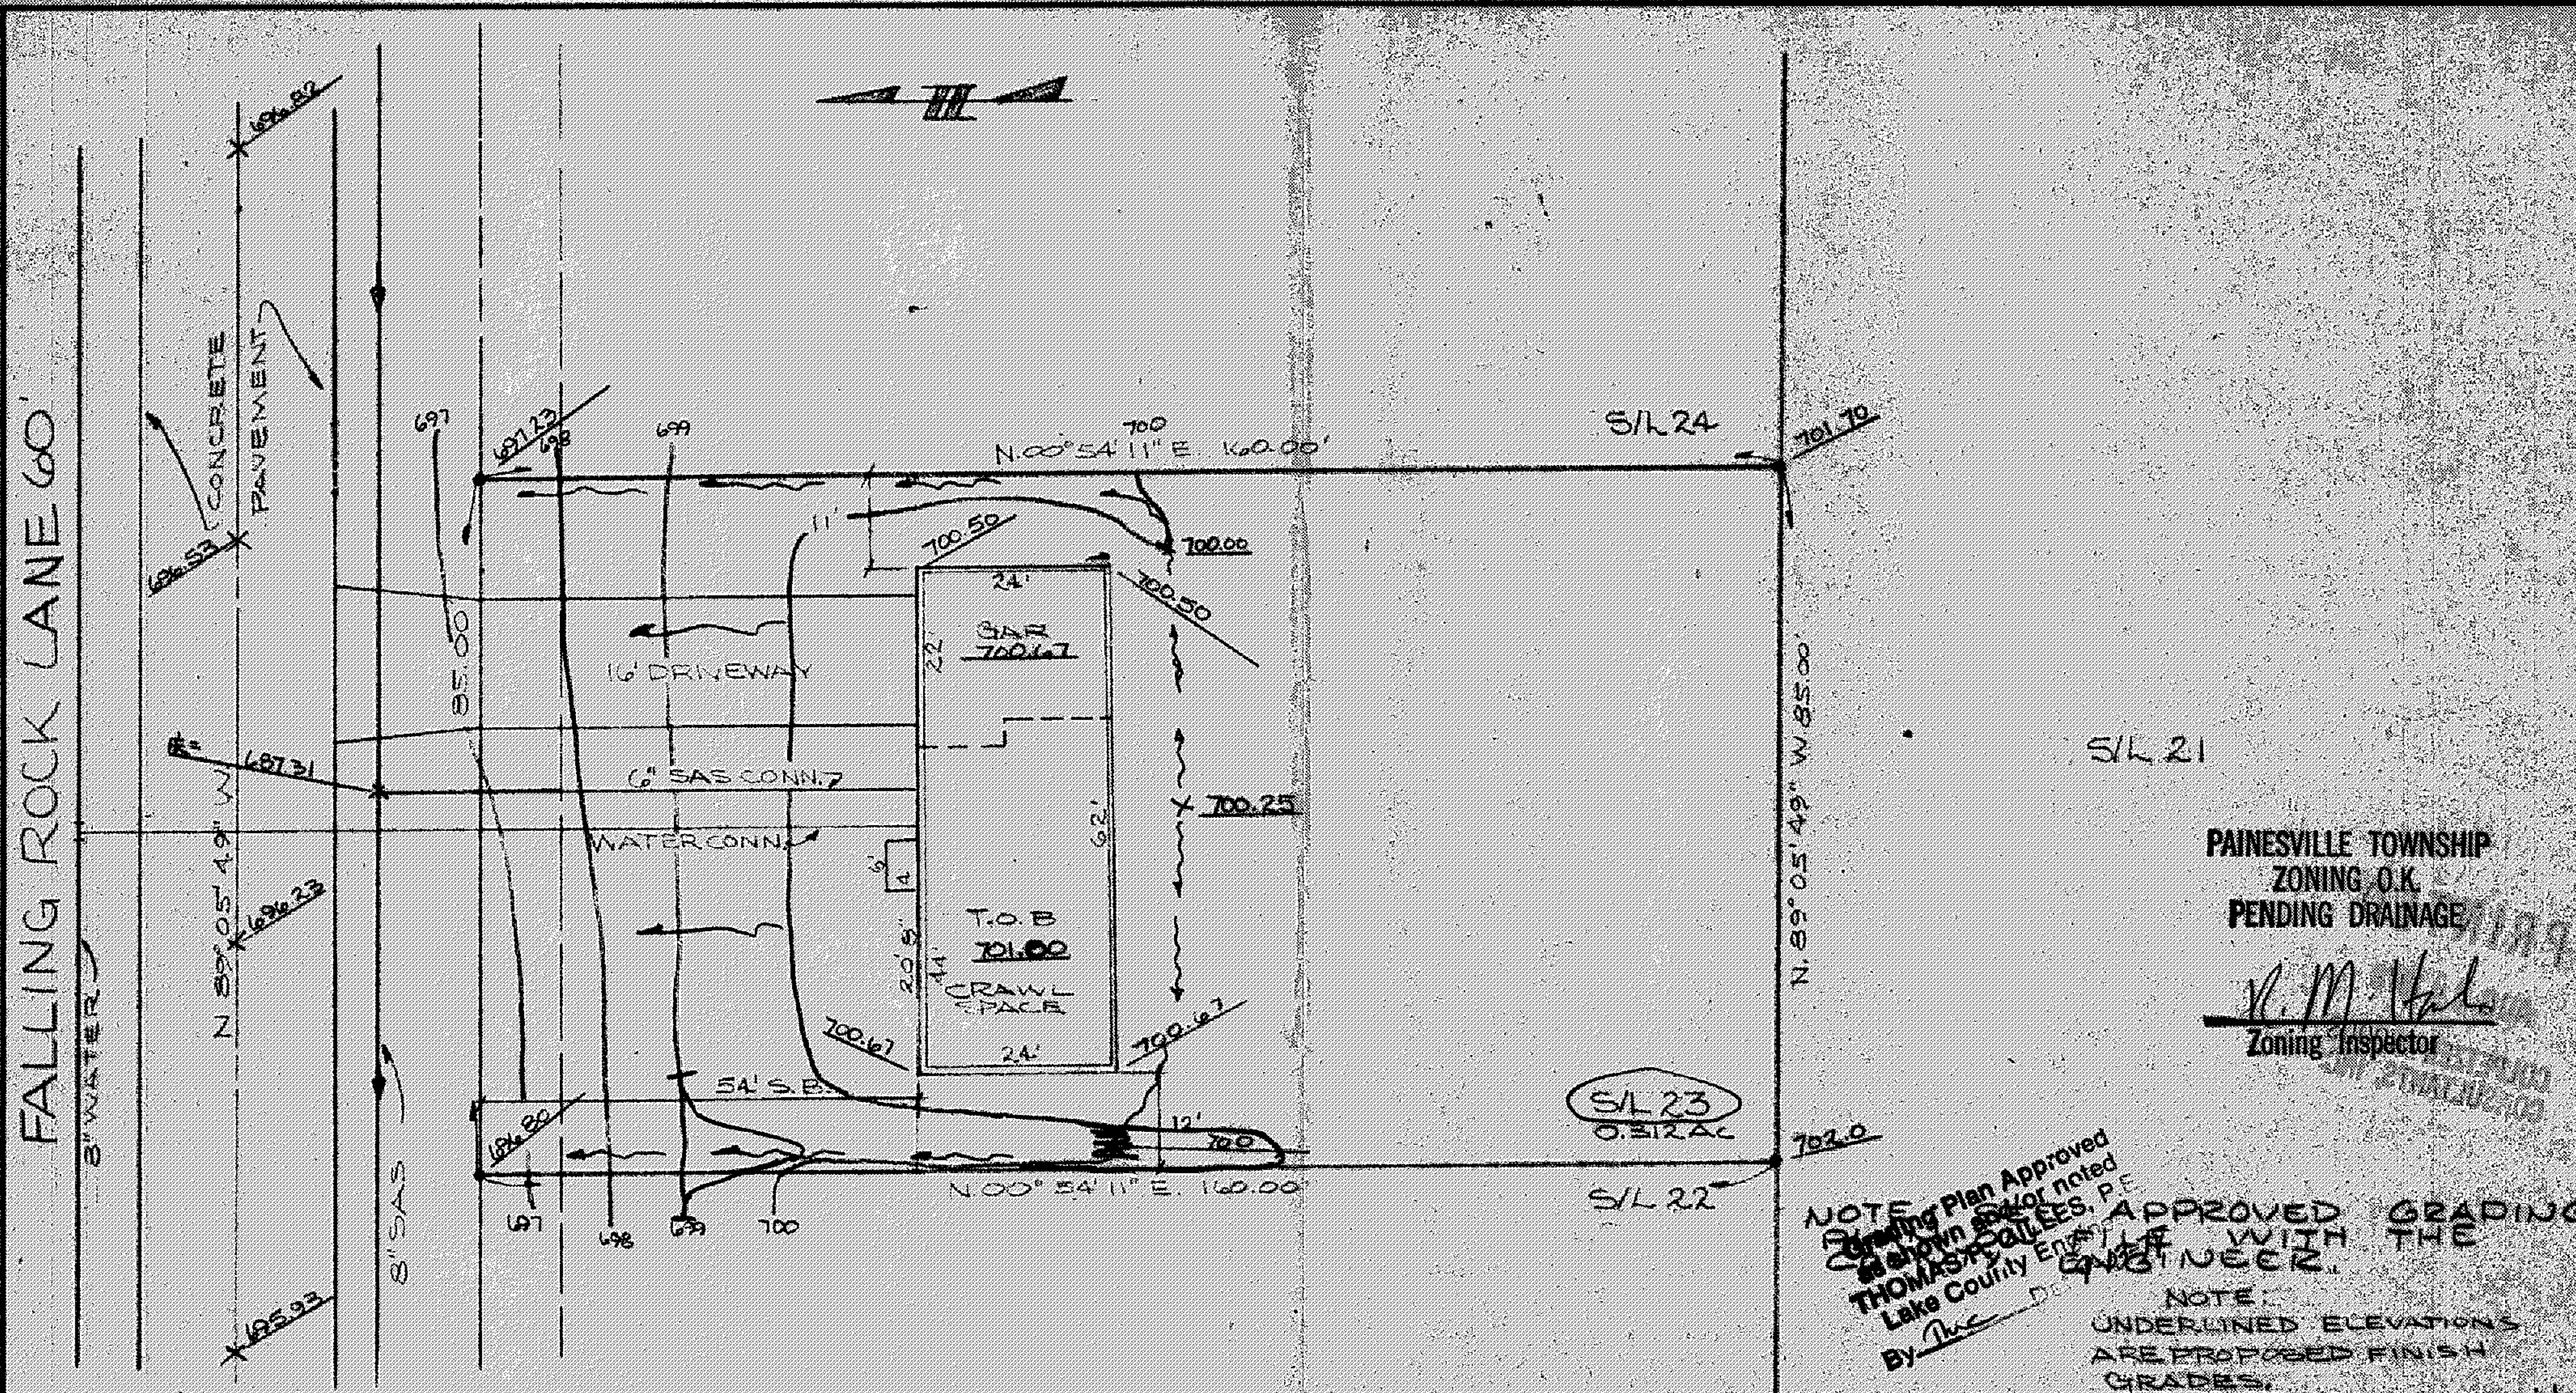

DESIGN CERTIFICATION	AS BUILT CERTIFICATION	COLPETZER · WOODS CONSULTANTS, INC.		GRADING PLAN FOR:
THIS PLAT WAS PREPARED BY ME, AND IS CORRECT TO THE BEST OF MY KNOWLEDGE AND BELIEF.	I HEREBY CERTIFY THAT THE CIRCLED GRADES ARE EXISTING FINISH GRADES CHECKED IN THE FIELD ON ______ AND THAT SURVEY IS CORRECT TO THE BEST OF MY KNOWLEDGE AND BELIEF.	(216) 357-7569	DATE 17 AUG 78 SCALE 1"=20' DRWN BY KAL CHKD BY ______ JOB NO. 78282 FB. — PG. —	CASEMENT HOMES 1251 MADISON AVE. PAINESVILLE, OHIO BEING S/L 23, BOULDER RIDGE SUBDIVISION PAINESVILLE TWP. LAKE COUNTY, OHIO
REG. SURVEYOR NO. 4785	REG. SURVEYOR NO. ______			