**PREPARED BY:**
Wilson and Associates
Registered Surveyors
11005 Wilson Mills Road
Chardon, Ohio 44024
Date: Sept. 10, 1974
Scale: 1" = 30'

# SITE PLAN

## FOXFIRE TRAILS SUBDIVISION

SUBLOT NO. 15

VOLUME S PAGE 7

## PAINESVILLE TOWNSHIP

LAKE COUNTY OHIO

for

CASEMENT HOMES
1251 MADISON AVE.
PAINESVILLE, OHIO

**CERTIFICATION:**
I certify that this plat was prepared by me, and is correct to the best of my knowledge.
By: Lawrence Wilson
Lawrence Wilson, Reg. Surveyor No. 5807

**"AS BUILT" CERTIFICATION:**
I certify that on ______________ 1974, the finished grades were checked in the field, shown encircled, and are correct to the best of my knowledge.
By: ______________
Lawrence Wilson, Reg. Surveyor No. 5807

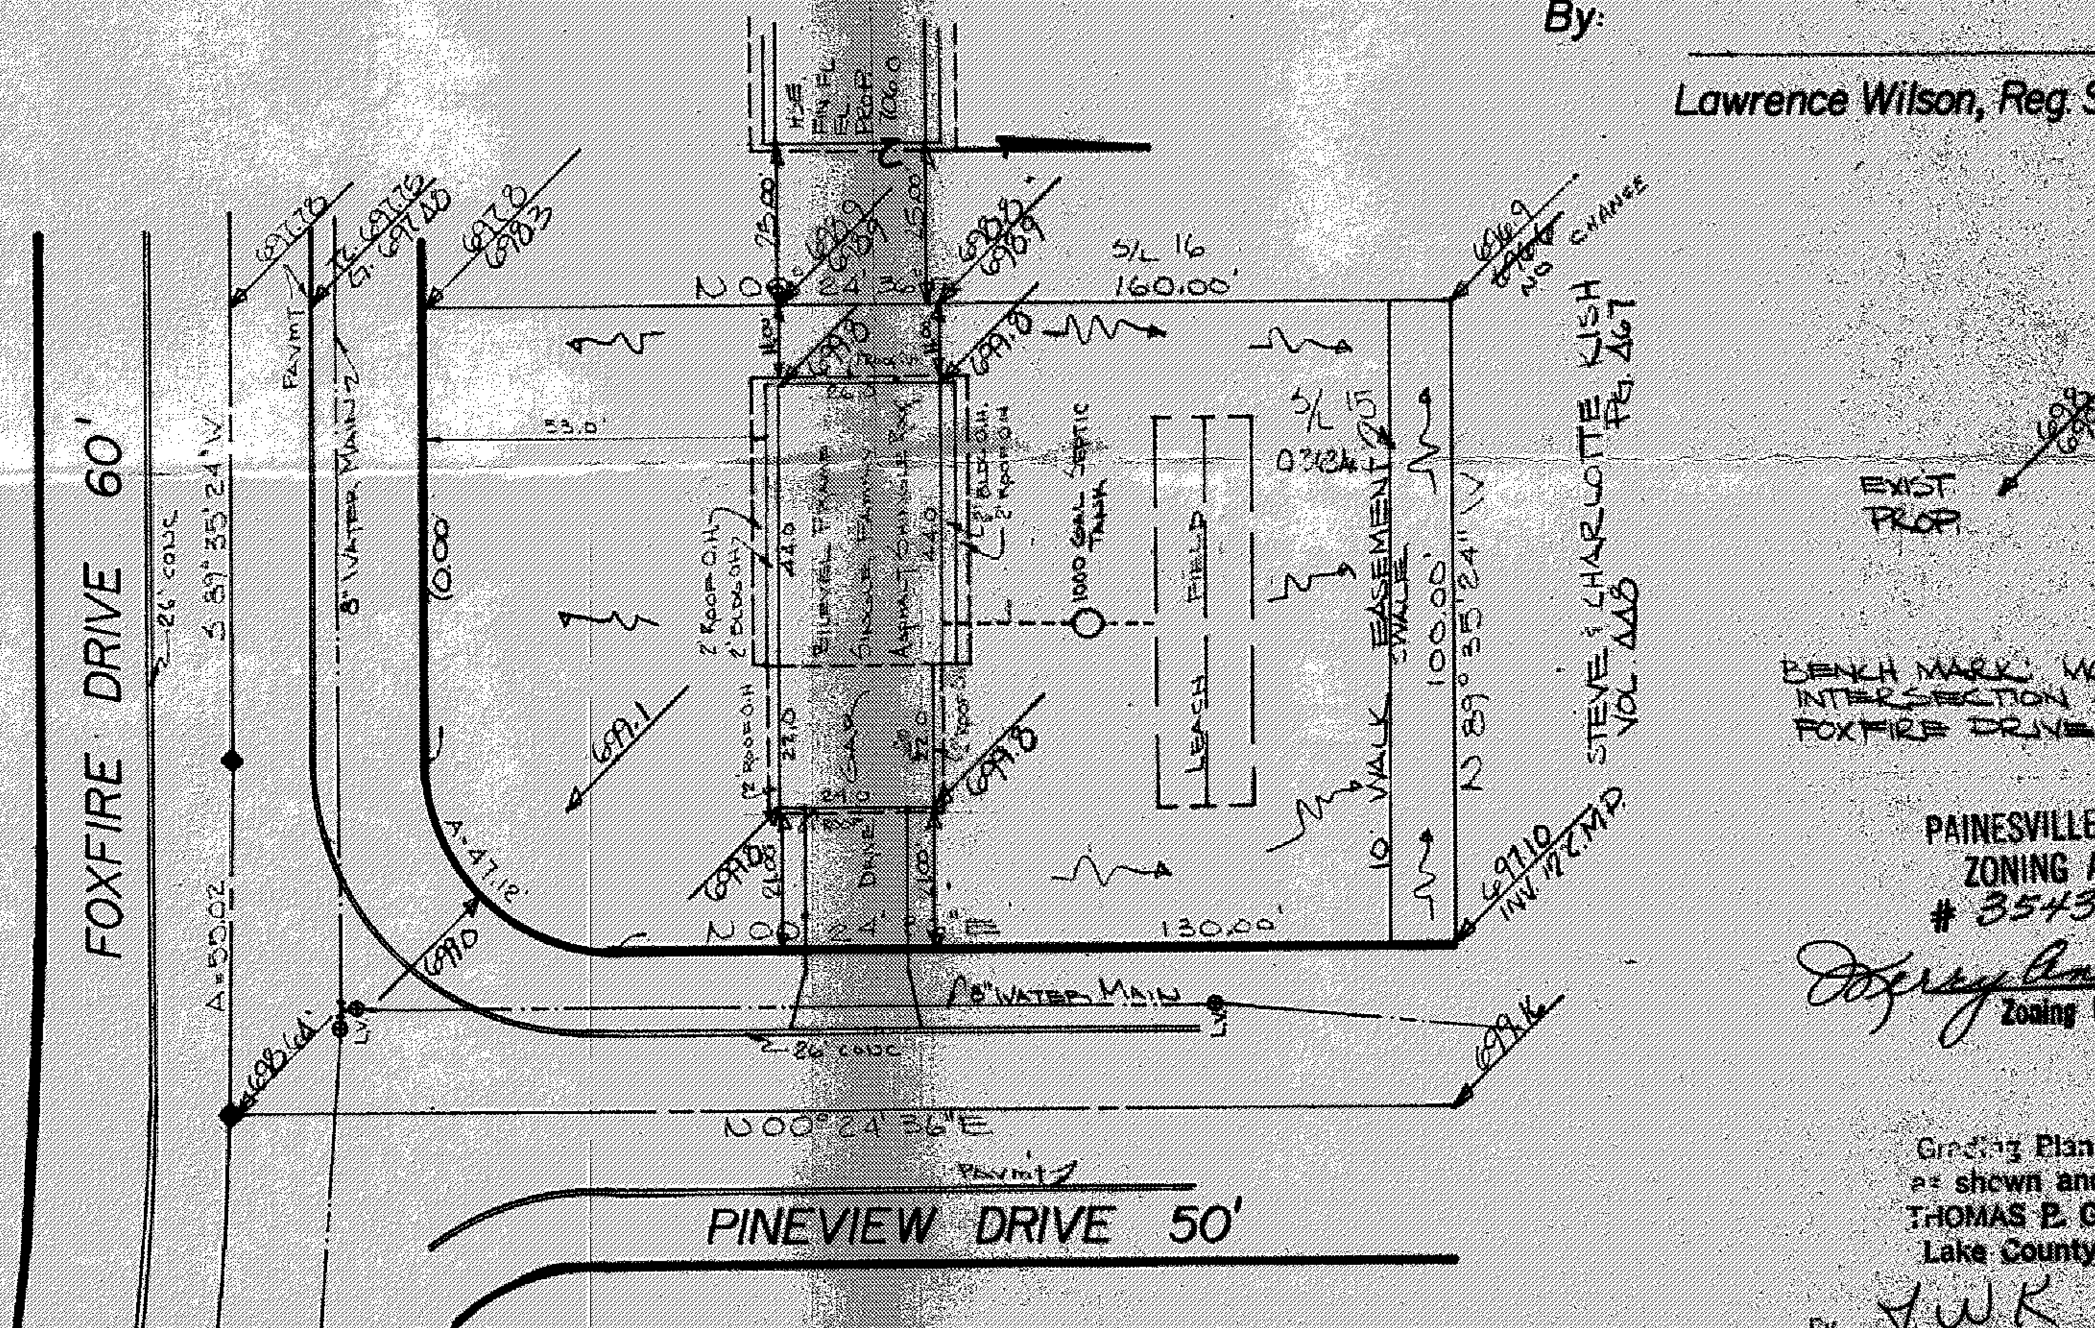


BENCH MARK: MON BOX RIM AT INTERSECTION OF PINEVIEW & FOXFIRE DRIVE. EL. 698.6A'

PAINESVILLE TOWNSHIP
ZONING APPROVED
# 3543 9-12-74
Zoning Inspector

Grading Plan Approved
as shown and/or noted
THOMAS P. GILLES, P.E.
Lake County Engineer
By JWK Date 9-12-74