SITE PLAN

for: BOJAN KNEZ

ADDRESS | STREET | CITY

8 — SUBLOT No. | MISTY MEADOWS — SUBDIVISION NAME | 16-21 — VOL. PAGE

PAINESVILLE — TOWNSHIP | TRACT-LOT | CITY

Lake Inc.
Engineers & Surveyors
30601 EUCLID AVE. – WICKLIFFE – OHIO 585-2700

CHECK LIST

- LOT DIMENSIONS & BEARINGS
- TIE TO NEAREST STREET
- SUBLOT No. (PARCEL No.)
- SURROUNDING OWNERS
- BUILDING DIMENSIONS
- SETBACK, SIDEYARD, REARYARD
- FINISHED GRADES
- DRIVE & APRON TYPE, WIDTH, THICKNESS
- SIDEWALK TYPE, WIDTH, THICKNESS
- CULVERT TYPE, DIAM., LENGTH
- WATER MAIN SIZE, LOCATION
- SAN. SEWER SIZE, % GRADE, LOCATION
- SAN. M.H. CAST. ELEV., INV. ELEV.
- SAN. CONN. SIZE, % GRADE, LOCATION
- STORM SEWER SIZE, % GRADE, LOCATION
- STORM M.H. CAST. ELEV., INV. ELEV.
- PAV'T. TYPE, GRADE, CURBS
- GAS LINE LOC., SIZE
- SEPTIC SYSTEM & DUPLICATION
- WELL LOCATION & ISOLATION RADIUS

STATE SEAL

DESIGN CERTIFICATION

THIS PLAT WAS PREPARED BY ME, AND IS CORRECT TO THE BEST OF MY KNOWLEDGE AND BELIEF.

NAME

"AS-BUILT" CERTIFICATION

I HEREBY CERTIFY THAT THE CIRCLED INFORMATION IS EXISTING AS OBTAINED ON THE SITE 19 AND IS CORRECT TO THE BEST OF MY KNOWLEDGE AND BELIEF.

NAME

LEGEND

- STORM MANHOLE ●
- SANITARY MANHOLE ◪
- EXISTING CONTOURS ------
- PROPOSED CONTOURS ——
- EXIST. ELEV. 100.0
- 100.0 PROP. ELEV.
- DIRECTION OF SURFACE DRAINAGE →

DRAWN BY	SCALE
BRS	1"=20'
CHK'D BY	DATE
	JUNE, 1992

JOB No. 92-102

SCALE: 1"=20'

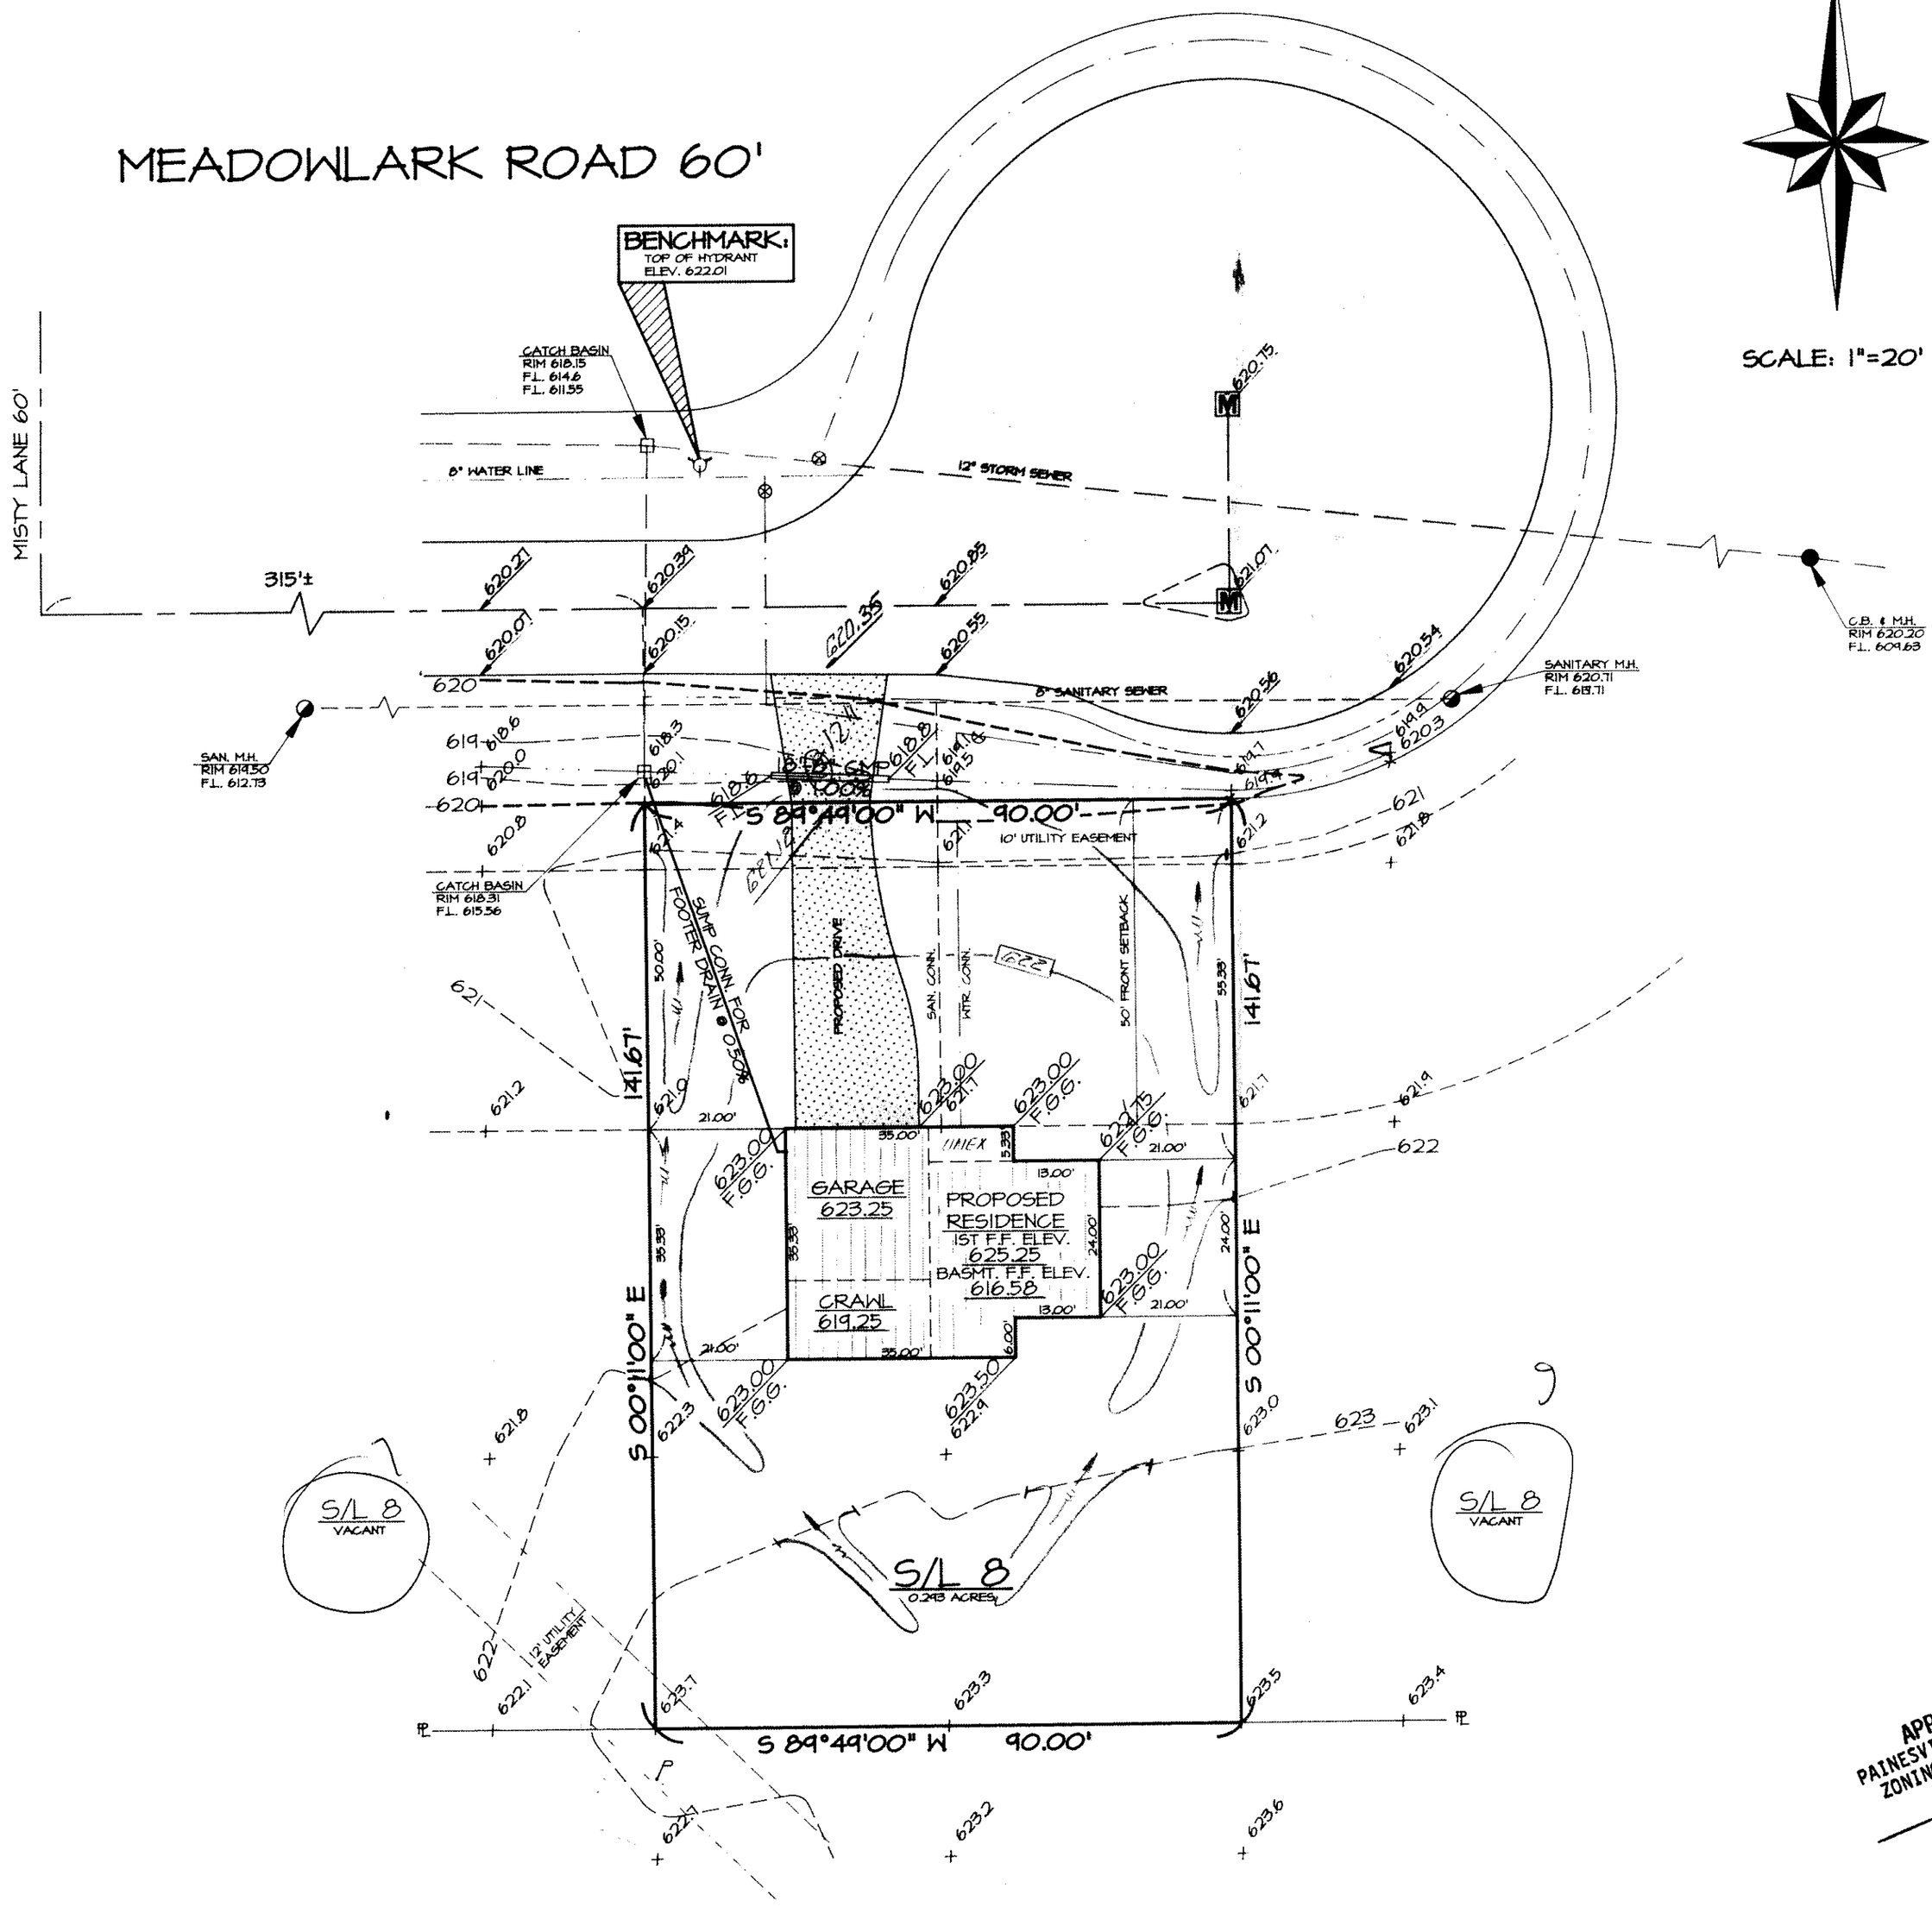

BENCHMARK:
TOP OF HYDRANT
ELEV. 622.01

Grading Plan Approved
as shown and/or noted
THOMAS P. GILL[illegible] P.
Lake County Engineer
By GJH Date 6/10/92
- MINIMUM 12" DRIVE CULVERT
- DOWN SPOUTS SHALL BE SPLASH BLOCKED

CONTRACTOR TO VERIFY:
1. FIN. FLR. ELEVATIONS & HSE. SIZES.
2. LOCATION & ELEVATIONS OF EXIST. UTILITY CONNECTIONS.
"BEFORE STARTING CONSTRUCTION"

APPROVED
PAINESVILLE TOWNSHIP
ZONING DEPARTMENT

PRINTED
JUN 4 1992
LAKE INC.

92-102