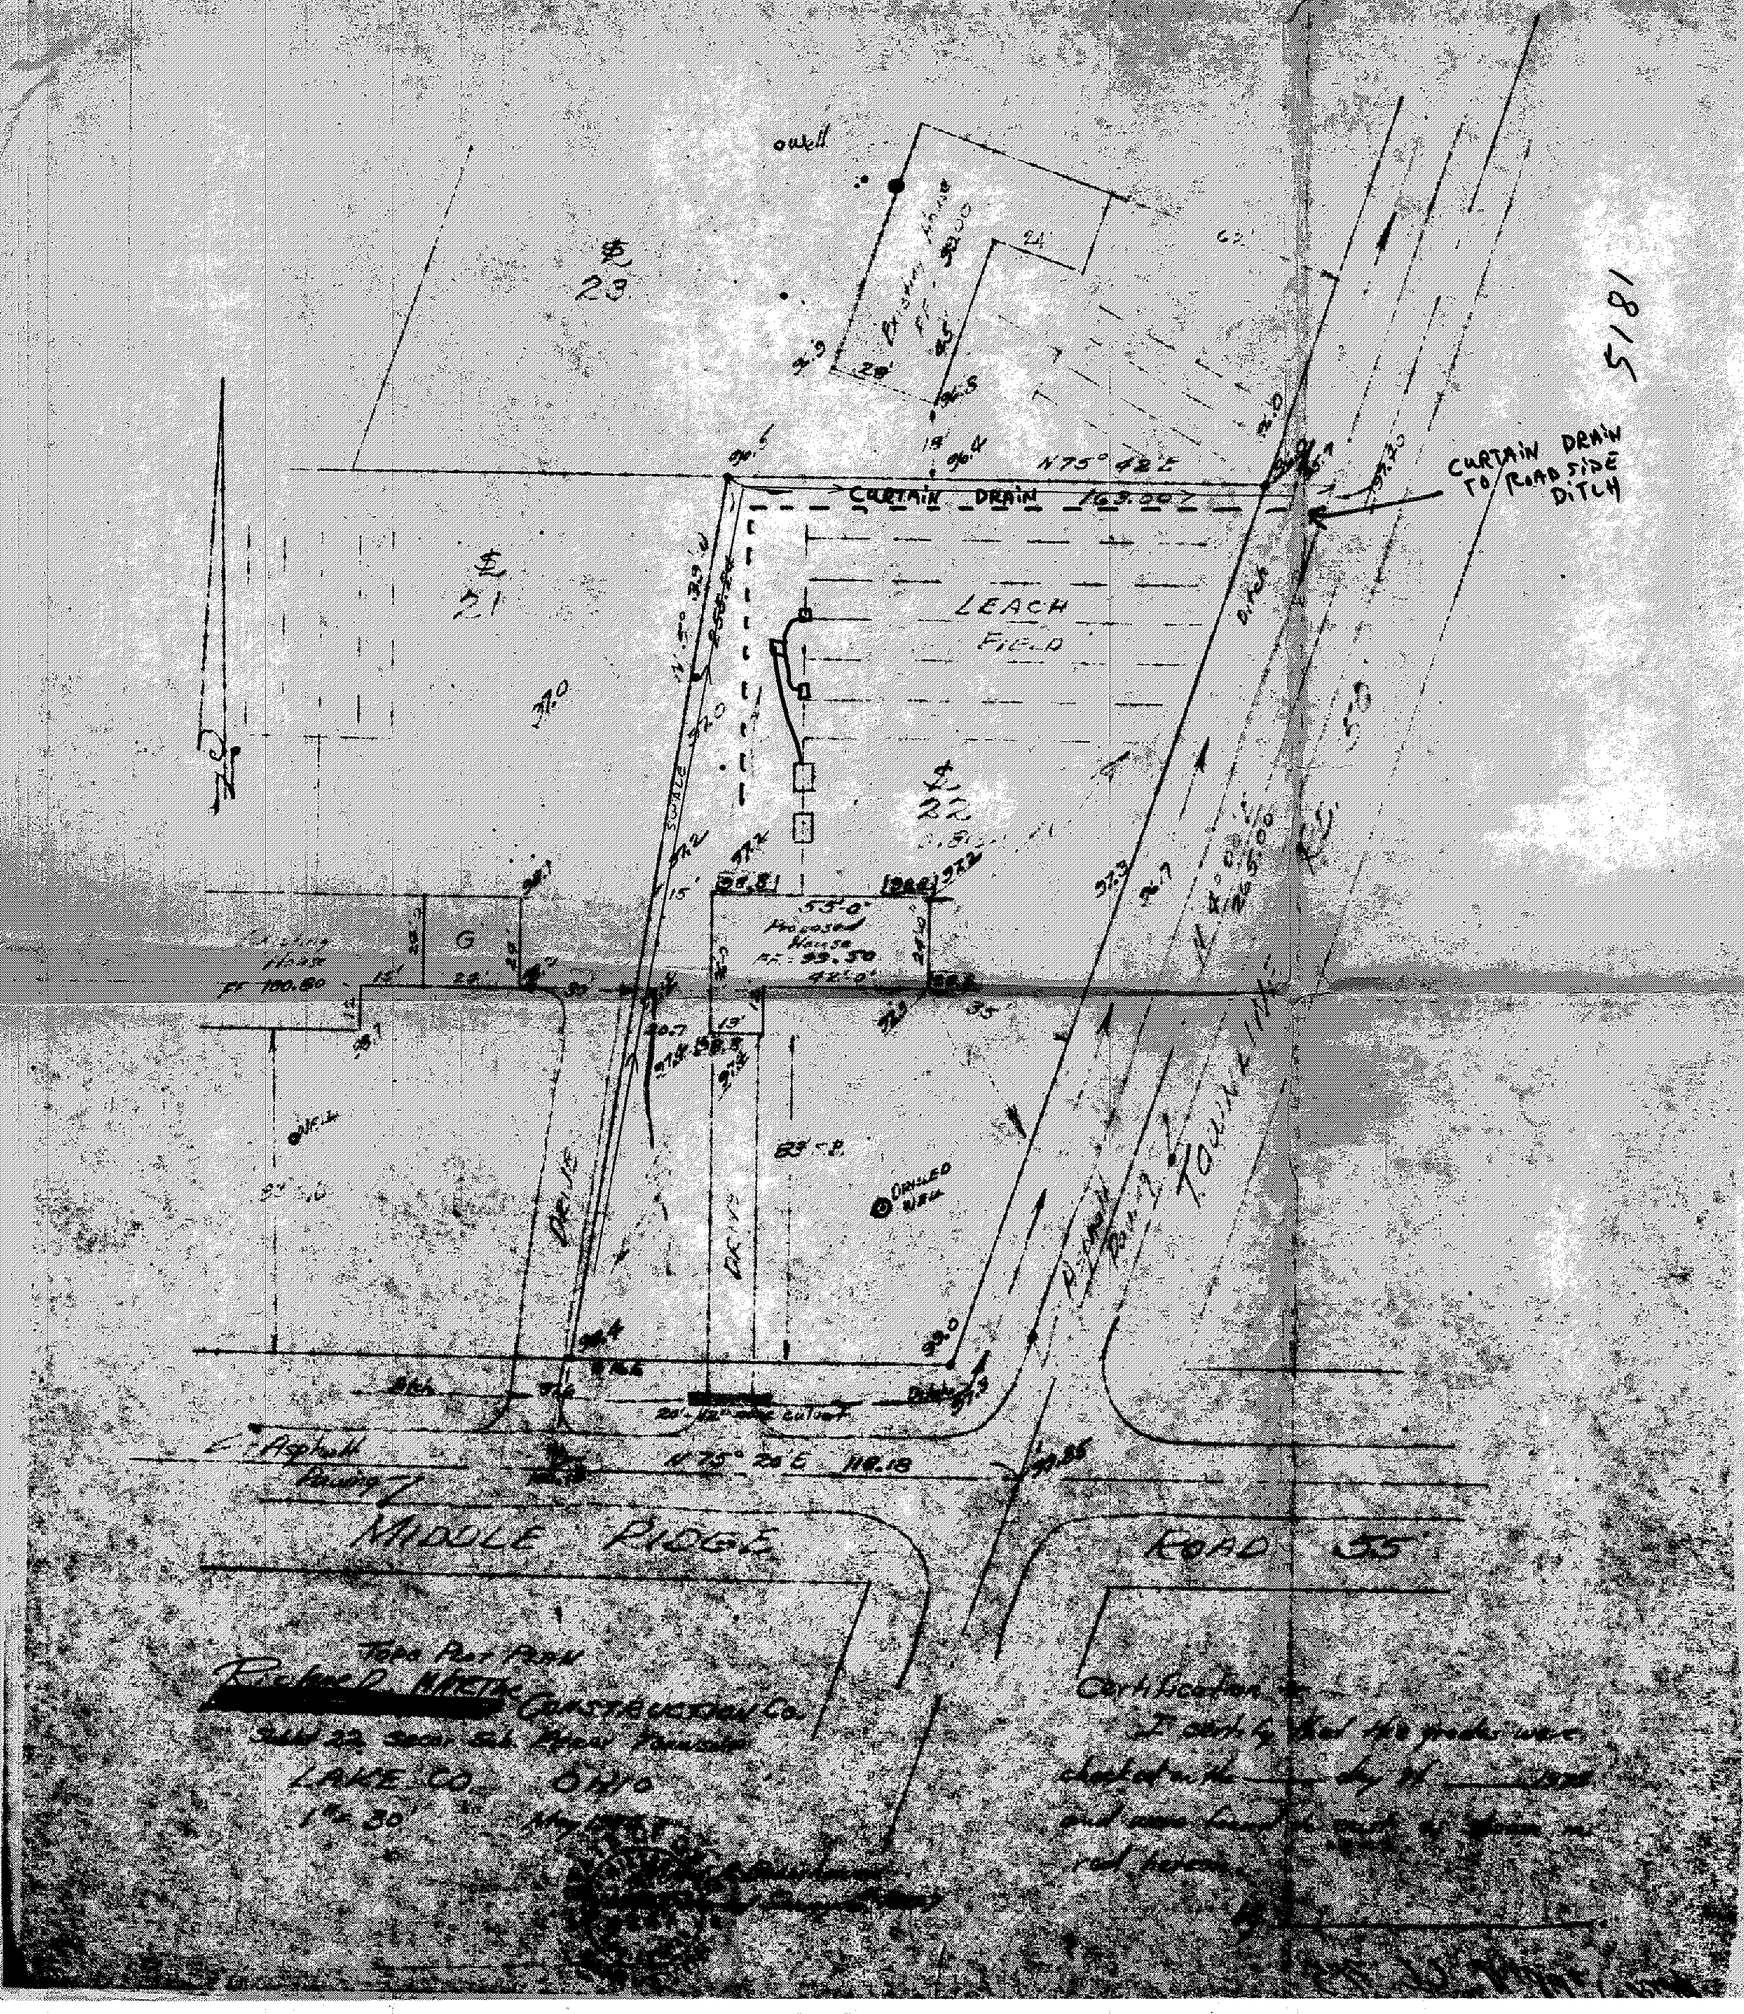

APPROVED
SIDE LINES & SET BACK
PERRY TOWNSHIP ZONING
PERMIT NO. _____
ZONING INSPECTOR
R.W. Rittenhouse

Grading Plan Approved
as shown and/or noted
THOMAS P. GILLES, P.E.
Lake County Engineer
By J W K Date 6-6-74

Certification —
I certify that the grade was
checked on the ____ day of ____
and was found ____ as shown on
said form.