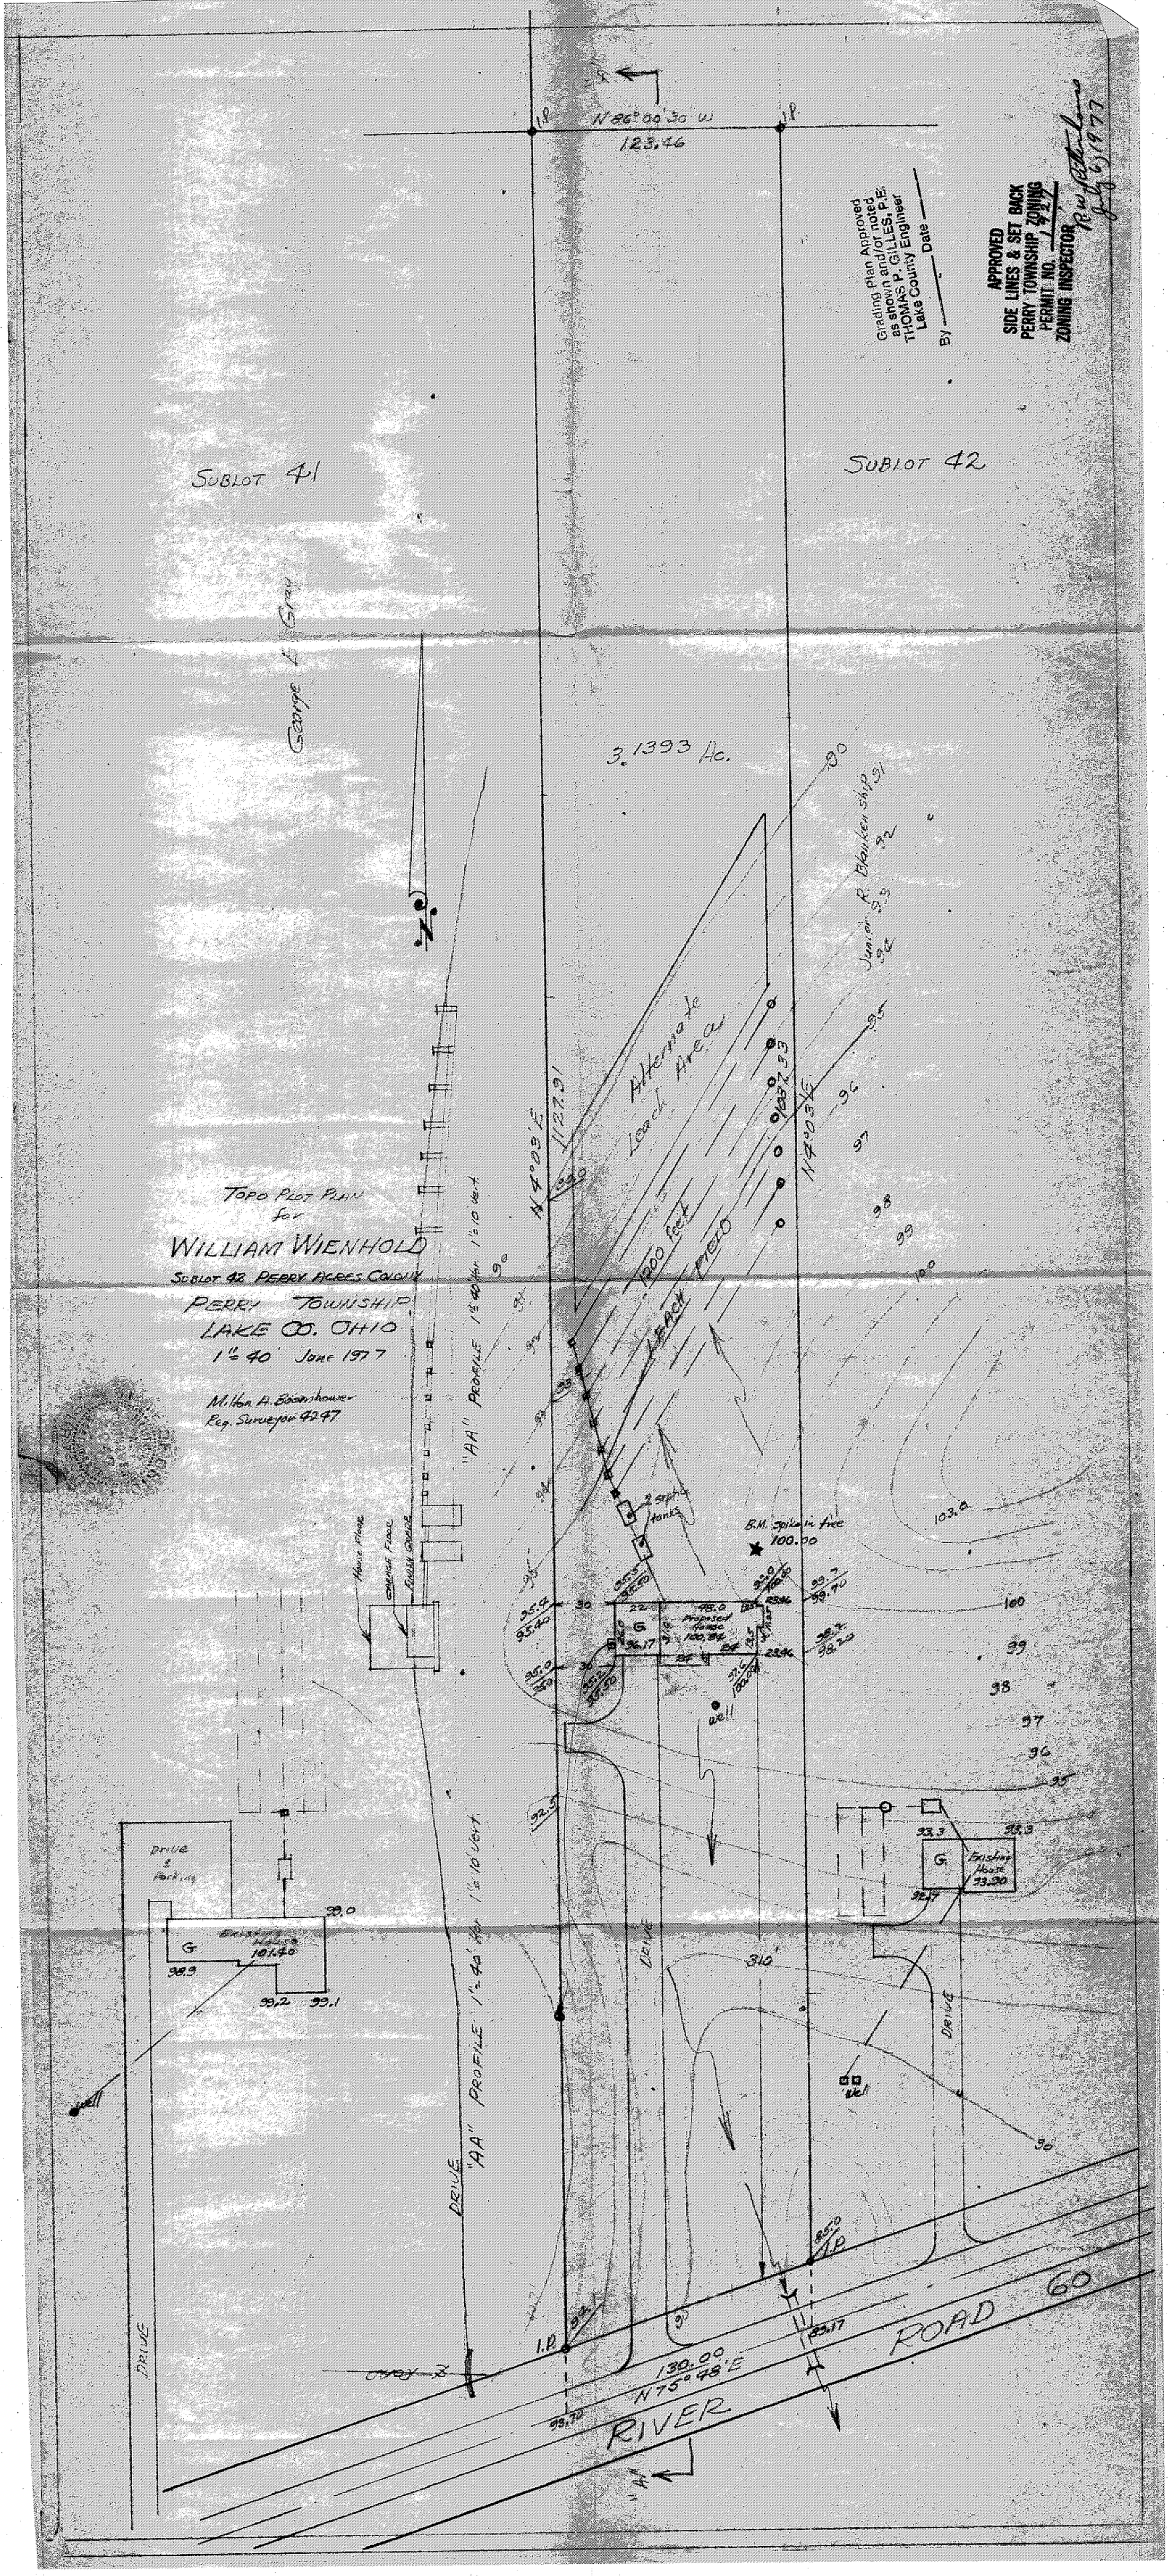

N 86°00'30" W
123.46
Grading Plan Approved as shown and/or noted
THOMAS P. GILLES, P.E.
Lake County Engineer
By _____ Date _____
APPROVED
SIDE LINES & SET BACK
PERRY TOWNSHIP ZONING
PERMIT NO. 1727
ZONING INSPECTOR
SUBLOT 41
SUBLOT 42
George L. Gray
3.1393 Ac.
Junior R. Blankenship
Alternate Leach Area
1200 feet
LEACH FIELD
N 4°03'E
1127.91
1087.33
N 4°03'E
TOPO PLOT PLAN for
WILLIAM WIENHOLD
SUBLOT 42 PERRY ACRES COLONY
PERRY TOWNSHIP
LAKE CO. OHIO
1" = 40' June 1977
Milton A. Boomhower
Reg. Surveyor 4247
"AA" PROFILE 1" = 40' Hor. 1" = 10' Vert.
House Floor
Garage Floor
Finish Grade
2 septic tanks
B.M. Spike in tree 100.00
Proposed House 100.84
Well
Drive & Parking
Existing House 101.40
Existing House 93.30
DRIVE
"AA" PROFILE 1" = 40' Hor. 1" = 10' Vert.
DRIVE
DRIVE
DRIVE
Well
Well
130.00
N 75°48'E
RIVER ROAD 60