

HOPKINS

ROAD

JACKSON

ST

195.07 N. 12° 49' W.

168.8

202.8

N 66° 18' E

165.63


246.3

49.7

208.23

49.6

N 0° 17' W

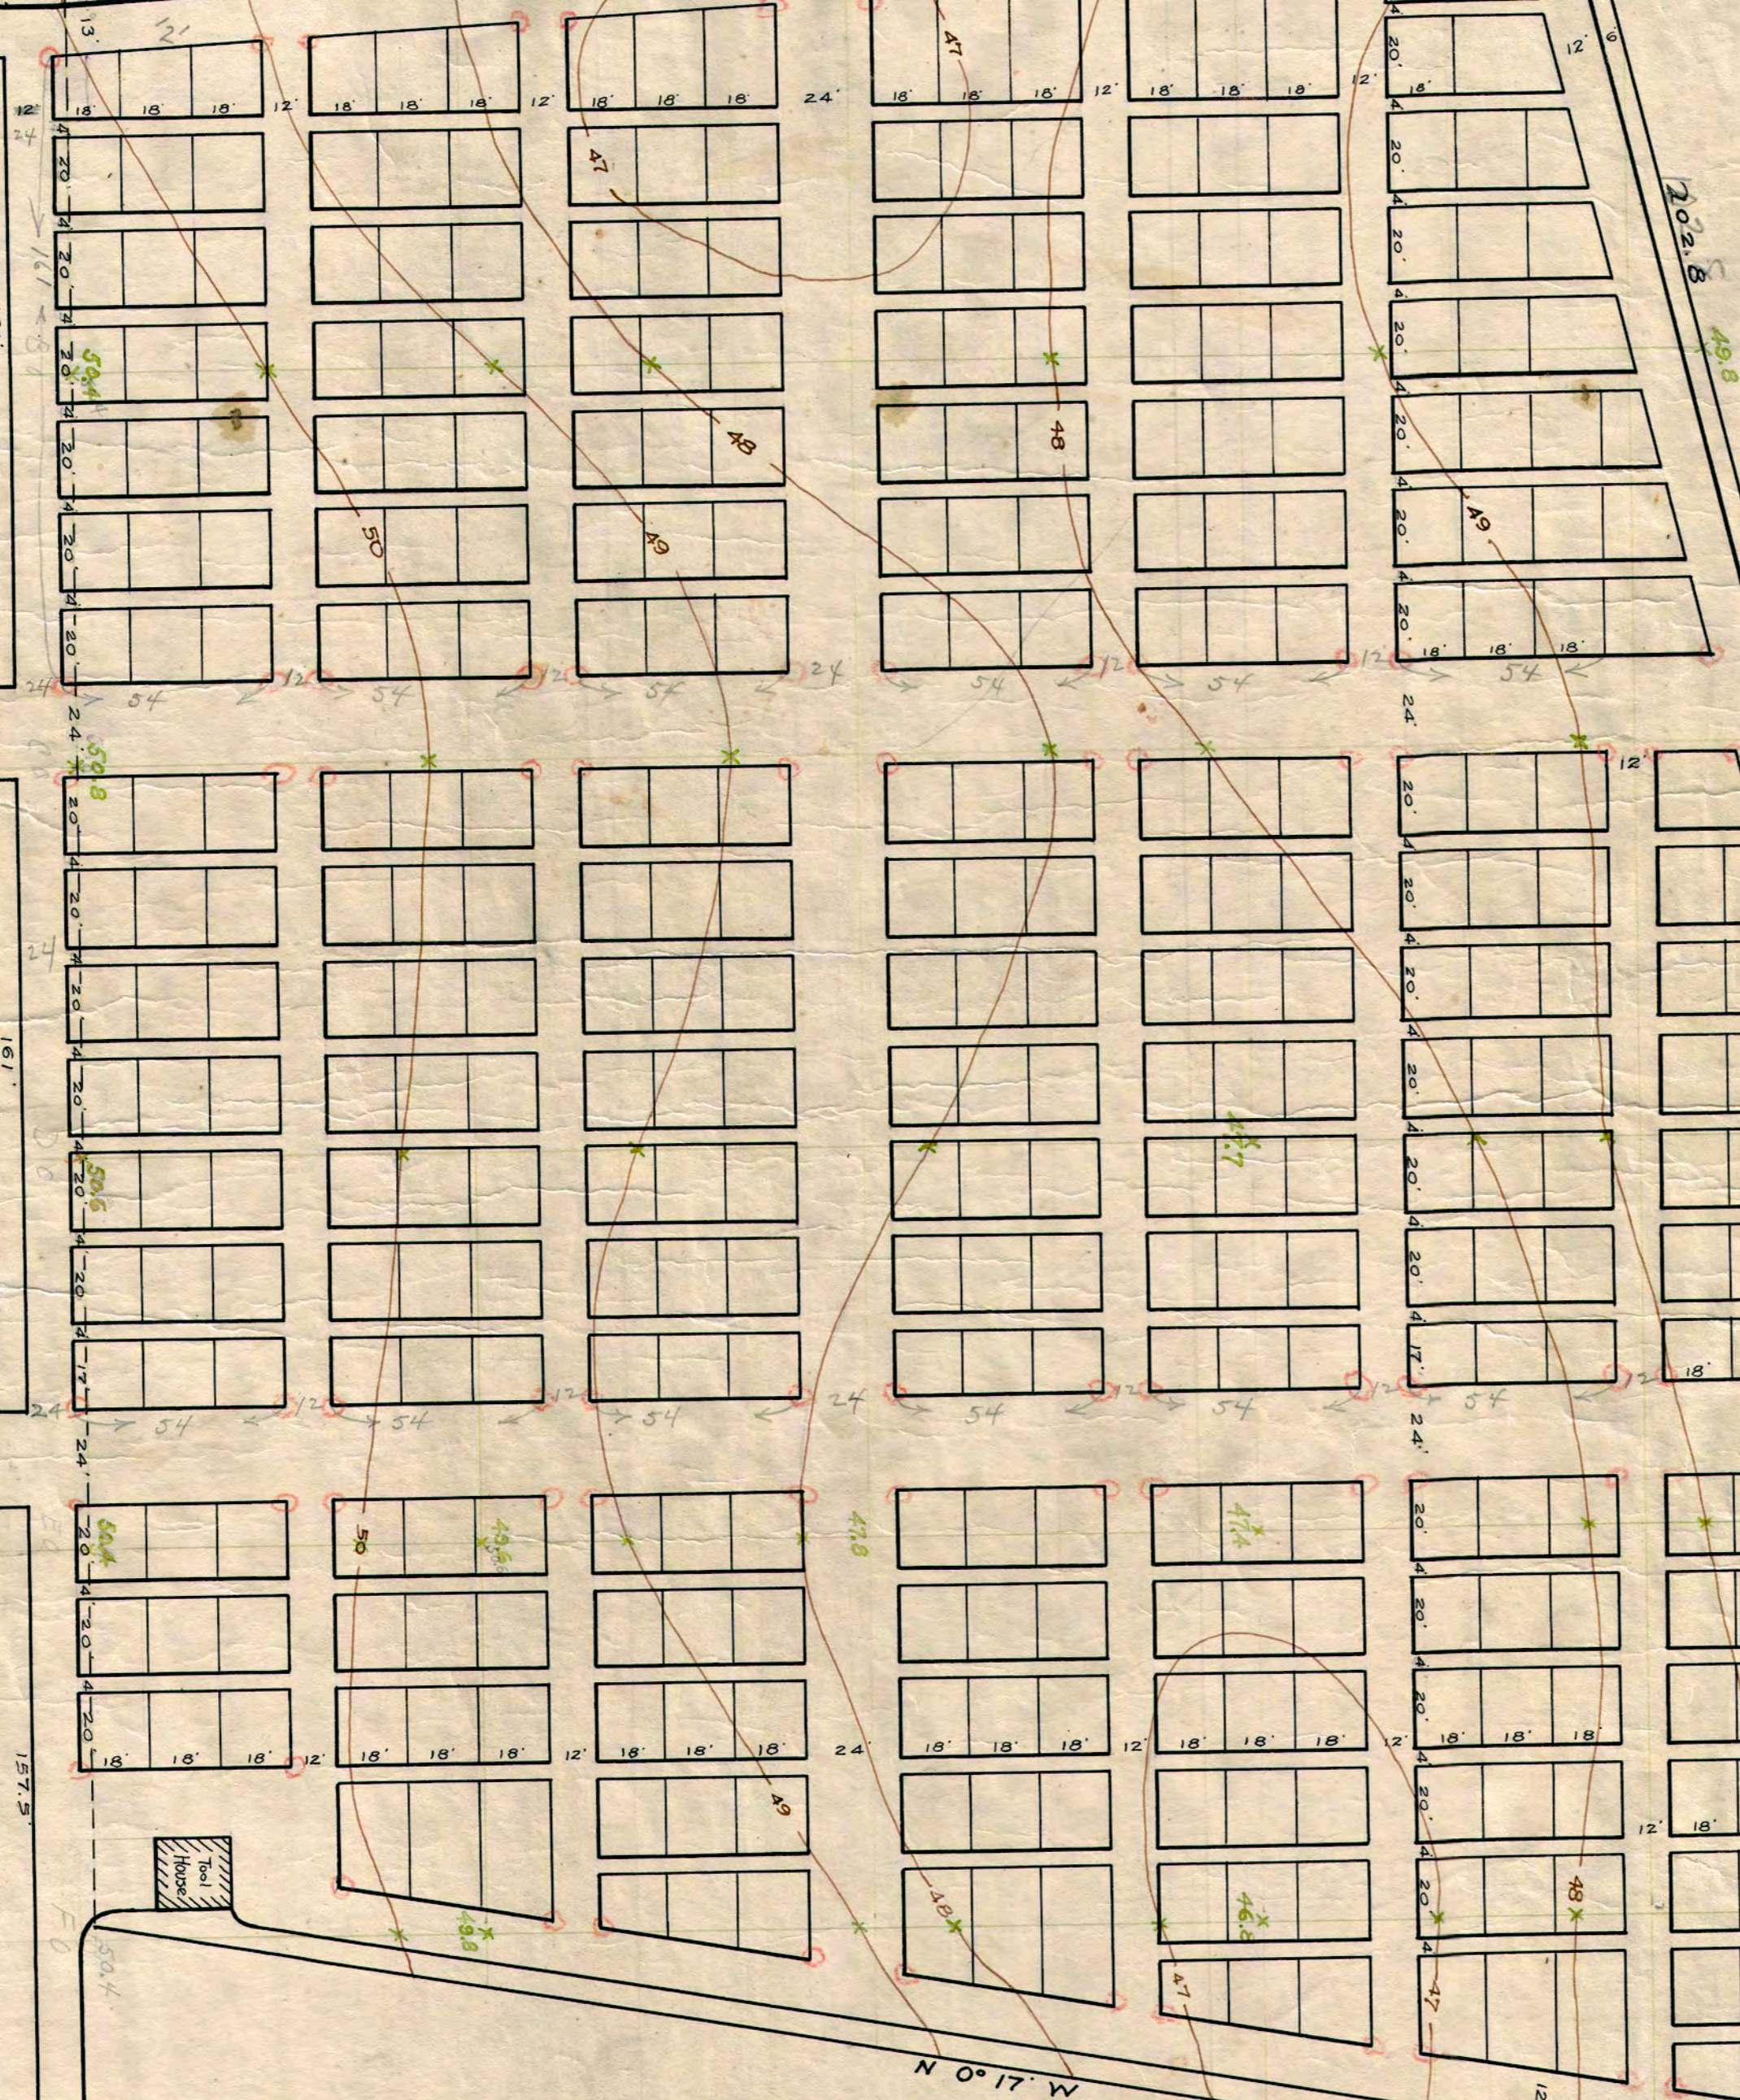

All data for grading at all corners
 hauled with grade cases or
 elevators shown in green
 50 stakes required

Note: Grading = 1500 @ 1.25 = 257.1500 =

Scale 1" = 40'