DELETE: ① THRU ⑥, ⑰, ⑳ THRU ㉙, ㉛, ㉜, ㉞

NORTH PERRY VILLAGE

LOT 114

C.E.I. PAR. COMB. ON 6-1

PCL. NO.	OWNERS			
1	THE CLEVE ELEC ILL CO 6-2-72 V 765-267			
2	THE CLEVE ELEC ILL CO 6-9-72 V 765-792			
3	THE CLEVE ELEC ILL. CO 2-3-72 V 761-54			
4	THE CLEVE ELEC ILL. CO 3-6-73 V 776-181			
5	~~EVERT ALEKSANDRA B-27-59 V 486-544 V.678-348 V 748-780~~	THE CLEVE ELEC ILL CO. 10-22-74 V 796-947		
6	~~HELMUT + ELMI SCHUSTER 7-13-65 V. 623-333~~	CLEVE ELECTRIC ILLUMINATING Co. V. 787-1167 2-1-74		
7	MARY CORRIGAN DANIELS 7-28-67 V 673-310			
8	MARY CORRIGAN DANIELS 7-28-67 V. 673-312			
9	MARY H CORRIGAN 8-30-54 V 366-86			
10	MARY H CORRIGAN 6-25-49 V 266-180			
11	MARY H CORRIGAN 1-21-48 V 245-121			
12	MARY H CORRIGAN 7-22-50 V. 284-379			
13	THE VILLAGE OF N PERRY 4-7-27			
14	DONALD J + EDITH CHAPMAN 10-16-59 V 489-639			
15	ELSA O SLY 8-3-53 V 342-4			
16	~~MOODY BIBLE INST. 10-26-71 V 757-606~~	OTIS + HELEN GARNER 2-20-74 V. 788-344		
17	THE CLEVE ELEC ILL CO 3-1-71 V 775-1438			
18	LAWRENCE + EDITH C GIBSON 8-3-55 V 390-472			
19	EDWARD C + RUTH HOVLIK 6-6-58 V 456-464			
20	THE CLEVE ELEC ILL. CO. 3-1-71 V. 775-1438			
21	THE CLEVE ELEC ILL CO 3-1-71 V. 775-1438			
22	THE CLEVE ELEC. ILL. CO. 1-17-73 V. 774-849			
23	THE CLEVE ELEC ILL Co. 1-17-73 V. 774-849			
24	THE CLEVE ELEC ILL. CO. 10-30-72 V. 771-1046			
25	THE CLEVE ELEC. ILL CO 1-17-73 V. 774-861			
26	THE CLEVE ELEC ILL CO 1-5-73 V. 774-339			
27	THE CLEVE ELEC ILL CO 11-28-72 V. 772-1128			
28	THE CLEVE ELEC ILL CO. 6-9-72 V 765-742			
29	THE CLEVE ELEC. ILL CO. 1-5-73 V 774-339			
30	JAMES E + EDITH CRISS 8-12-68 V 699-171			
31	THE CLEVE ELEC. ILL CO 2-3-72 V 761-54			
32	THE CLEVE ELEC ILL. CO. 2-3-72 V 761-59			
33	EDWARD C + RUTH HOVLIK 6-27-66 V 647-22			
34	THE CLEVE ELEC ILL CO 5-29-73 V 779-192			

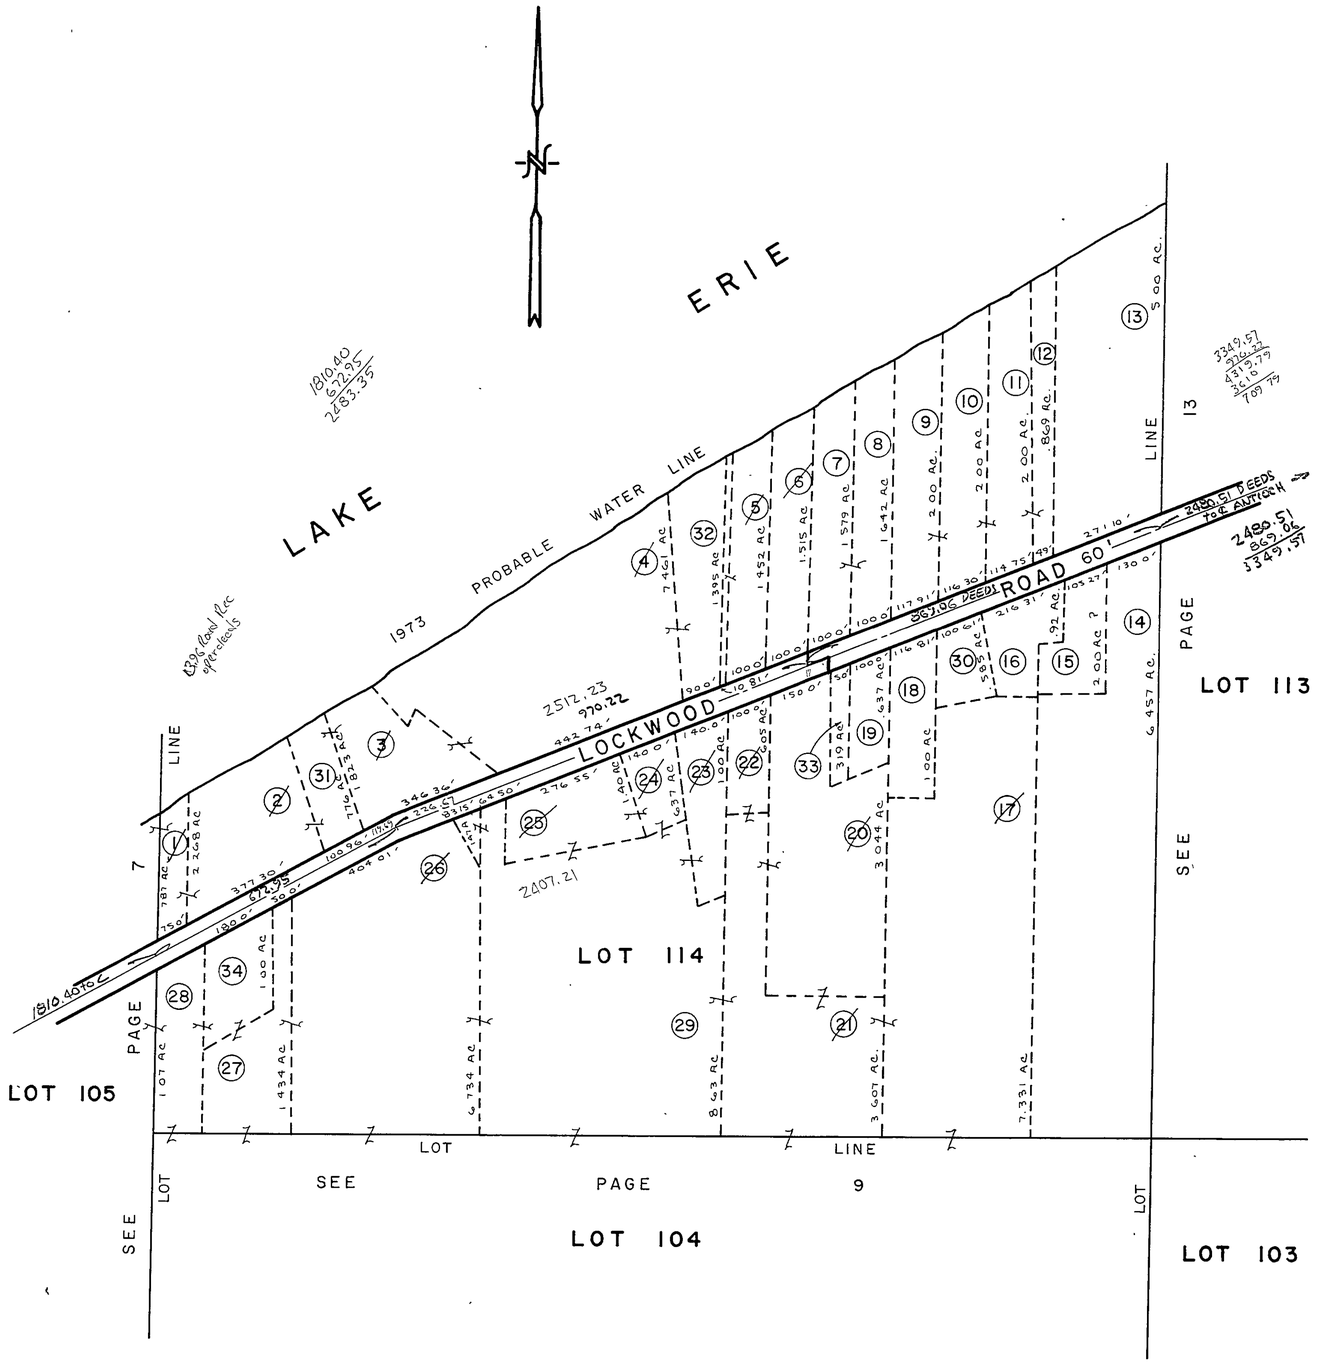

28.251

SCALE, 1" = 200'

0 50 100 200 300 400

R.L.K.

7-23-73