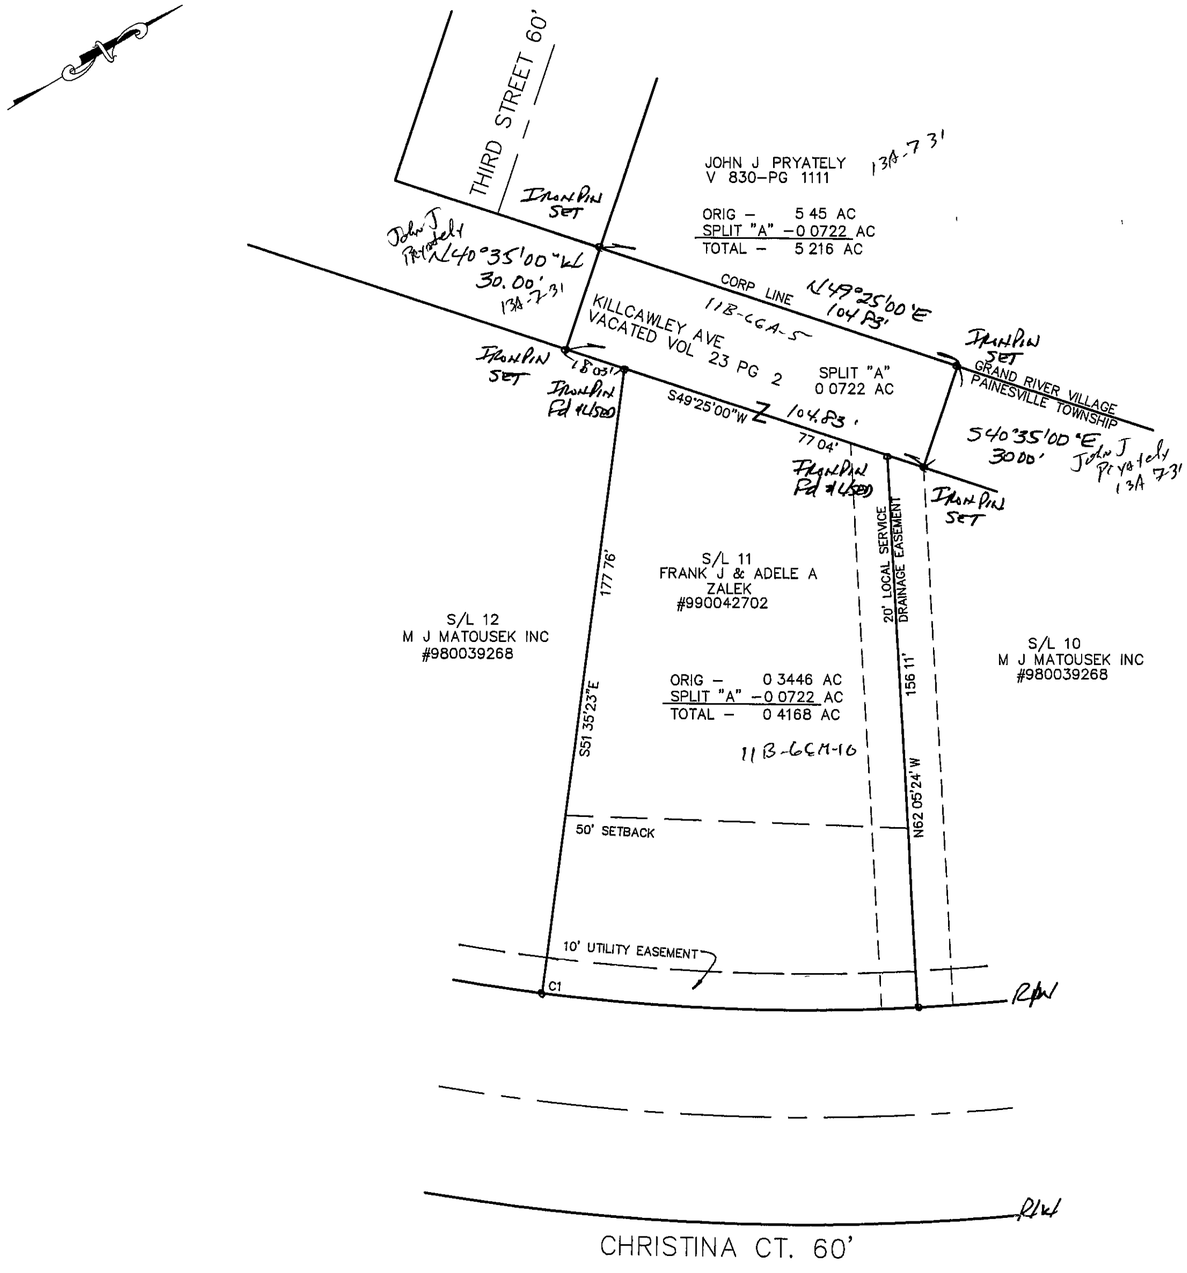

PLAT OF SURVEY

PAINESVILLE TWP. LAKE COUNTY, OHIO

for: FRANK ZALEK
CLIENT OWNER

ADDRESS STREET CITY ZIP

TIBER CREEK NAME TRACT STREET
SUBDIVISION

11 CHRISTINA CT. LOT
SUBLOT NO STREET VOL.–PG. PERM. PARCEL NO
VOL.–PG

LEGEND

SANITARY MANHOLE
STORM MANHOLE
INLET OR CATCH BASIN
HYDRANT
EXISTING CONTOURS
PROPOSED CONTOURS

EXIST ELEV 100.0 / 100.0 PROP. ELEV

AS BUILT ELEVATION 100.0 INDICATES DIRECTION OF SURFACE DRAINAGE

DESIGN CERTIFICATION

THIS PLAT WAS PREPARED BY ME, AND IS CORRECT TO THE BEST OF MY KNOWLEDGE AND BELIEF.

NAME SURVEYOR #6343 REGISTRATION NO.

REVISIONS					
NO.	DATE	BY			
1	7/26/01	HJ			
2					
3			DRAWN BY J.D.	SCALE 1" = 30'	PHONE NO. 440-357-1811
4			CHK'D. H.J.	DATE 6/25/01	DRAWING NO. 01-122
5			CREW CHIEF W.B.	APP'D H.J.	

PLAN PREPARED BY:
BABCOCK JONES & ASSOCIATES, INC.
PAINESVILLE, OHIO

C1 R=571 11'
L=104 66'
C=104 51'
D=10 29'58"
N33 09'51"E

"AS BUILT" CERTIFICATION
I, HEREBY CERTIFY THAT THE CIRCLED GRADES ARE EXISTING FINISH GRADES CHECKED IN THE FIELD ON _____, 20____ AND ARE CORRECT TO THE BEST OF MY KNOWLEDGE AND BELIEF.

REGISTERED SURVEYOR REG NO.

O/O 11B-66A-5

All iron pins that were found set were Capped iron pins (5/8") by B-J
HJ

STATE OF OHIO
HARRY S JONES, JR.
S-6343
REGISTERED
PROFESSIONAL SURVEYOR