


| FHWA REGION | STATE | PROJECT |
|-------------|-------|---------|
| 5 | OHIO | |

151
171

LAKE COUNTY
LAK-2-0.00

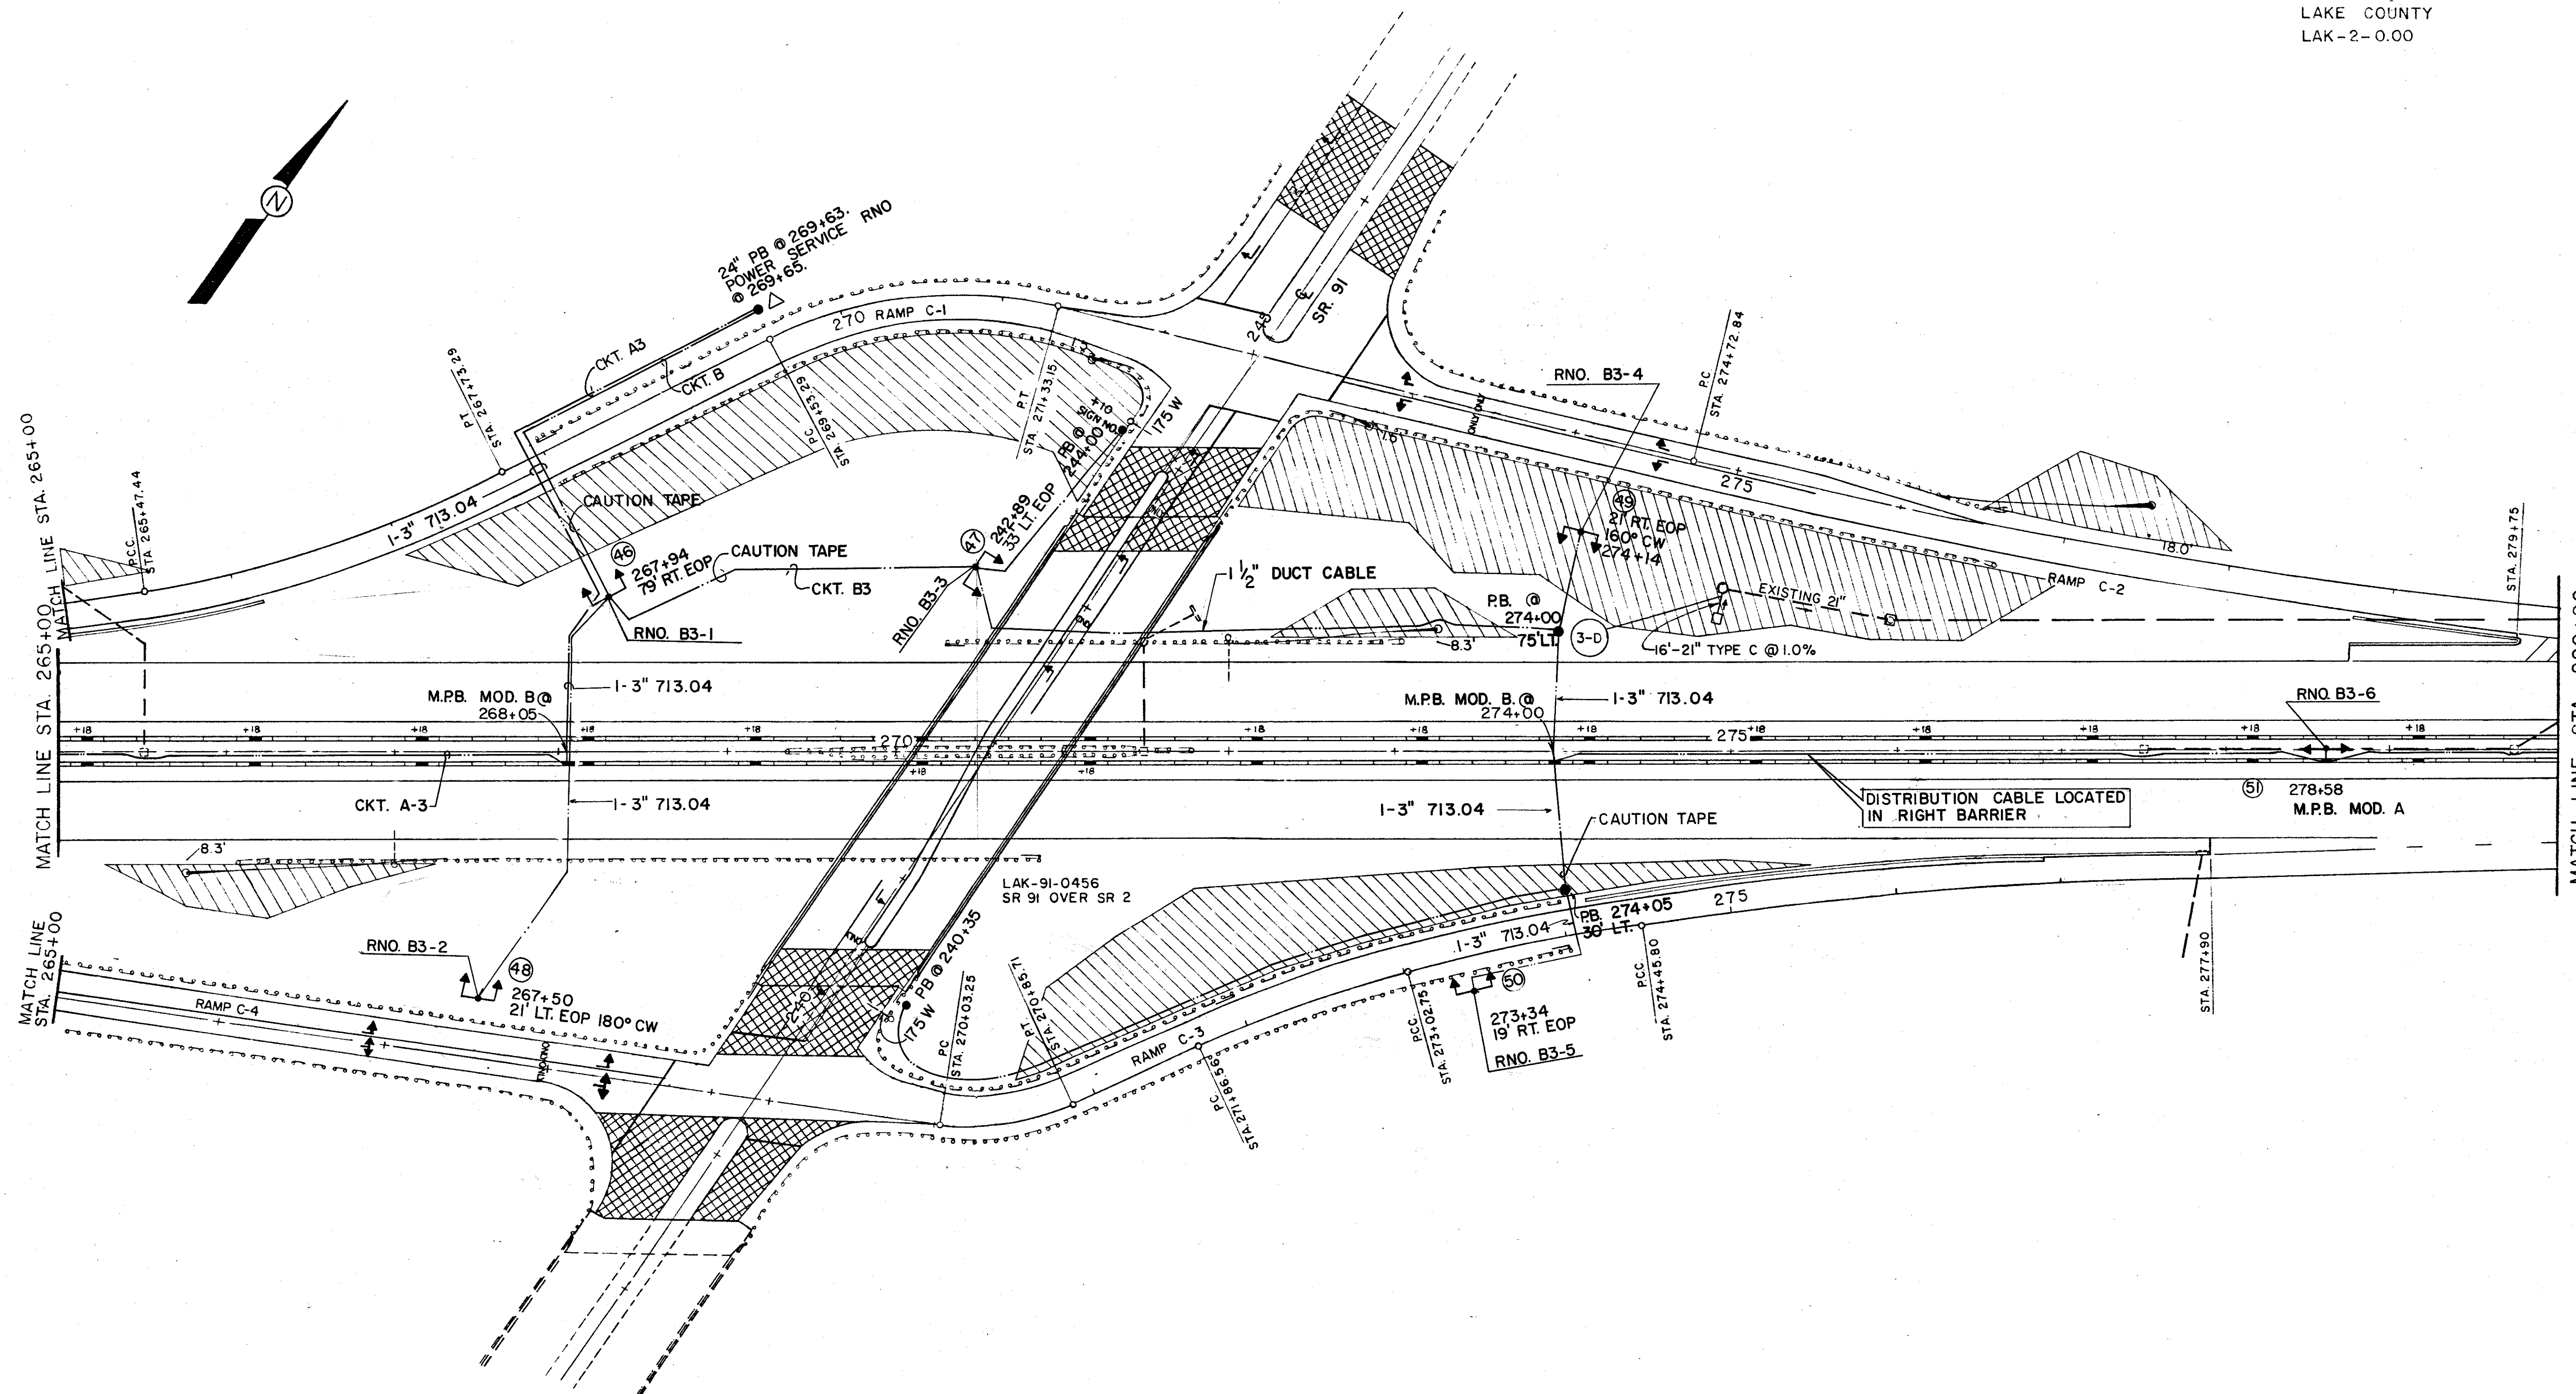

FOR LEGEND SEE SHEET 145