


LAKE COUNTY
LAK-2-0.00
Limited Access

§ MARGINAL RD CURVE DATA

Δ	= 4° 44' 32.15"
D	= 1° 00' 00"
R	= 5729.578'
L	= 237.249'
CH	= 474.226'
E	= 4.919'

§ LAKELAND CURVE DATA

Δ	= 1° 54' 05.95"
D	= 0° 20'
R	= 570.496'
L	= 17,188.734'
T	= 285.273'
Ch	= 570.470'
E	= 2.365'

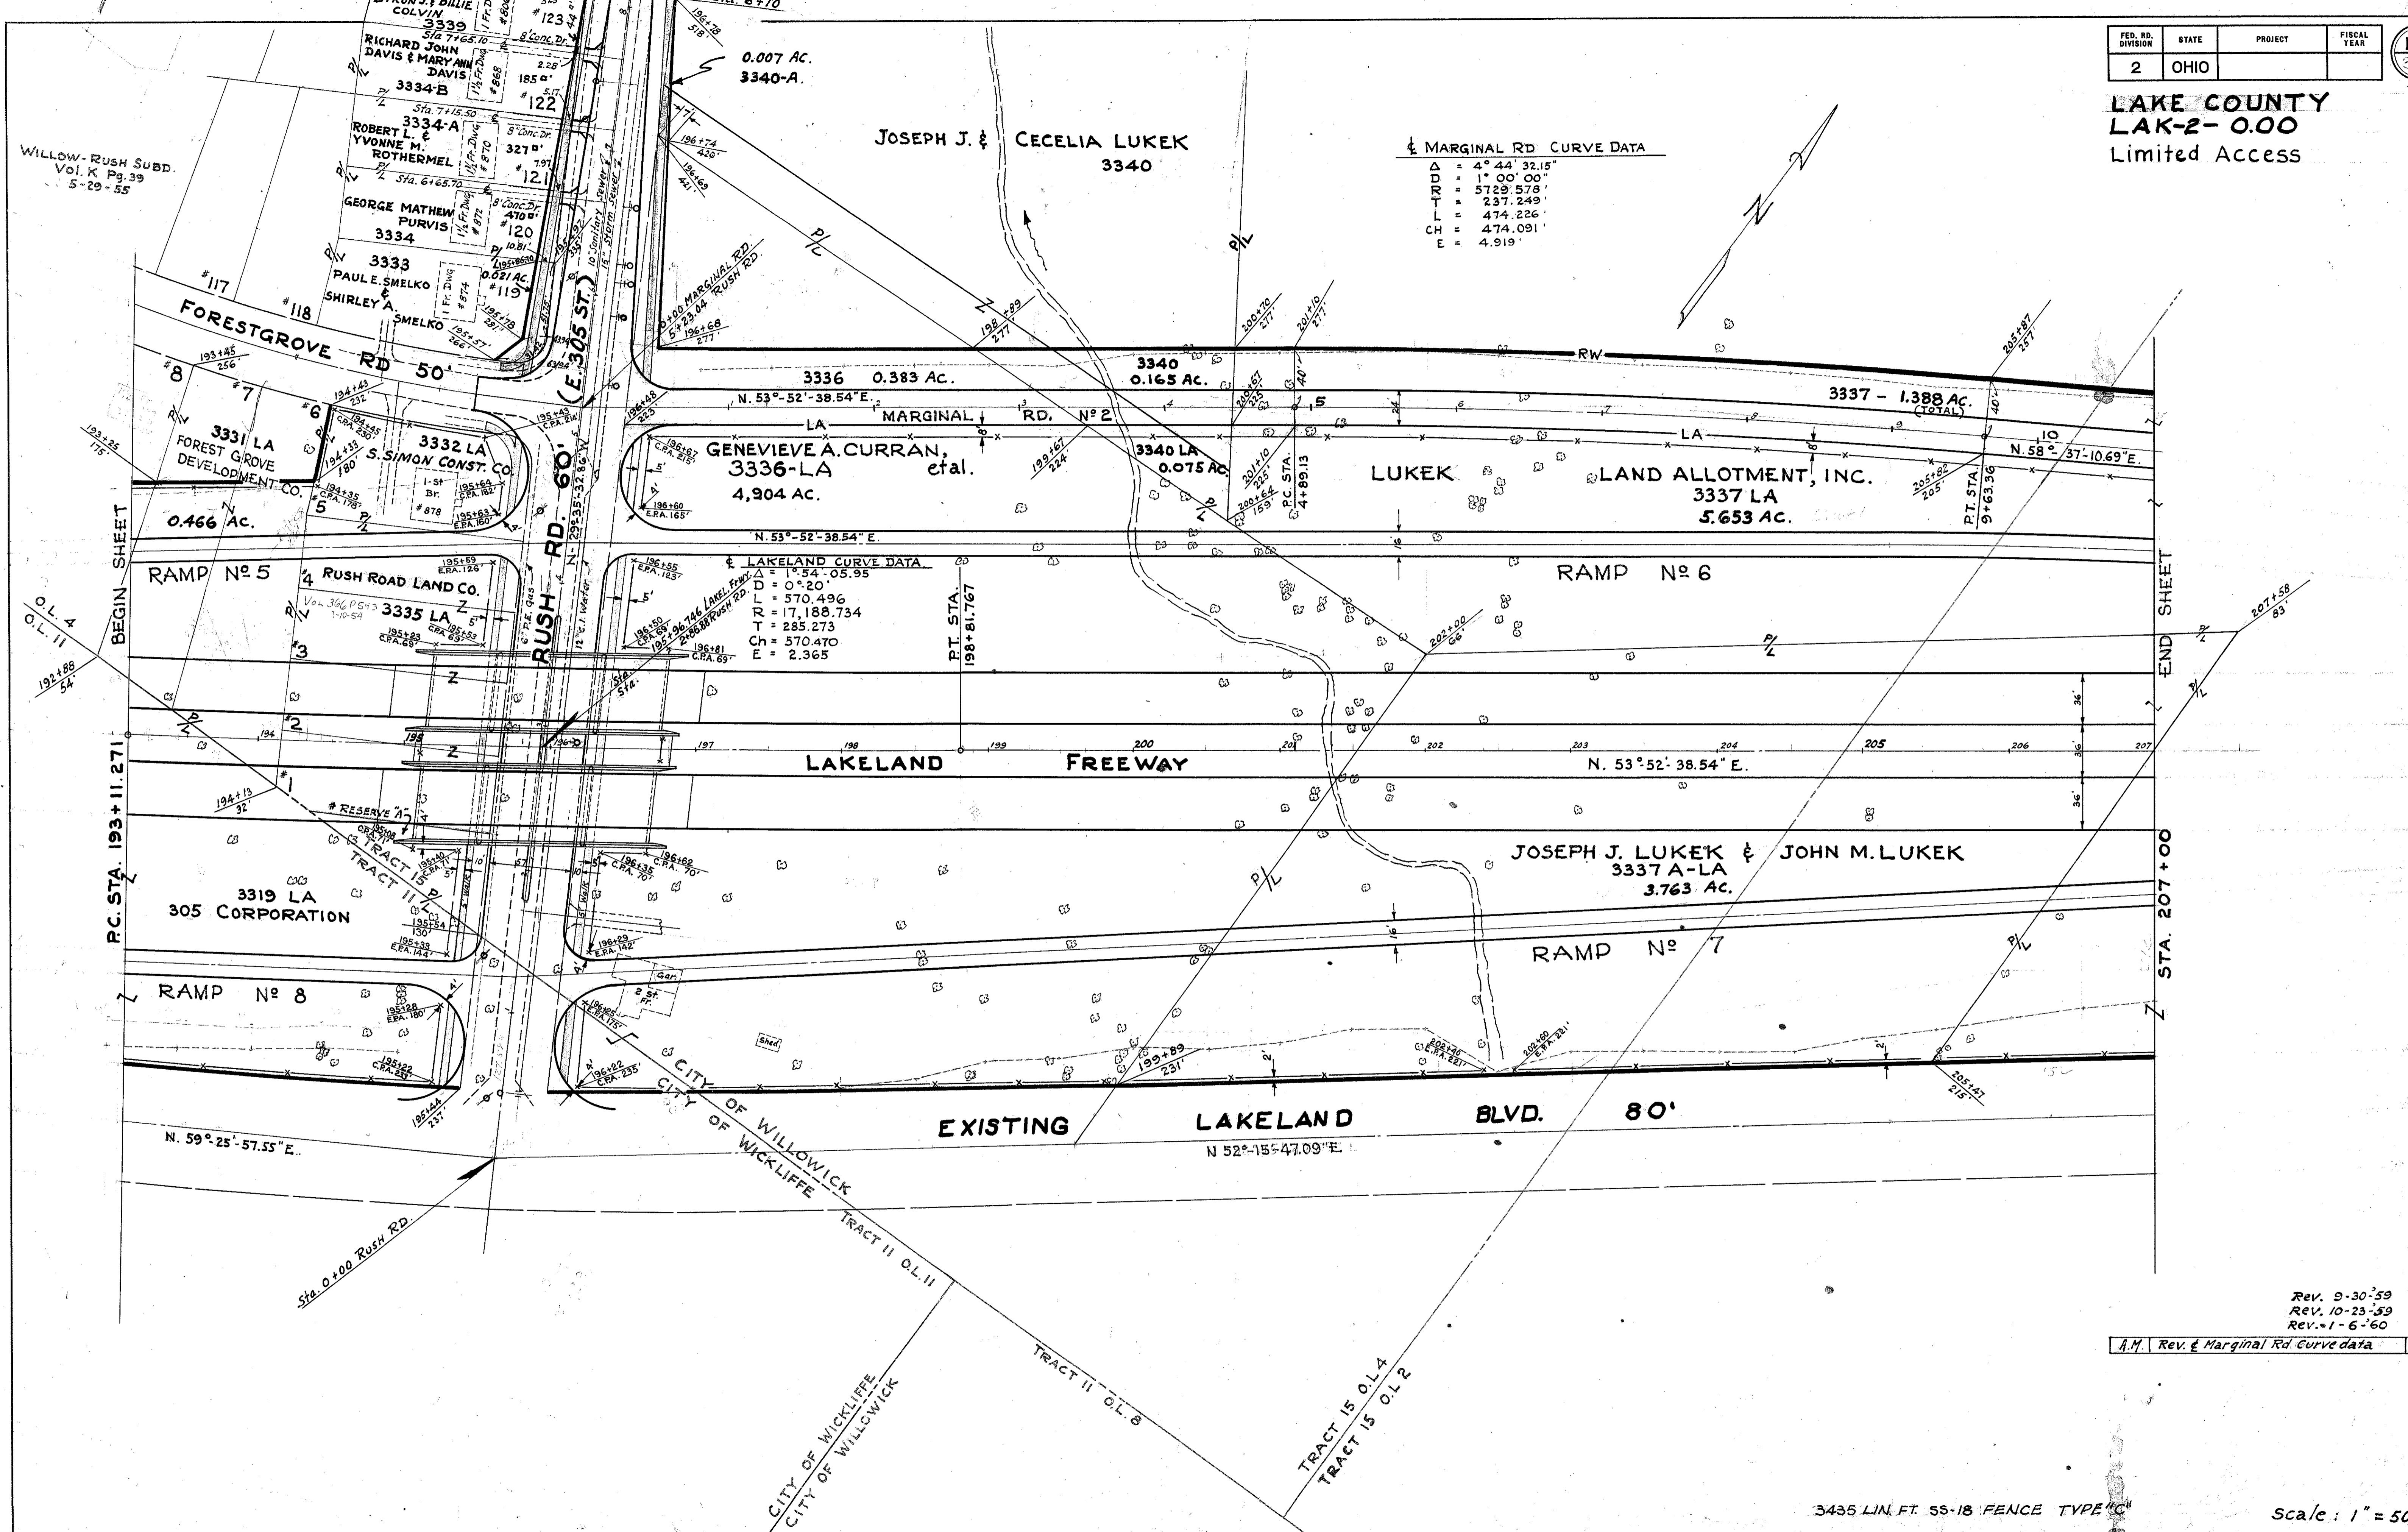

Rev. 9-30-59
Rev. 10-23-59
Rev. 1-6-60
A.M. Rev. & Marginal Rd Curve data 1-18-60

3435 LIN. FT. 55-18 FENCE TYPE "C"

Scale: 1" = 50'