

**LAKE COUNTY**  
**LAK - 2 - 0.00**  
LIMITED ACCESS

**VOID**  
SEE SHEET N<sup>o</sup> 130  
SCALE: 1" = 100'

SEE INSERT  
AT REDUCED SCALE


**P/W REQUIRED**

| PARCEL  | ACREAGE          | SLOPE ACREAGE |
|---------|------------------|---------------|
| 3600    | 0.0015           |               |
| 3601    | 0.007            |               |
| 3602    | 0.014            | 0.002         |
| 3603+SL | 0.015            | 0.002         |
| 3604+SL | 0.012            | 0.005         |
| 3605    | See 50 Scale map |               |
| 3606    | NONE             |               |
| 3607    | 0.001            |               |
| 3608    | 0.005            |               |
| 3609+SL | 0.007            | 0.0014        |
| 3610+SL | 0.011            | 0.005         |

**LAKELAND FRWY CURVE DATA**  
 $\Delta = 11^{\circ}33'24"$   
 $D = 1^{\circ}00'$   
 $L = 1155.667$   
 $R = 5729.580$   
 $T = 579.801$   
 $C = 1158.109$   
 $E = 292.64$

**CURVE DATA LAKELAND RELOCATION**

|          |   |                    |
|----------|---|--------------------|
| $\Delta$ | = | 31^{\circ}10'52.82 |
| $DB$     | = | 5^{\circ}30'       |
| $RR$     | = | 1041.74            |
| $TC$     | = | 566.933            |
| $CC$     | = | 290.676            |
| $E$      | = | 599.962            |
| $F$      | = | 39.794             |

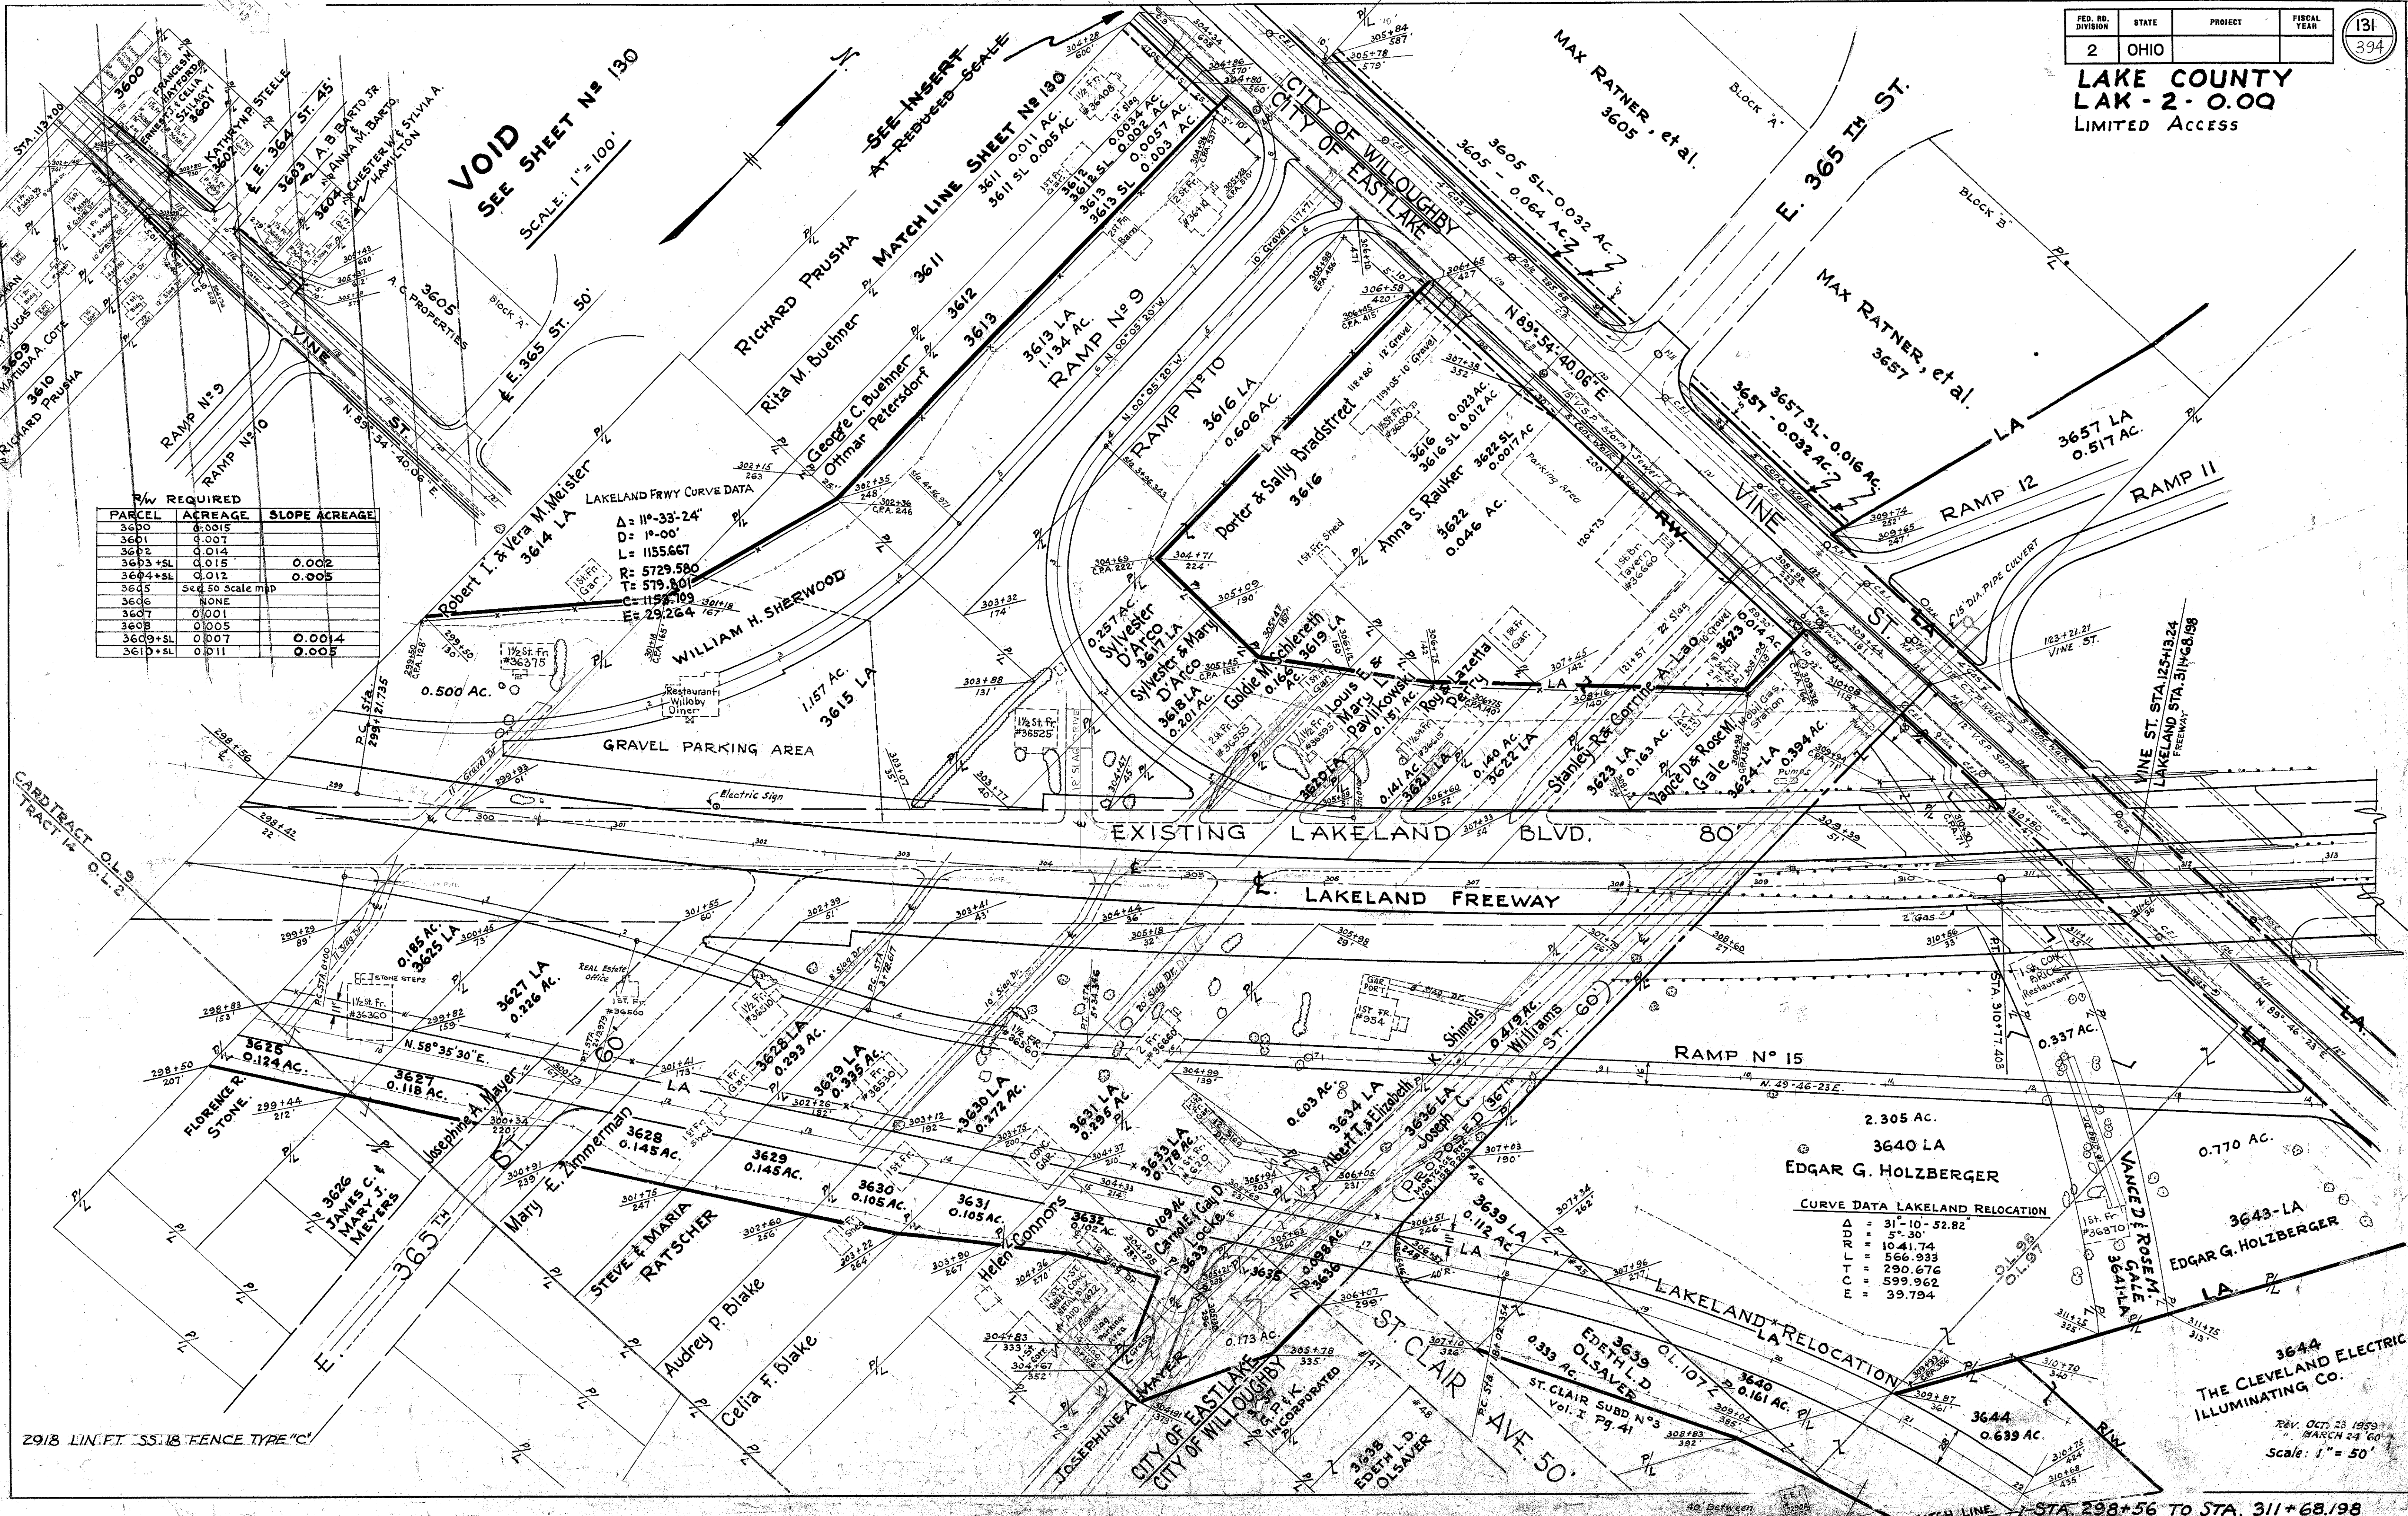

2918 LIN. FT. SS. 18 FENCE TYPE "C"

REV. OCT. 23 1959  
MARCH 24 60  
Scale: 1" = 50'

MATCH LINE - STA. 298+56 TO STA. 311+68.198