FED. RD. DIVISION	STATE	PROJECT		354
2	OHIO			379

LAKE COUNTY

NOTES:
E.F. denotes each face SEC. LAK-2-10.35
F.F. denotes front face
R.F. denotes rear face
Reinforcing steel shall have a minimum of 3" cover in the bottom of footing and 2" elsewhere.

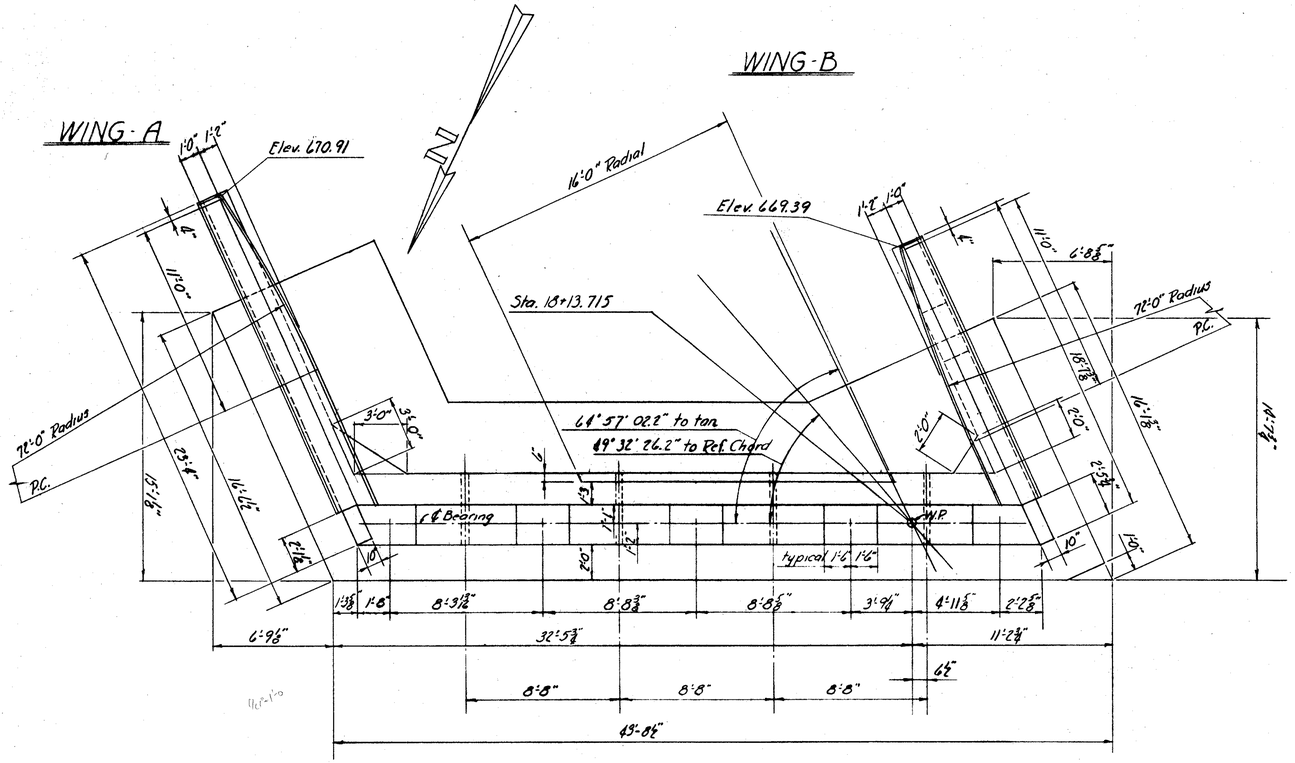

PLAN ABUTMENT-2

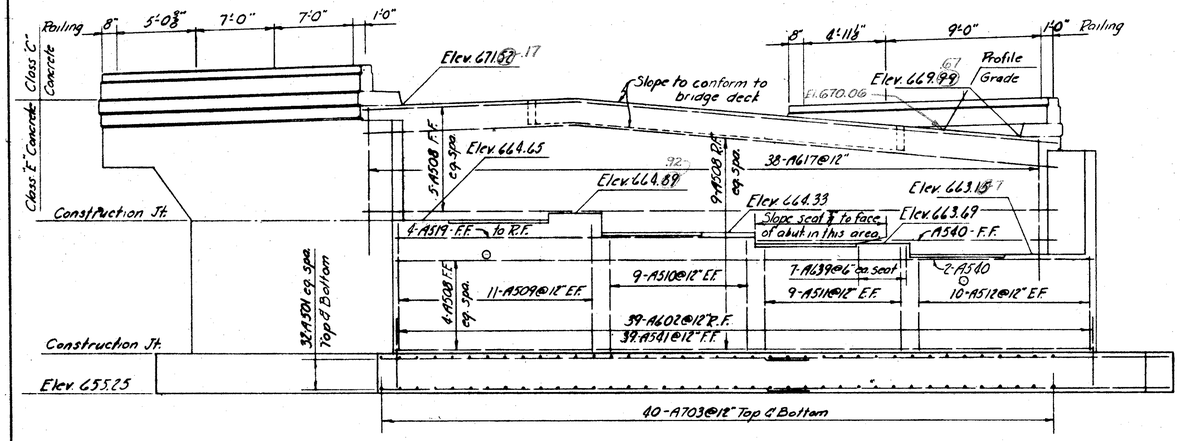

ELEVATION ABUTMENT-2

MICROFILMED
JUL 1 1985

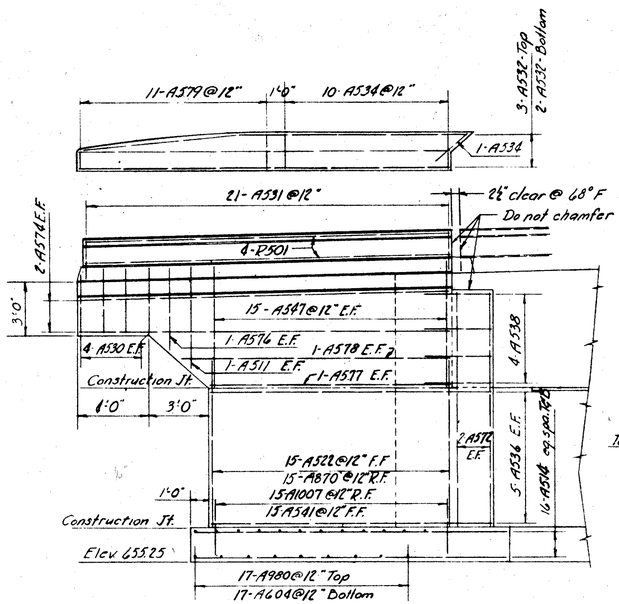

ELEVATION WING-A

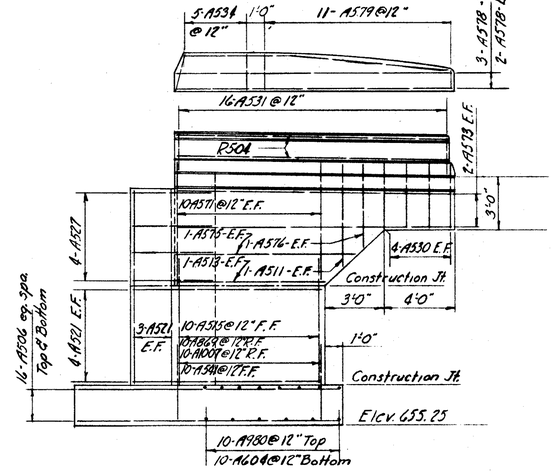

ELEVATION WING-B

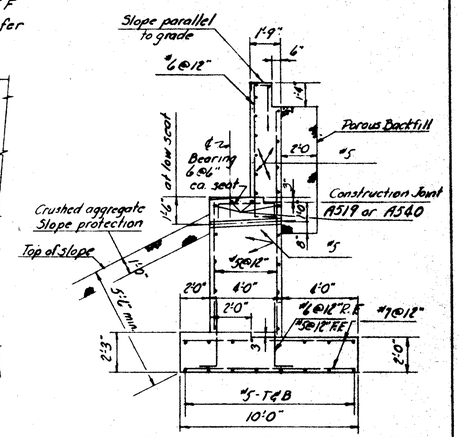

TYPICAL ABUTMENT SECTION

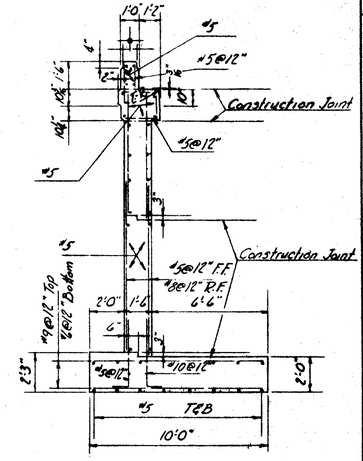

TYPICAL WINGWALL SECTION

SEC. L-33

PREPARED BY
CAPITOL ENGINEERING ASSOCIATES, DILLSBURG, PA.
FOR

STATE OF OHIO
DEPARTMENT OF HIGHWAYS
DIVISION OF DESIGN AND CONSTRUCTION
BUREAU OF BRIDGES

ABUTMENT 2
BRIDGE NO. LAK-2-1351
RELOC. S.R.2 UNDER S.R. 44 RAMP E

LAKE COUNTY
STA. 613 + 25.24

DESIGNED	DRAWN	TRACED	CHECKED	REVISED DATE	REVISED
RLK	RLK		JCM		7-27-87