
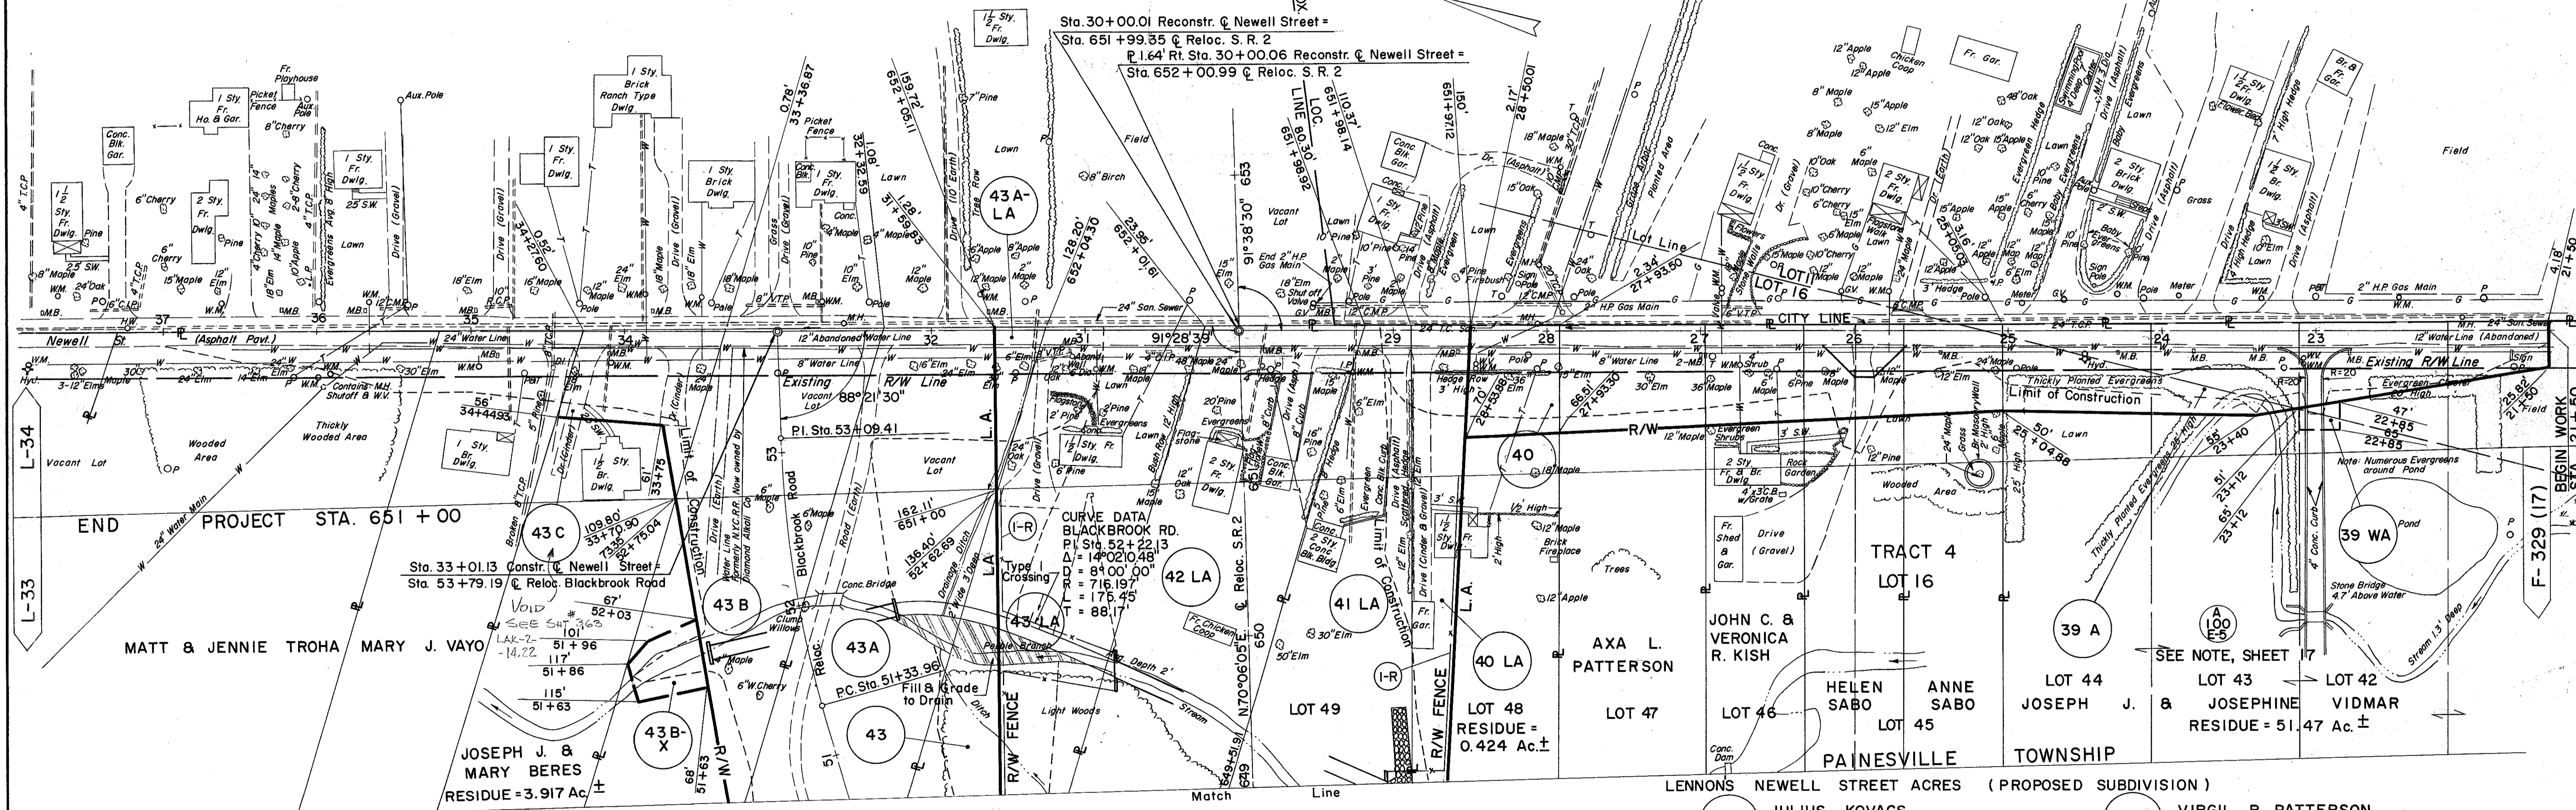


CITY OF PAINESVILLE

PAINESVILLE TOWNSHIP

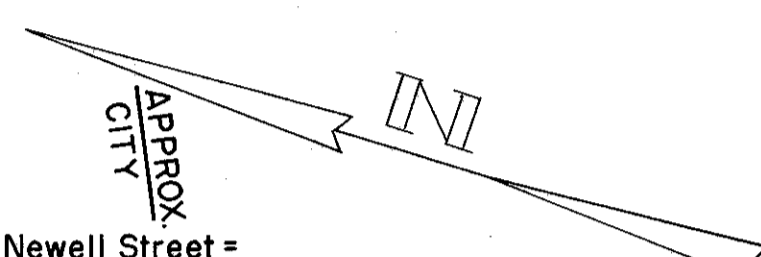

- 43 B ELIZABETH OROS
Cont. 0.46 Ac.
P.R.O. = 0.07 Ac.
- 43 A LOUIS RONSKO
Cont. 0.92 Ac.
P.R.O. = 0.05 Ac.
- 43 LA DOYLE W. & GRACE WOODWORTH
Cont. 0.60 Ac.
P.R.O. = 0.07 Ac.
- 42 LA ALEX & MARGARET KOVACS
Cont. 1.27 Ac.
P.R.O. = 0.07 Ac.
- 43 BX Cont. 0.04 Ac.
- 43A-LA Cont. 0.02 Ac.
P.R.O. = 0.02 Ac.
- 43 Cont. 0.75 Ac.
- 40 LA VIRGIL R. PATTERSON
Cont. 0.25 Ac.
P.R.O. = 0.03 Ac.
- 43 C JOSEPH J. & MARY BERES
Cont. 0.08 Ac.
P.R.O. = 0.06 Ac.
- 39A JOSEPH J. & JOSEPHINE VIDMAR
Cont. 0.14 Ac.
P.R.O. = 0.24 Ac.
- 40 Cont. 0.05 Ac.
P.R.O. = 0.04 Ac.

S-24 REMOVAL OF STRUCTURES

PARCEL	DESCRIPTION
40 LA	1 1/2 STY. FRAME DWELLING
40 LA	FRAME GARAGE
41 LA	2 STY. CONC. BLK. BLDG.
42 LA	2 STY. FRAME DWELLING
42 LA	CONC. BLK. GARAGE
42 LA	FRAME CHICKEN COOP
43 LA	1 1/2 STY. FRAME DWELLING

(R) ROADWAY

REF. NO.	STATION	SIDE	T-10 DUMPED ROCK CHANNEL PROTECT.	SS-18 FENCE TYPE "D"
	FROM TO		C.Y.	L.F.
I-R	649+00 651+00	LT.		228
I-R	649+00 651+00	RT.		306

Rev. 1-25-60
3-24-60