


Seeding  
End Width  
Sq. Yds.

LAKE COUNTY  
LAK-2-14.22

NOTE:  
Templates on These Sections are Drawn Showing A 16' Shoulder on The Right of Traffic and A 5' Paved Shoulder on The Left of Traffic. The Project Shall Be Constructed Per The Typical Section Sheet No. 5. Earthwork Quantities Have Been Adjusted To Reflect The Change. The Transition in Width For These Two Dimensions Shall Be Obtained Between Sta. 651+00 & Sta. 651+50

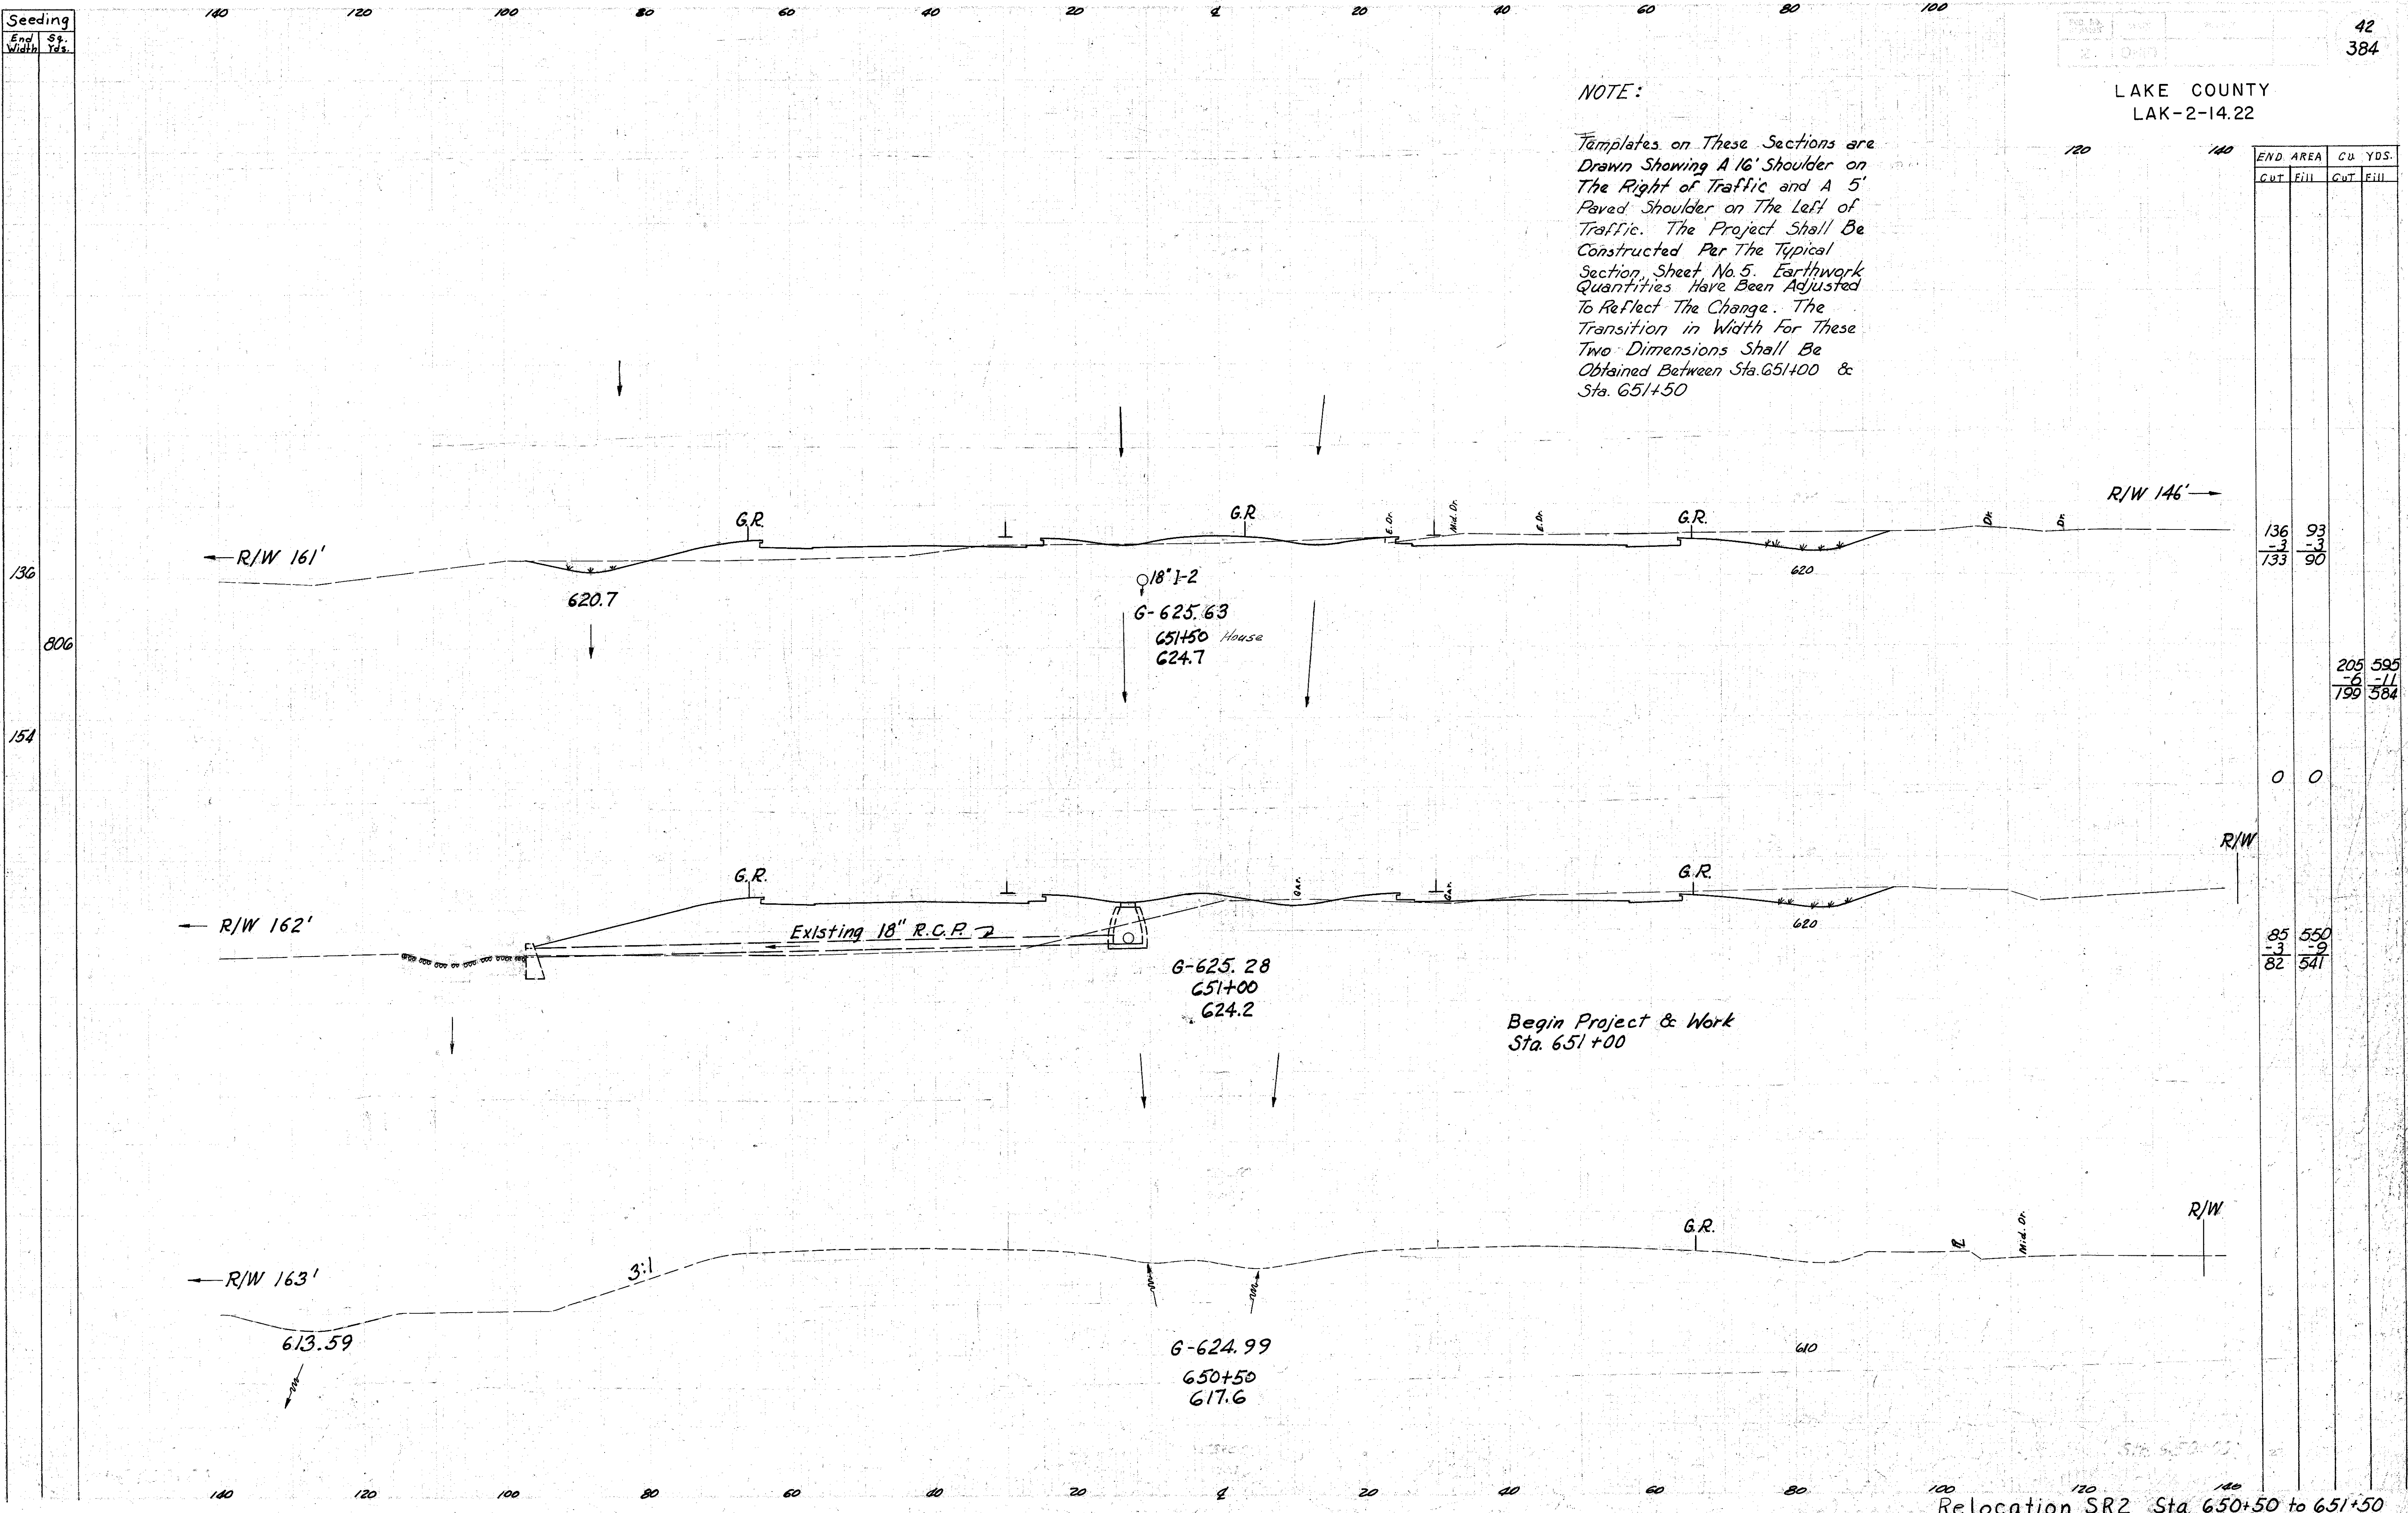

END AREA		CU. YDS.	
CUT	FILL	CUT	FILL

136	93		
-3	-3		
133	90		

205	595		
-6	-11		
199	584		

0	0		
---	---	--	--

85	550		
-3	-9		
82	541		