


SEEDING
END STA.
WIDTH YDS.

LAKE COUNTY
LAK-2-14.22

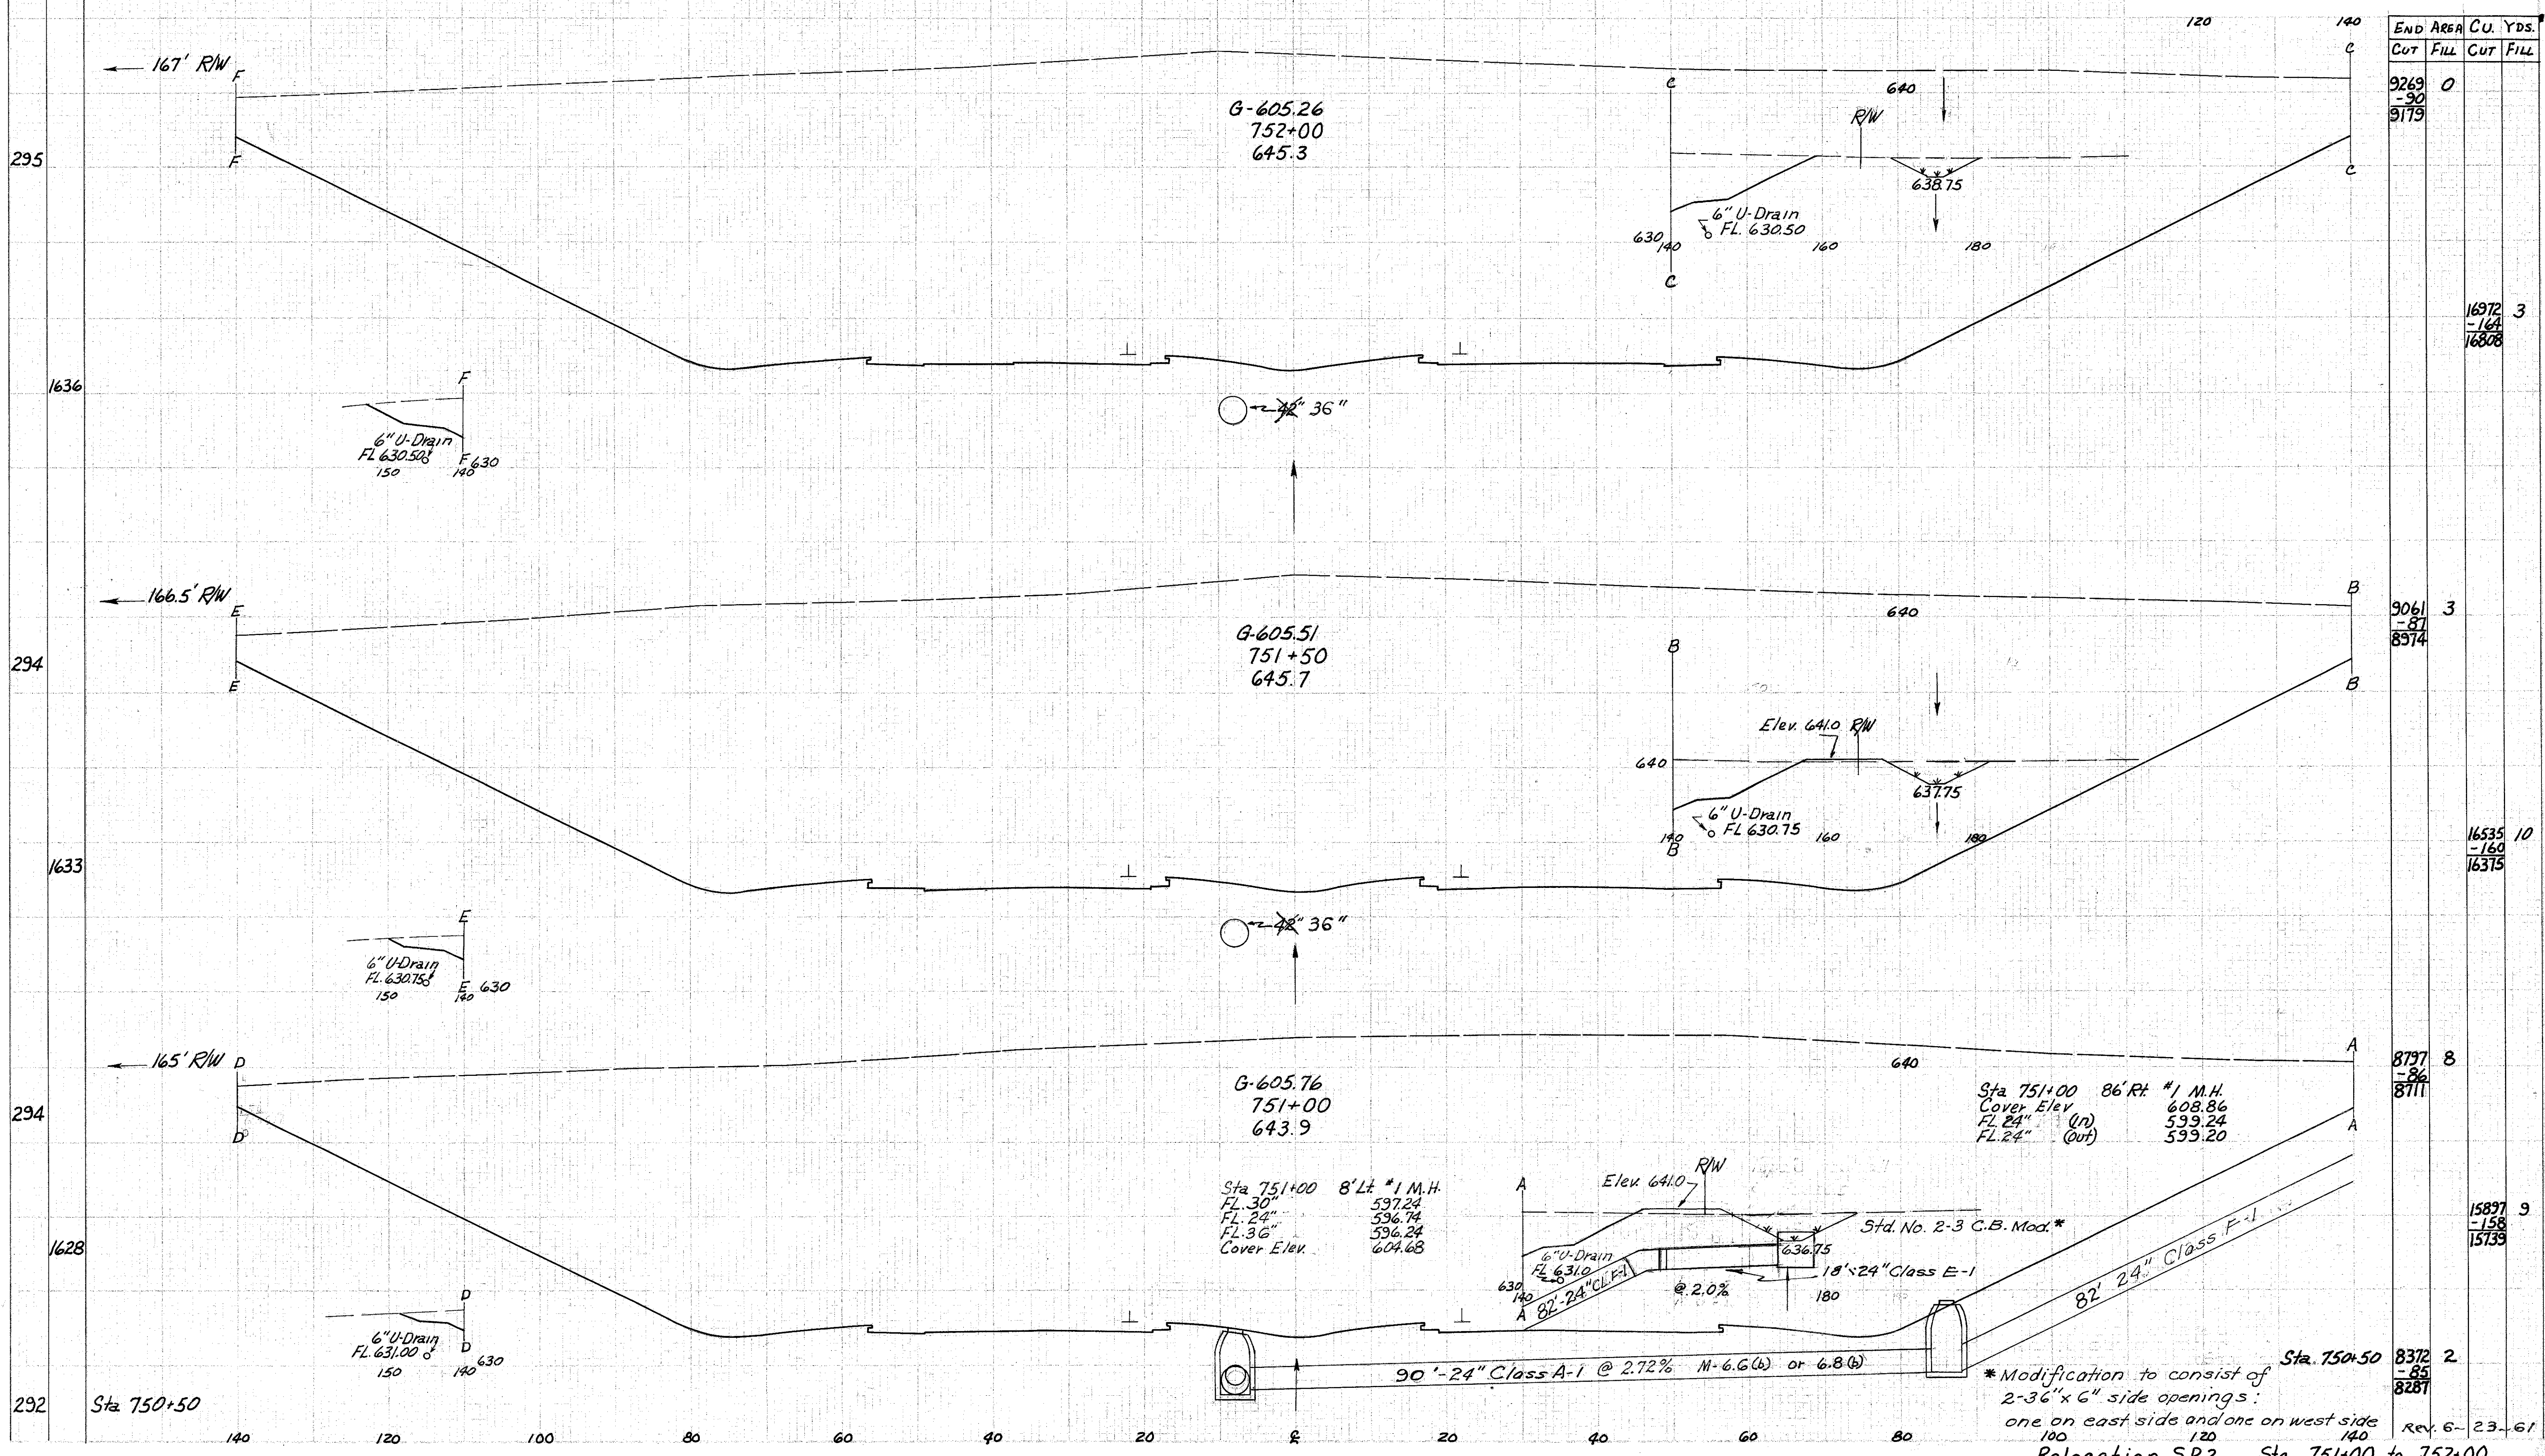

END STA.	AREA	CUT	FILL	C.U. YDS.
9269	0			
-90				
9179				

16972	3
-164	
16808	

9061	3
-87	
8574	

16535	10
-160	
16375	

8797	8
-86	
8711	

15897	9
-158	
15739	

8372	2
-85	
8287	

G-605.26
752+00
645.3

G-605.51
751+50
645.7

G-605.76
751+00
643.9

Sta 751+00 8' Lt #1 M.H.
FL 30" 597.24
FL 24" 596.74
FL 36" 596.24
Cover Elev. 604.68

Sta 751+00 86' Rt #1 M.H.
Cover Elev 608.86
FL 24" (In) 599.24
FL 24" (Out) 599.20

*Modification to consist of
2-36" x 6" side openings:
one on east side and one on west side

Relocation S.R.2 Sta. 751+00 to 752+00