


SEEDING
END STA.
WIDTH YRS.

LAKE COUNTY
LAK-2-14.22

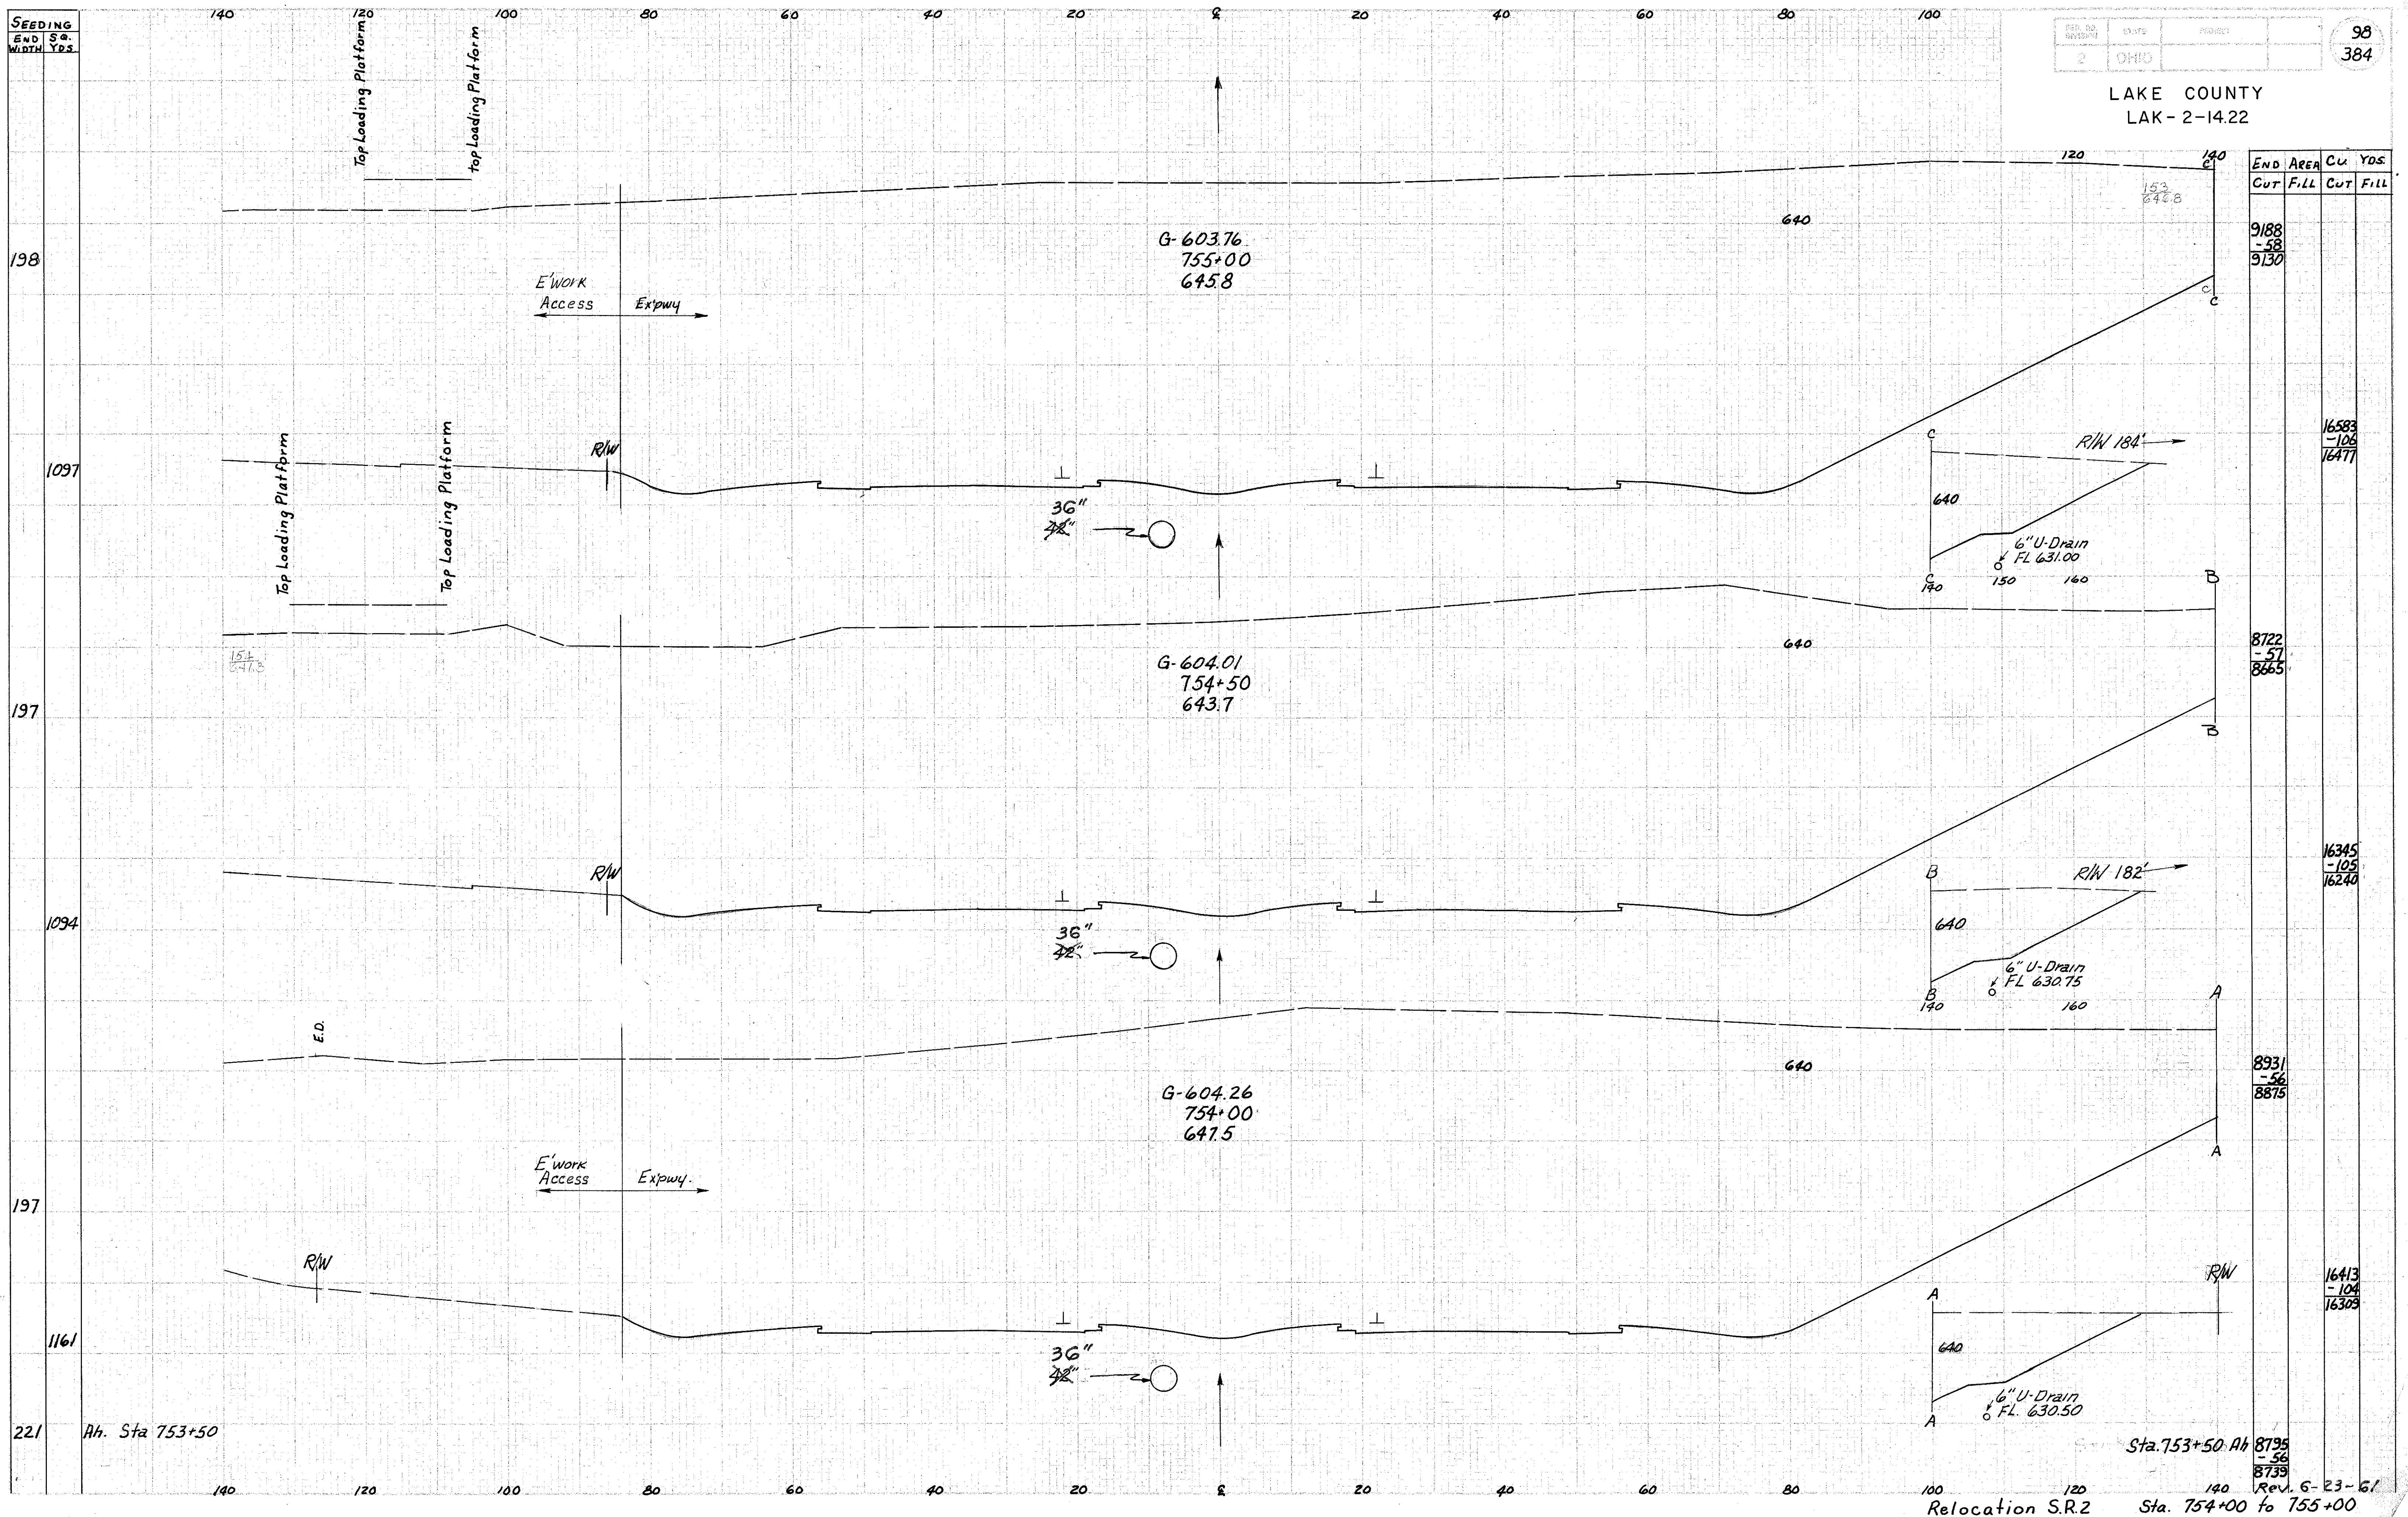

END STA.	AREA		Cu Yds.	
	Cut	Fill	Cut	Fill
198	9188	-58		
	9130			
1097			16583	-106
			16477	
197	8722	-57		
	8665			
1094			16345	-125
			16240	
197	8931	-56		
	8875			
1161			16413	-104
			16309	
221			8795	-56
			8739	

Sta. 753+50 Ab. 8795
-56
8739
Rev. 6-23-61
Relocation S.R.2 Sta. 754+00 to 755+00