


SEEDING
END SQ.
WIDTH YDS.

LAKE COUNTY
LAK-2-14.22

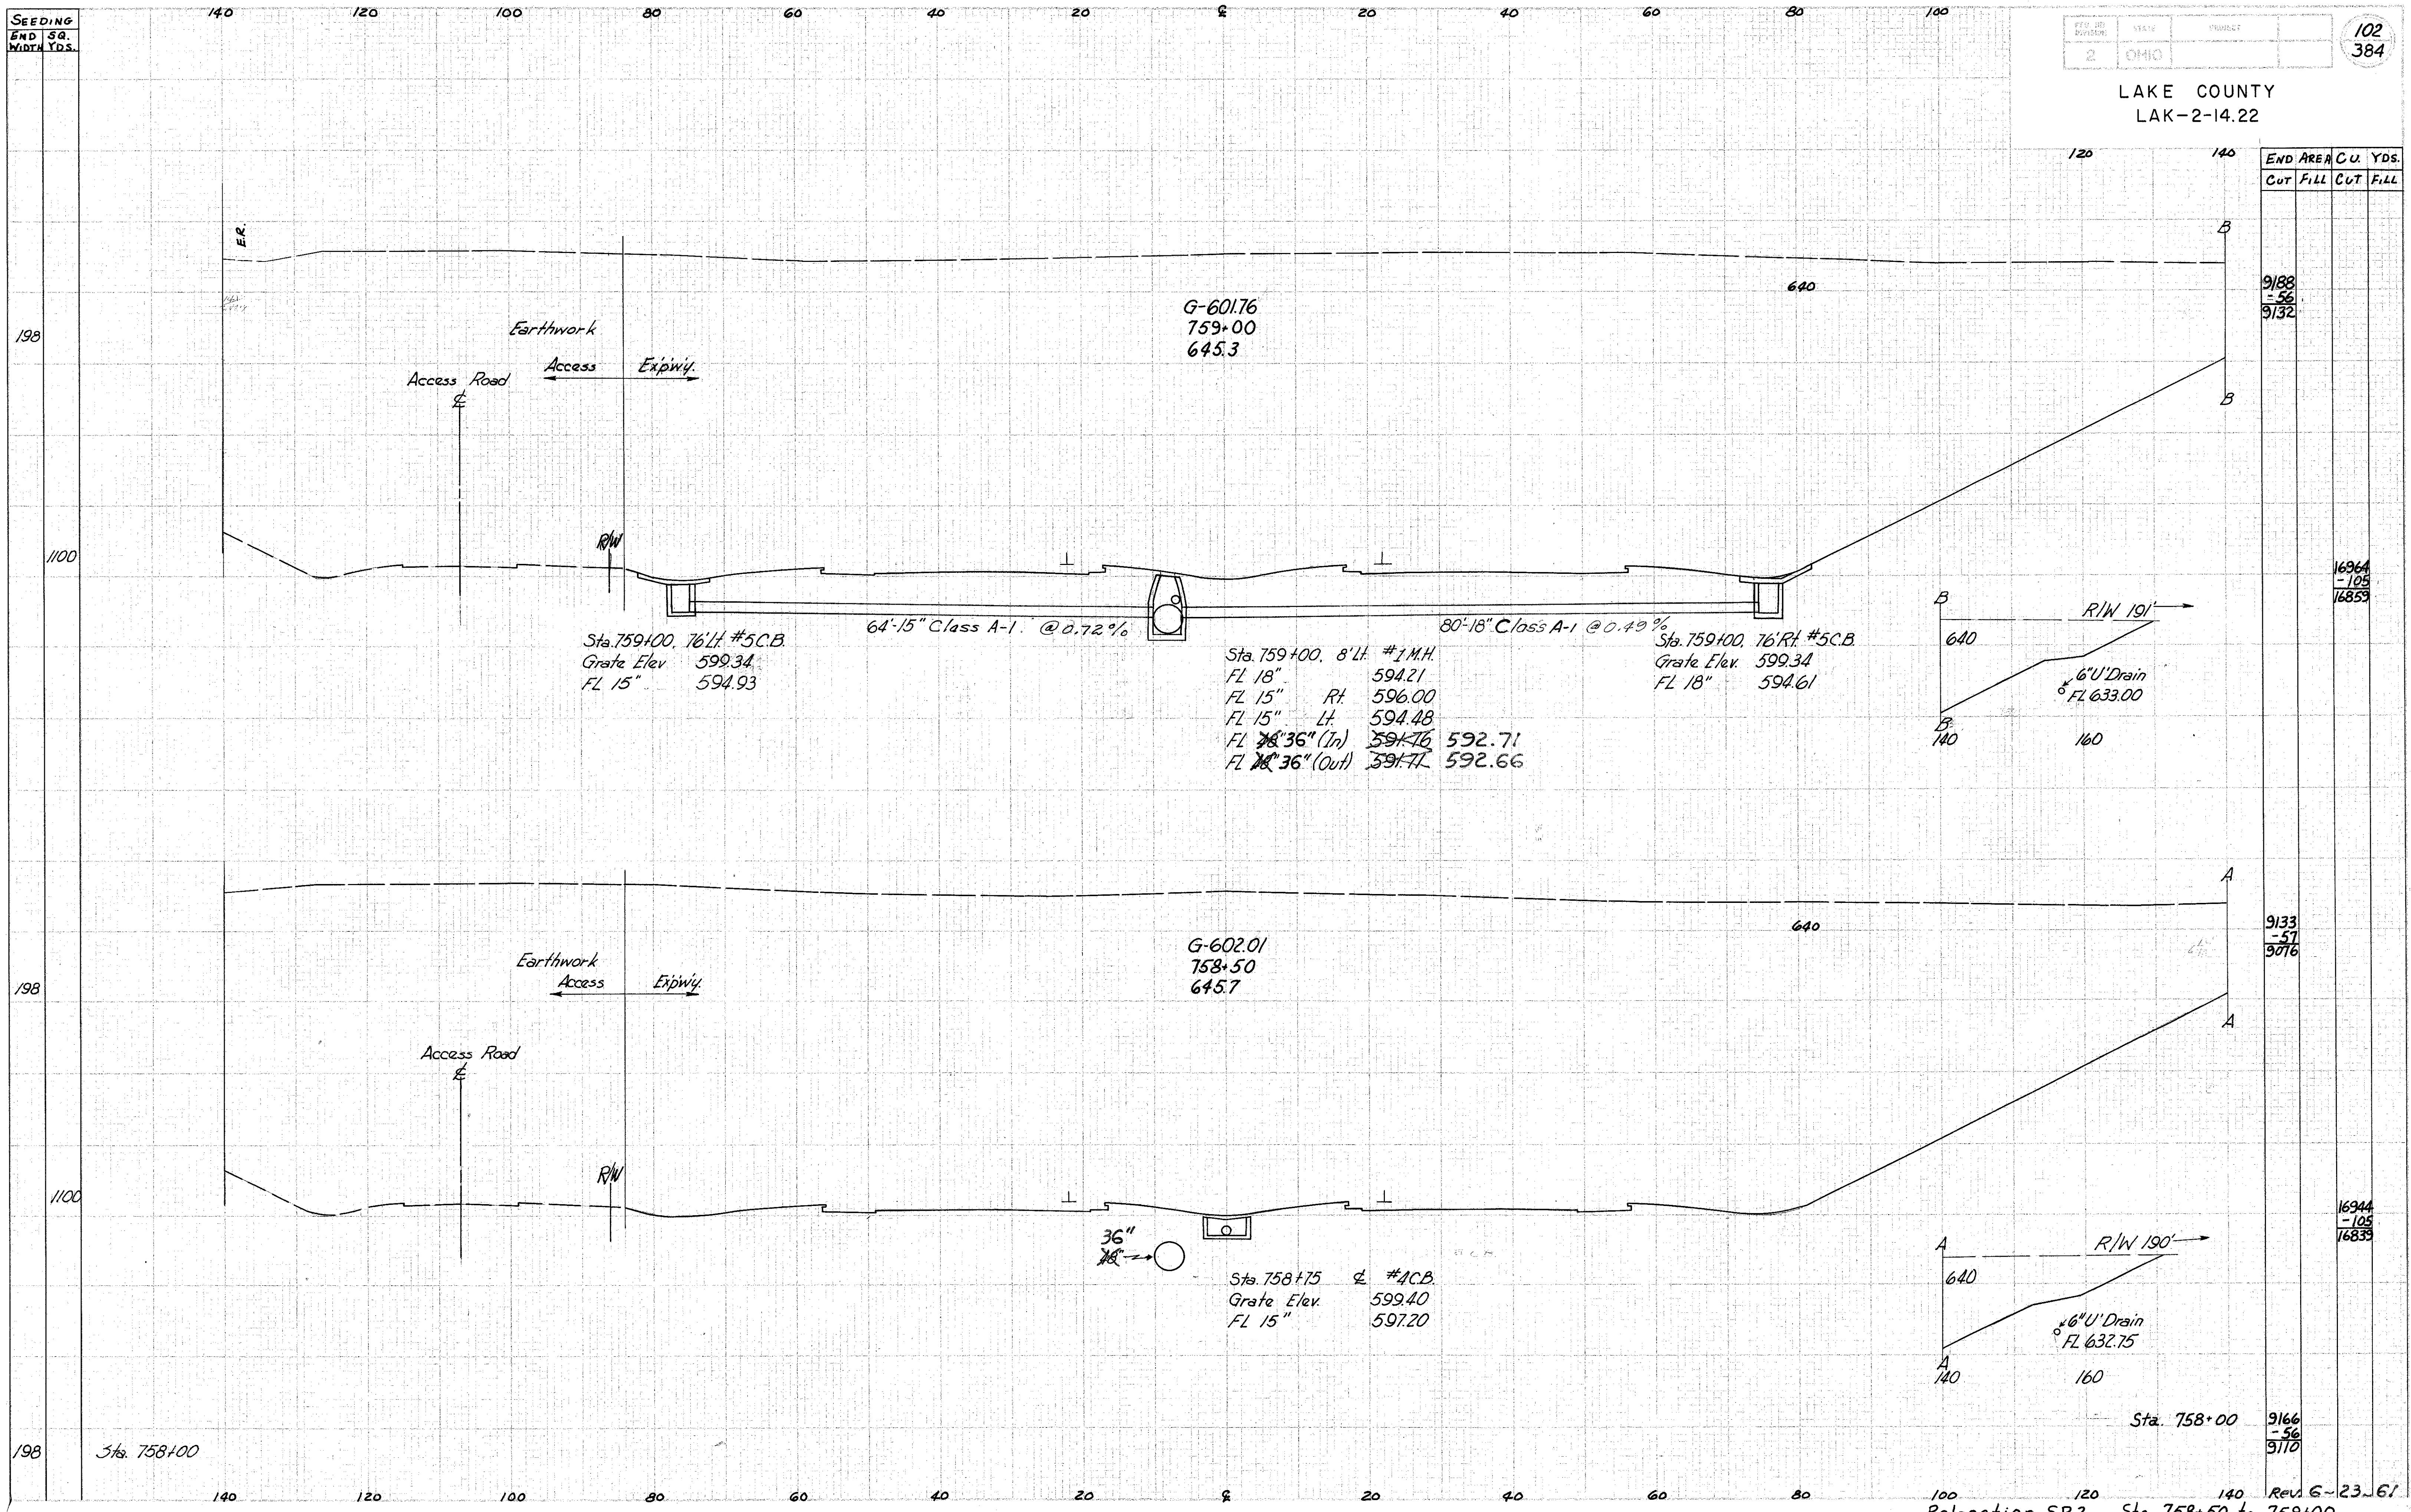

END AREA	CUT	FILL	CUT	FILL	YDS.
----------	-----	------	-----	------	------



9188
-56
9132

16944
-105
16839

9133
-57
9076

16944
-105
16839

9166
-56
9110

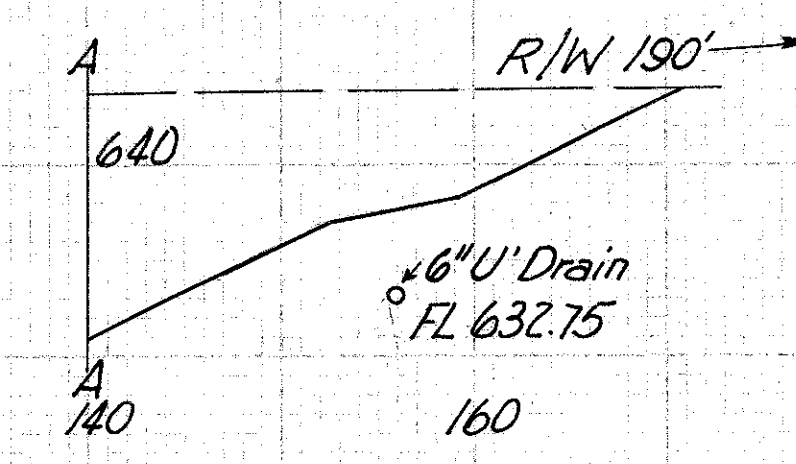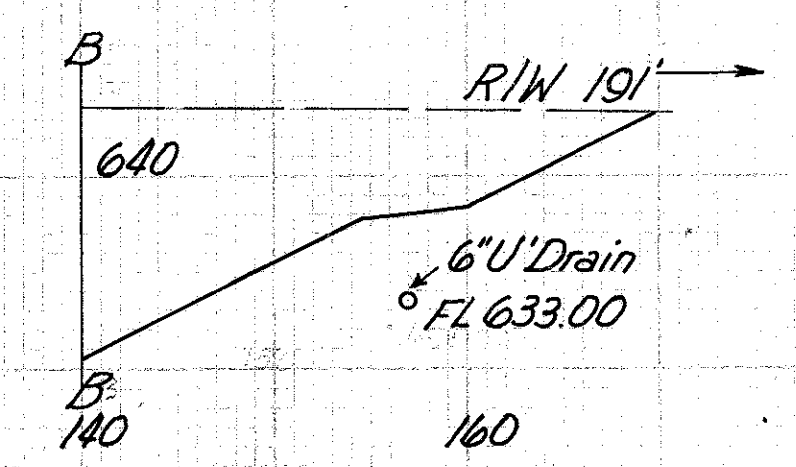

Sta. 758+00
Relocation S.R.2 Sta. 758+50 to 759+00
Rev G-23-61