


Seeding  
End Width Sq. Yds.

LAKE COUNTY  
LAK-2-14.22

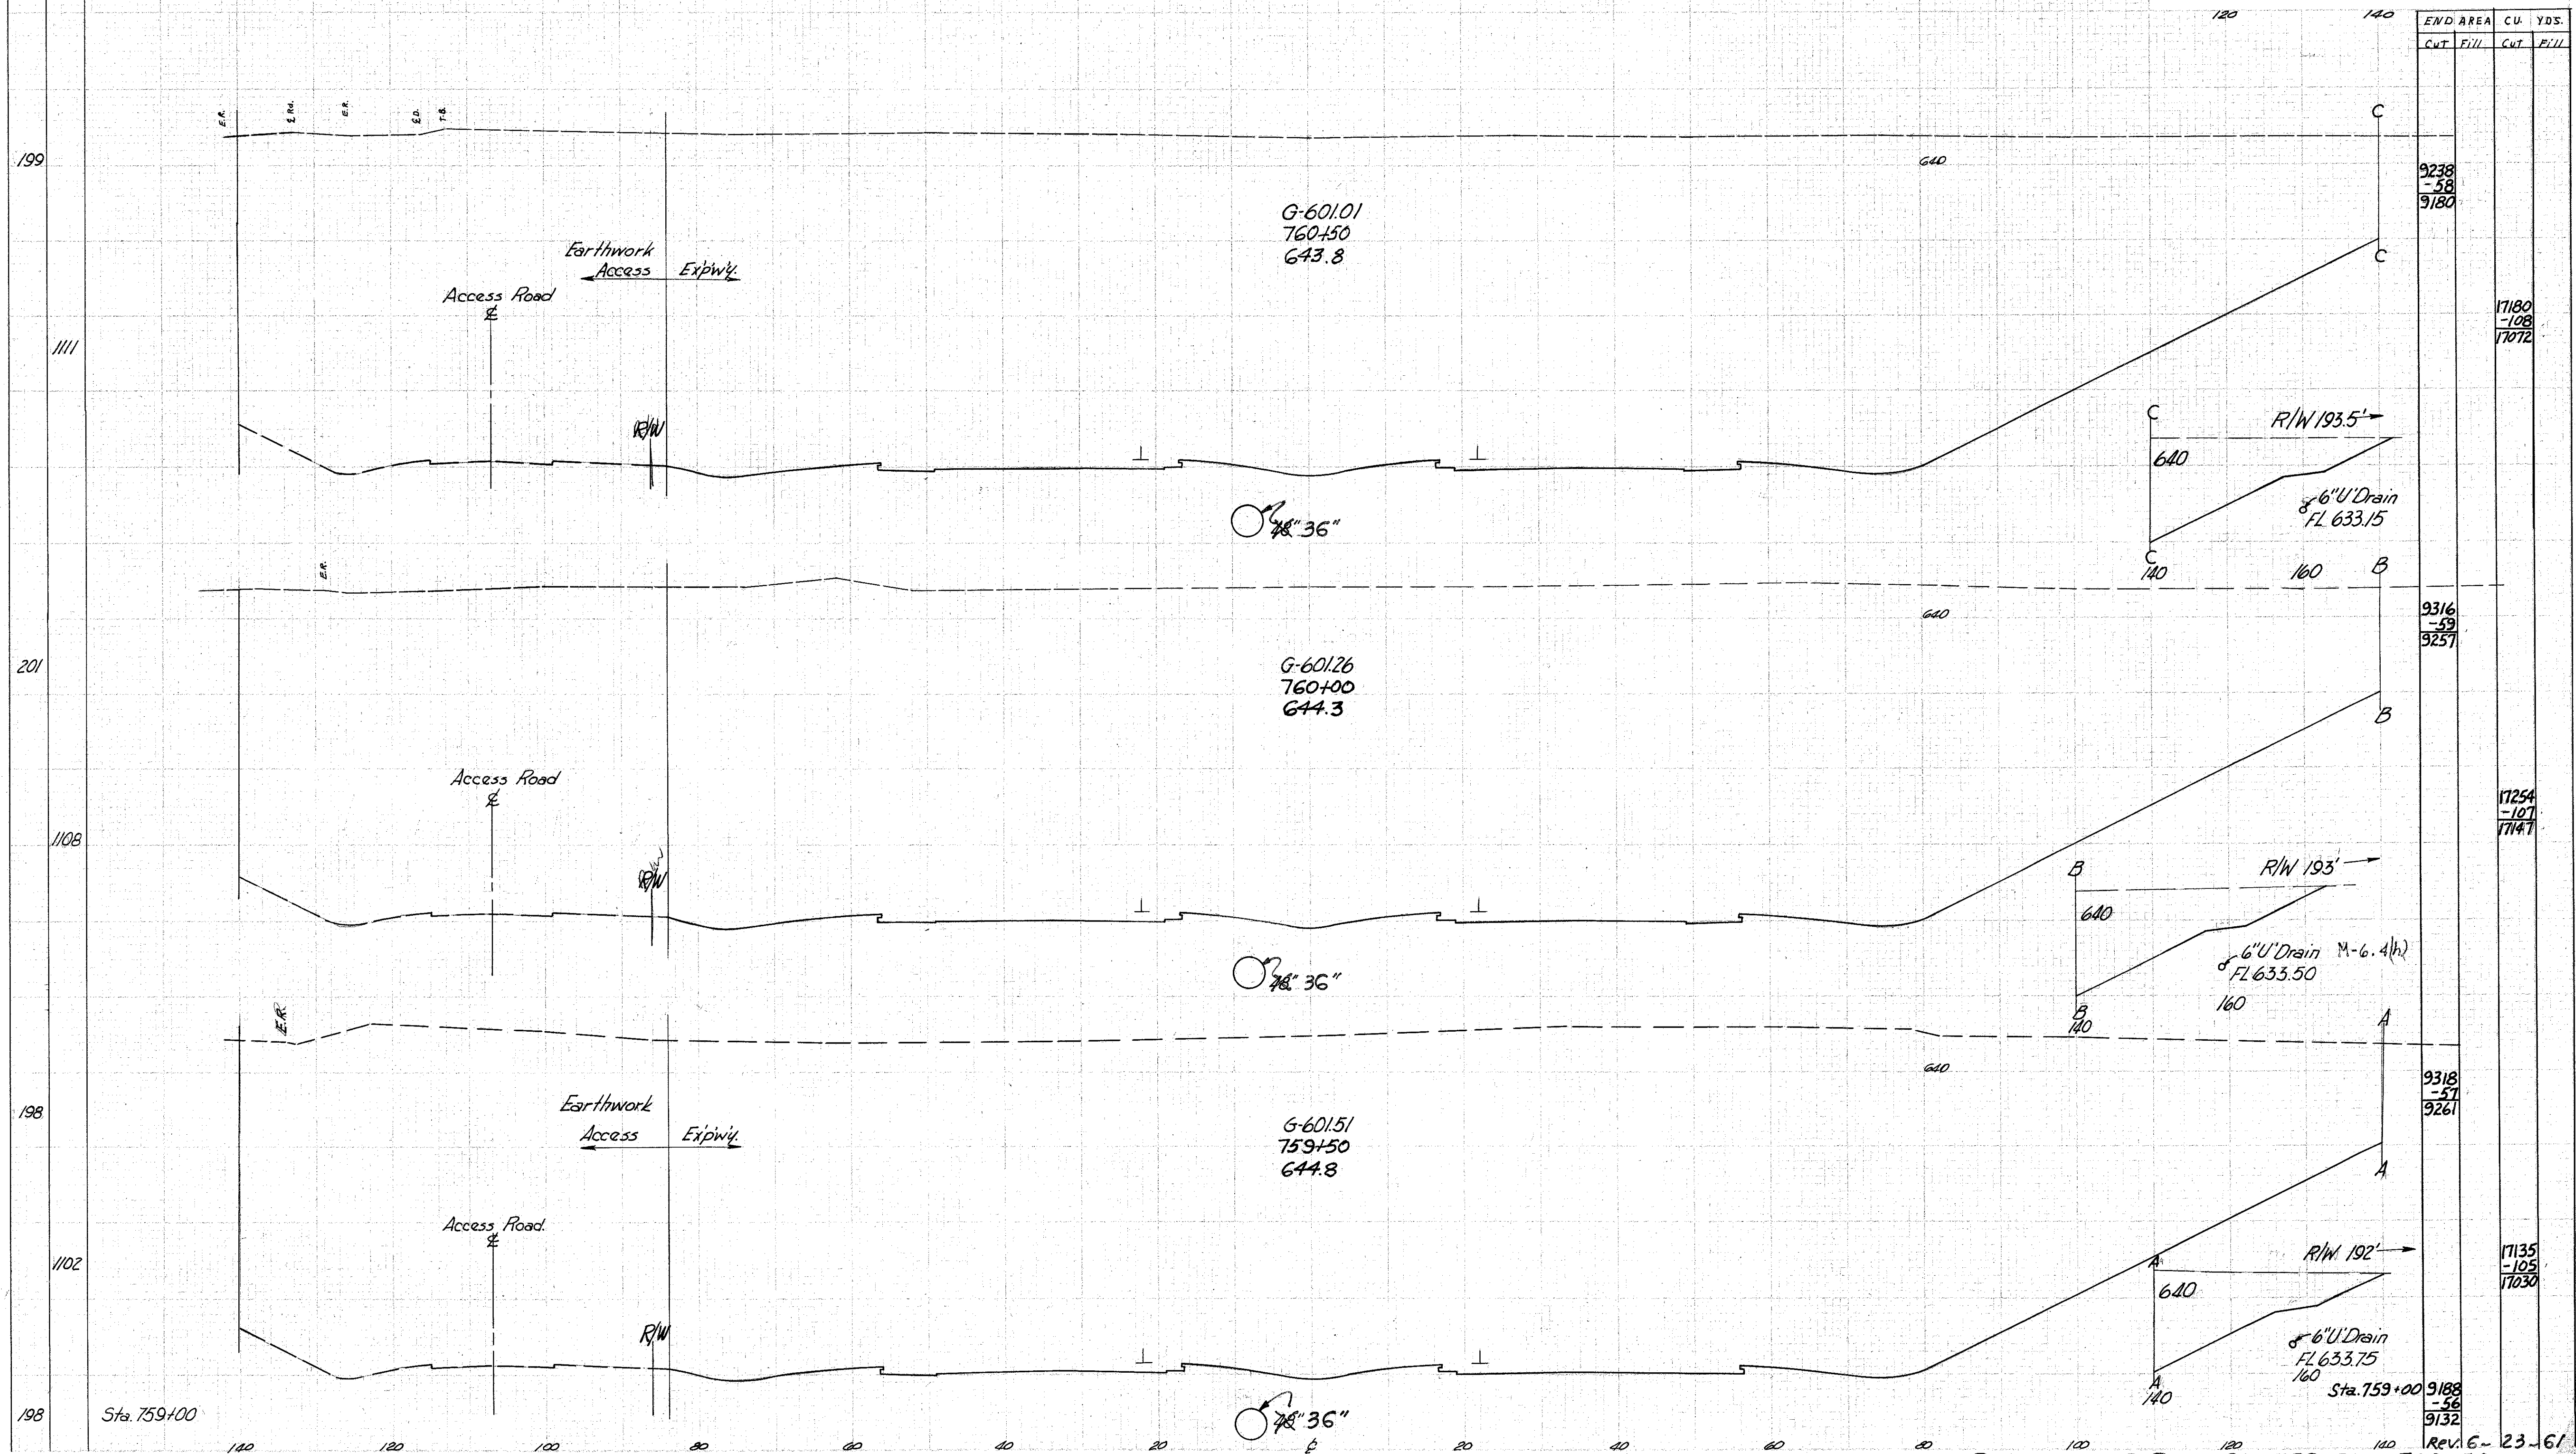

Elev.	END AREA		CU. YDS.	
	CUT	FILL	CUT	FILL
199	9238	-58	17180	-108
201	9316	-59	17254	-107
198	9318	-57	17135	-105
198	9188	-56	17030	-103