


Seeding  
End  
Width  
Sq. Yds.

LAKE COUNTY  
LAK-2-14.22

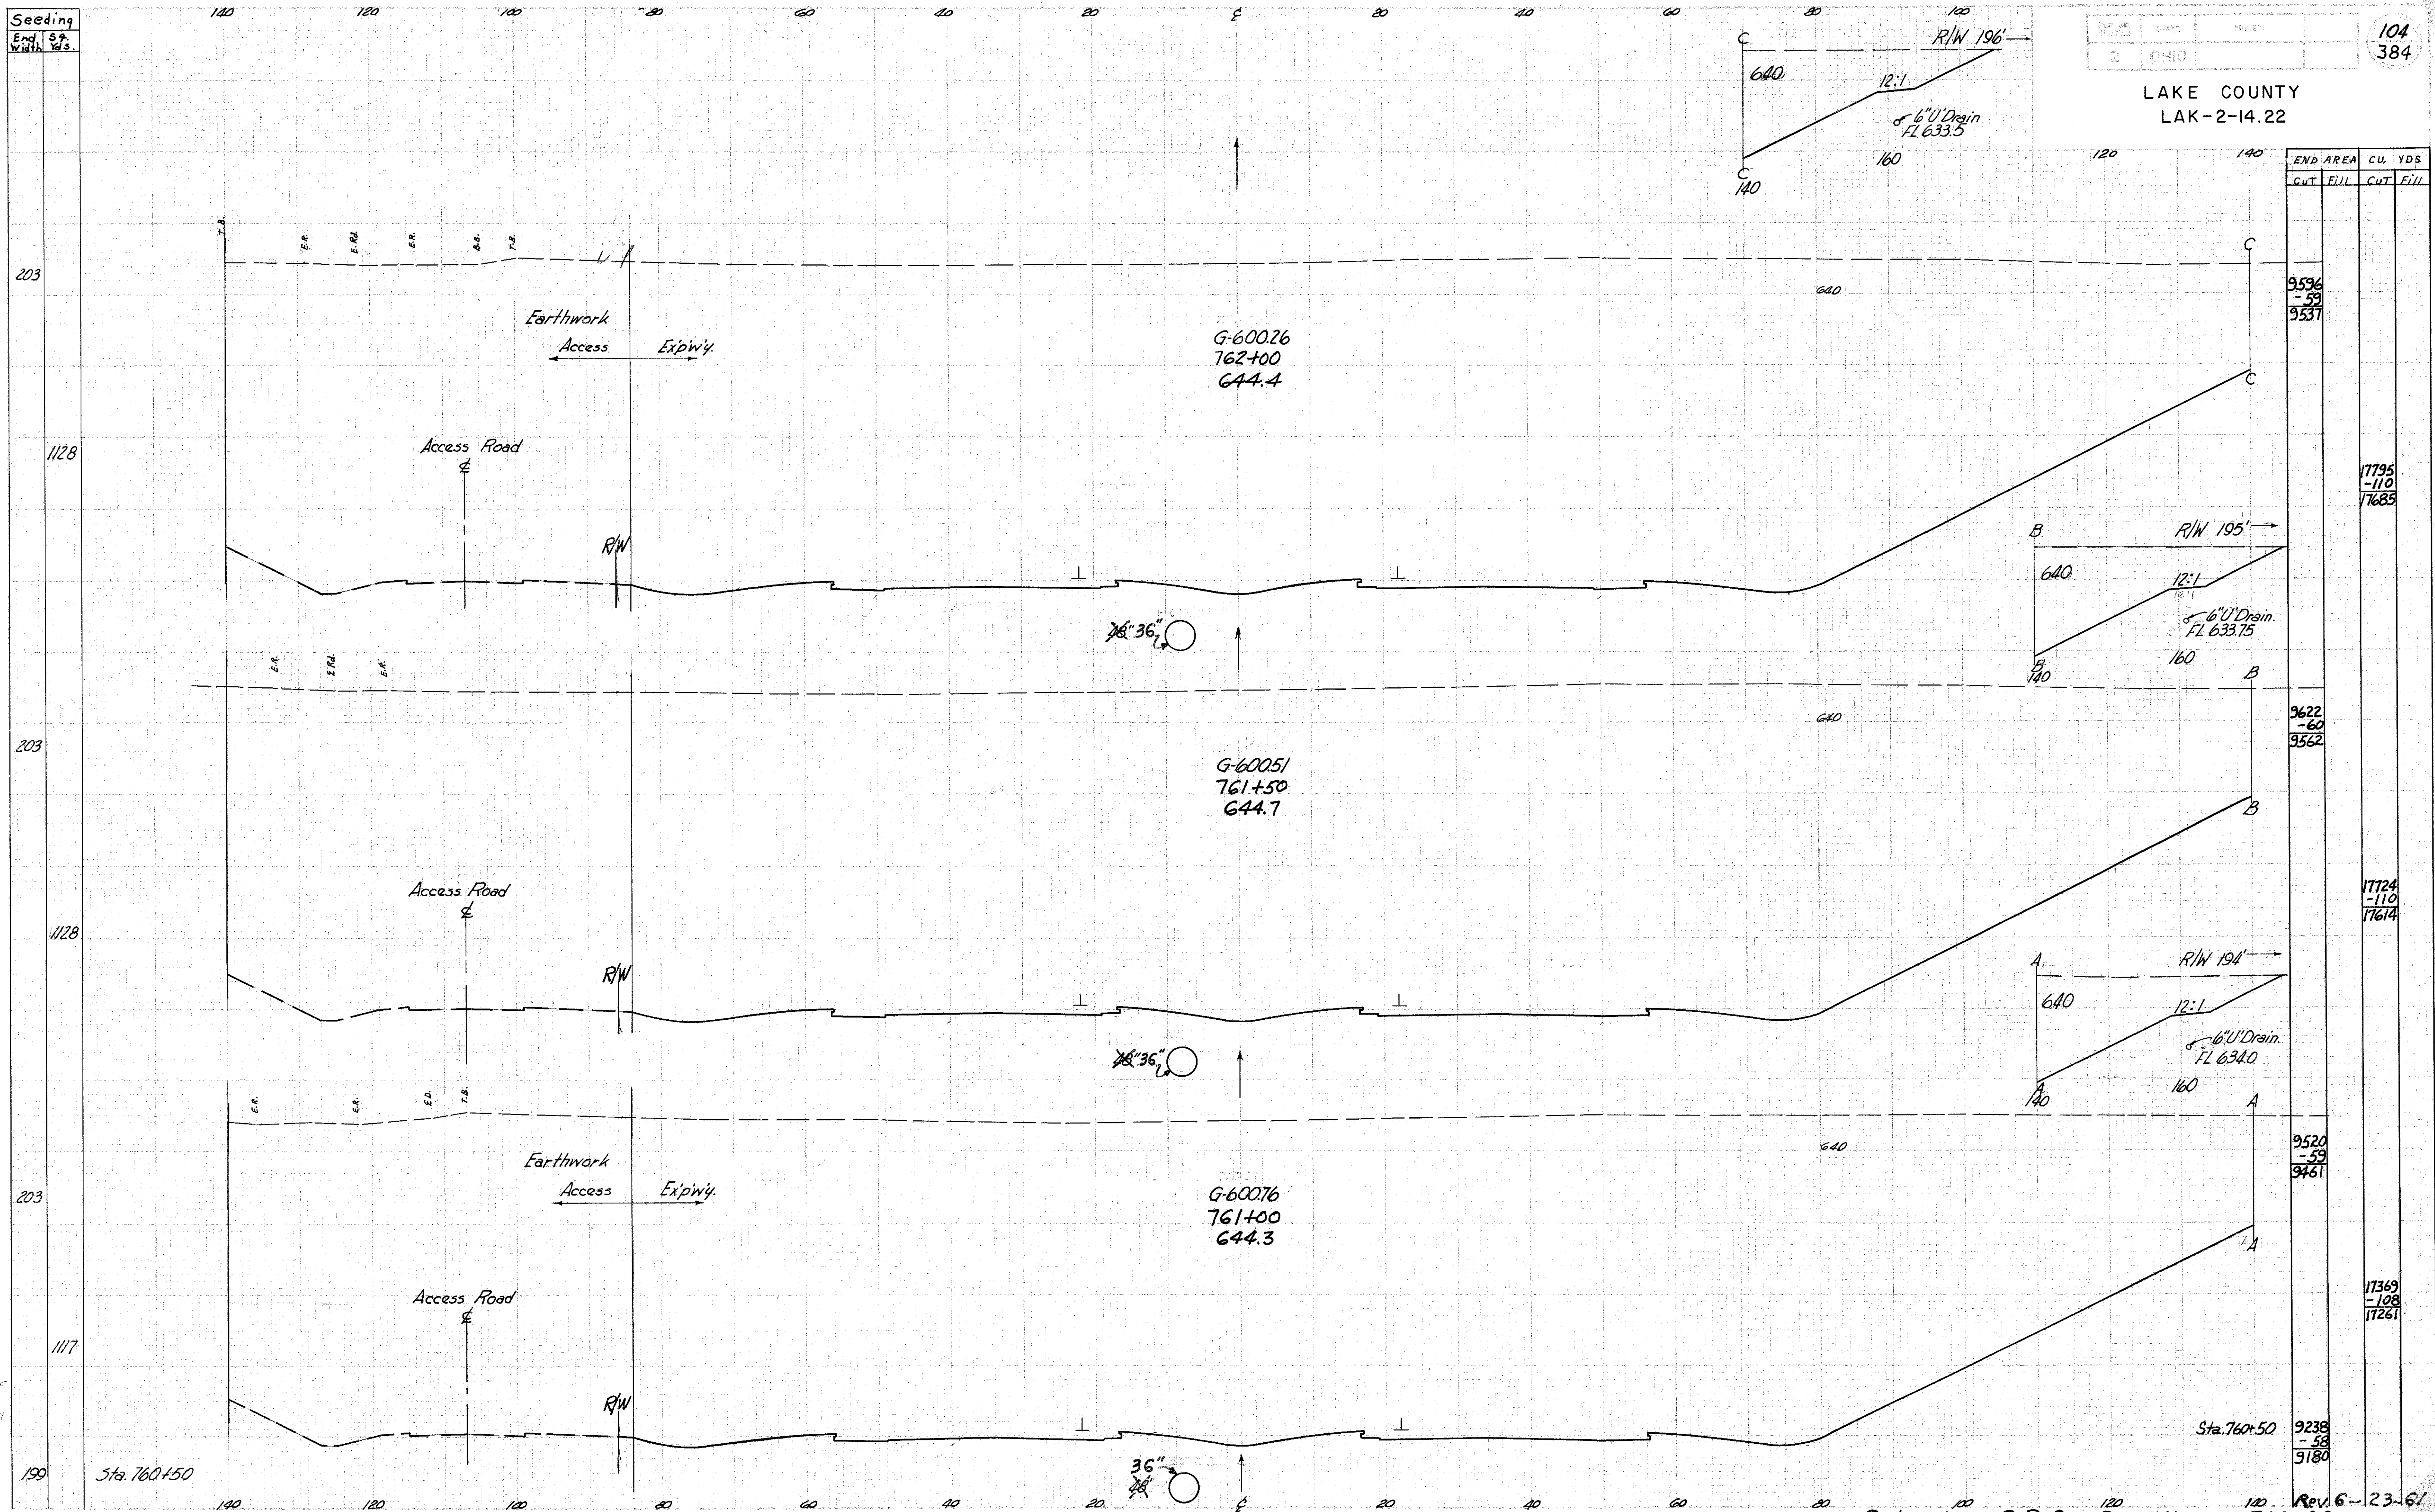

END AREA	CUT	FILL	CU. YDS.
9596			
-59			
9537			

17795
-110
17685

9622
-60
9562

17724
-110
17614

9520
-59
9461

17369
-108
17261

9238
-58
9180

Templates R.F.  
used  
Areas & MF 4/10/01