


Seeding  
End width  
Sq. Yds

LAKE COUNTY  
LAK-2-14.22

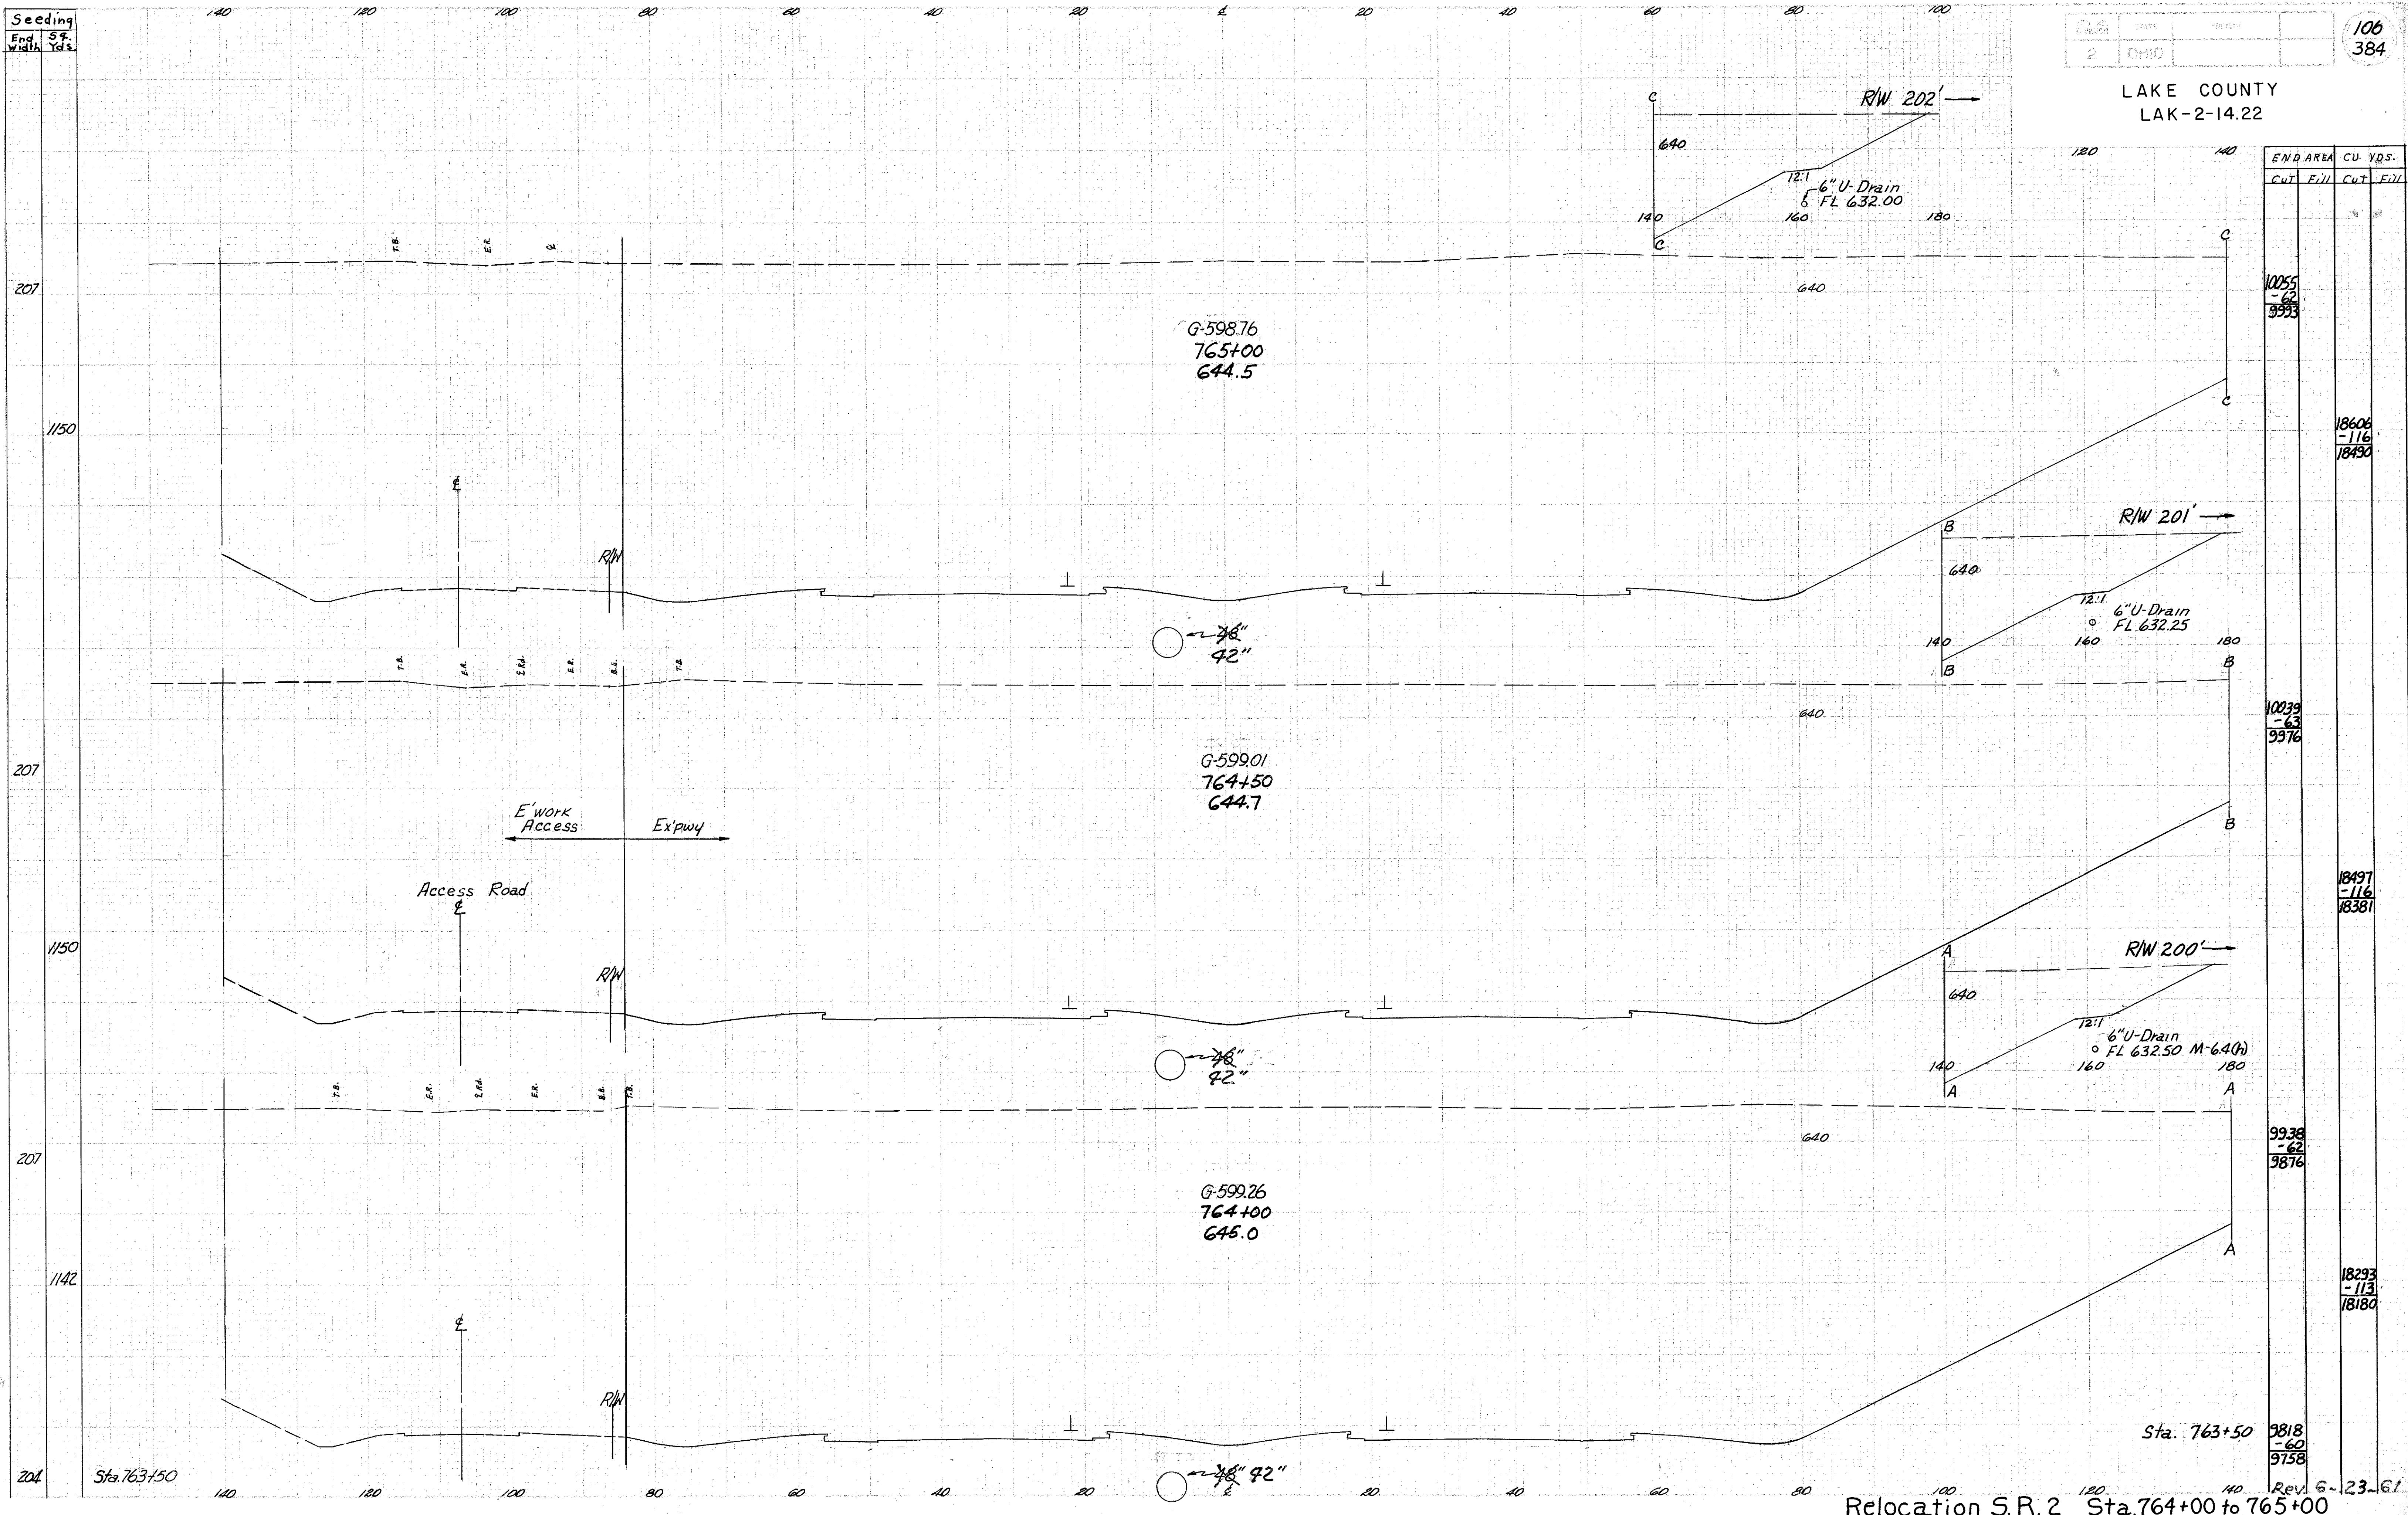

| END AREA |      | CU YDS. |      |
|----------|------|---------|------|
| Cut      | Fill | Cut     | Fill |
| 10055    | 62   | 18606   | 116  |
| 9953     |      | 18490   |      |
| 10039    | 63   | 18497   | 116  |
| 9976     |      | 18381   |      |
| 9938     | 62   | 18293   | 113  |
| 9876     |      | 18180   |      |
| 9818     | 60   |         |      |
| 9758     |      |         |      |

template By RIF  
ms. 4/1/54