
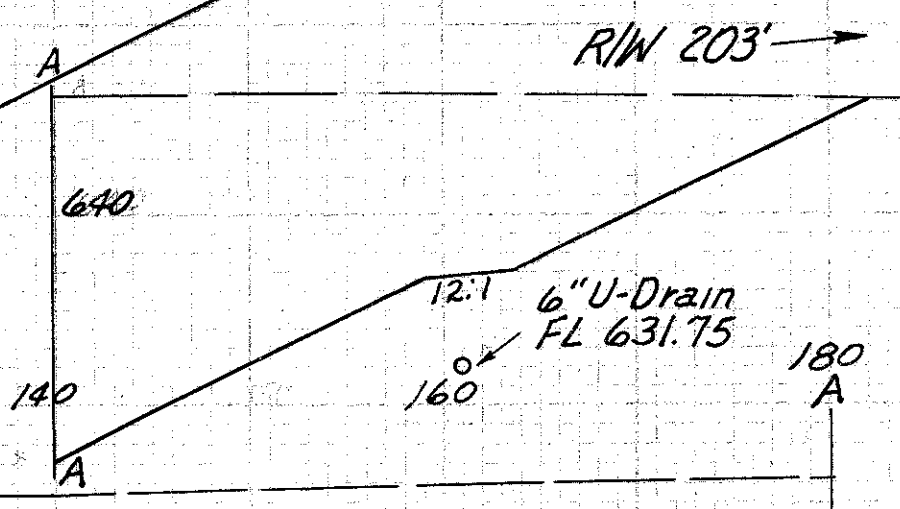
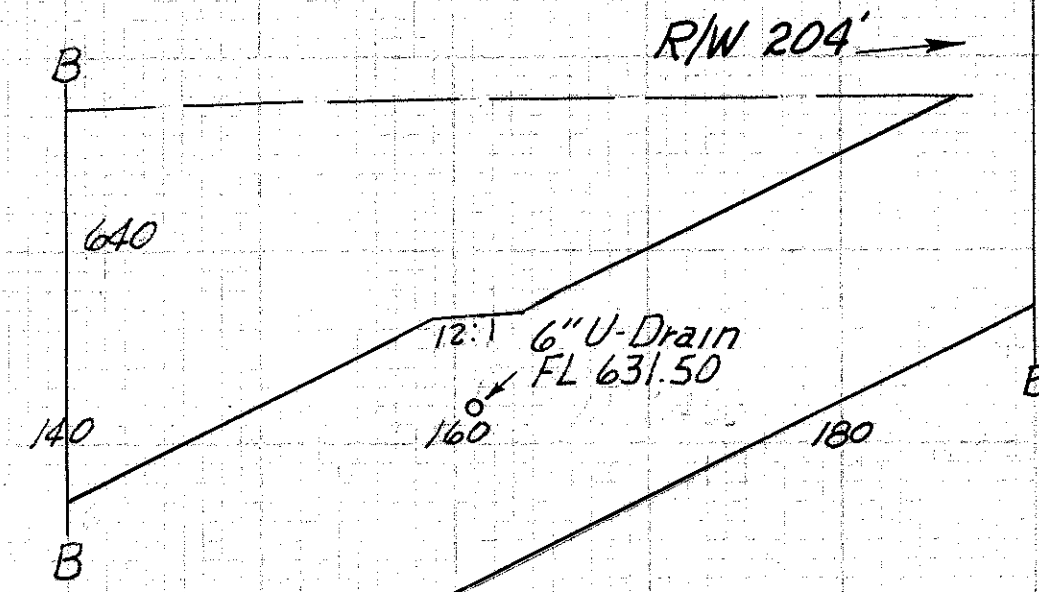
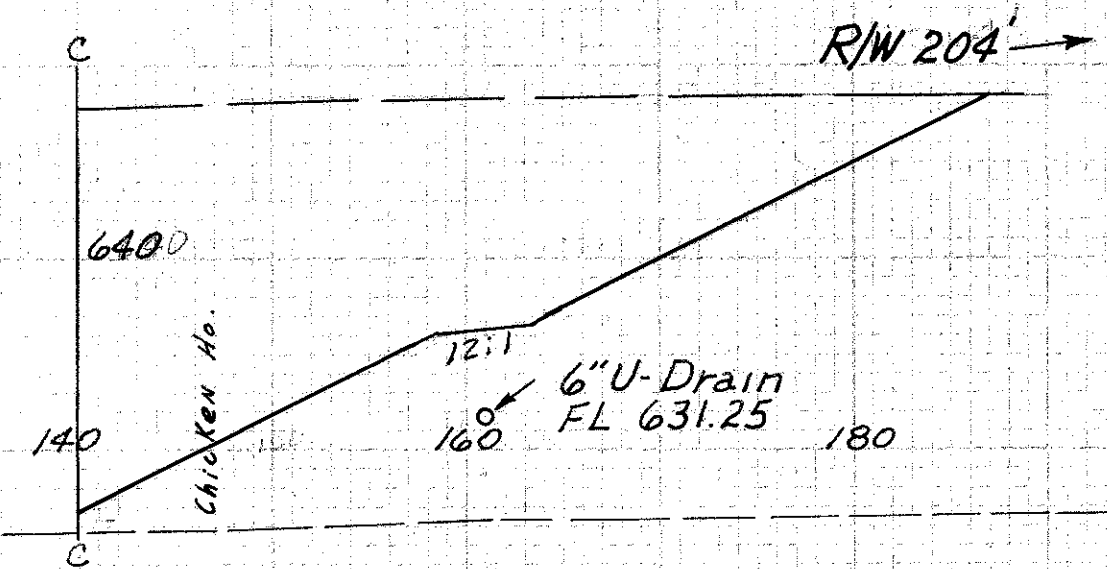


Seeding
End of
width
rd.

LAKE COUNTY
LAK-2-14.22

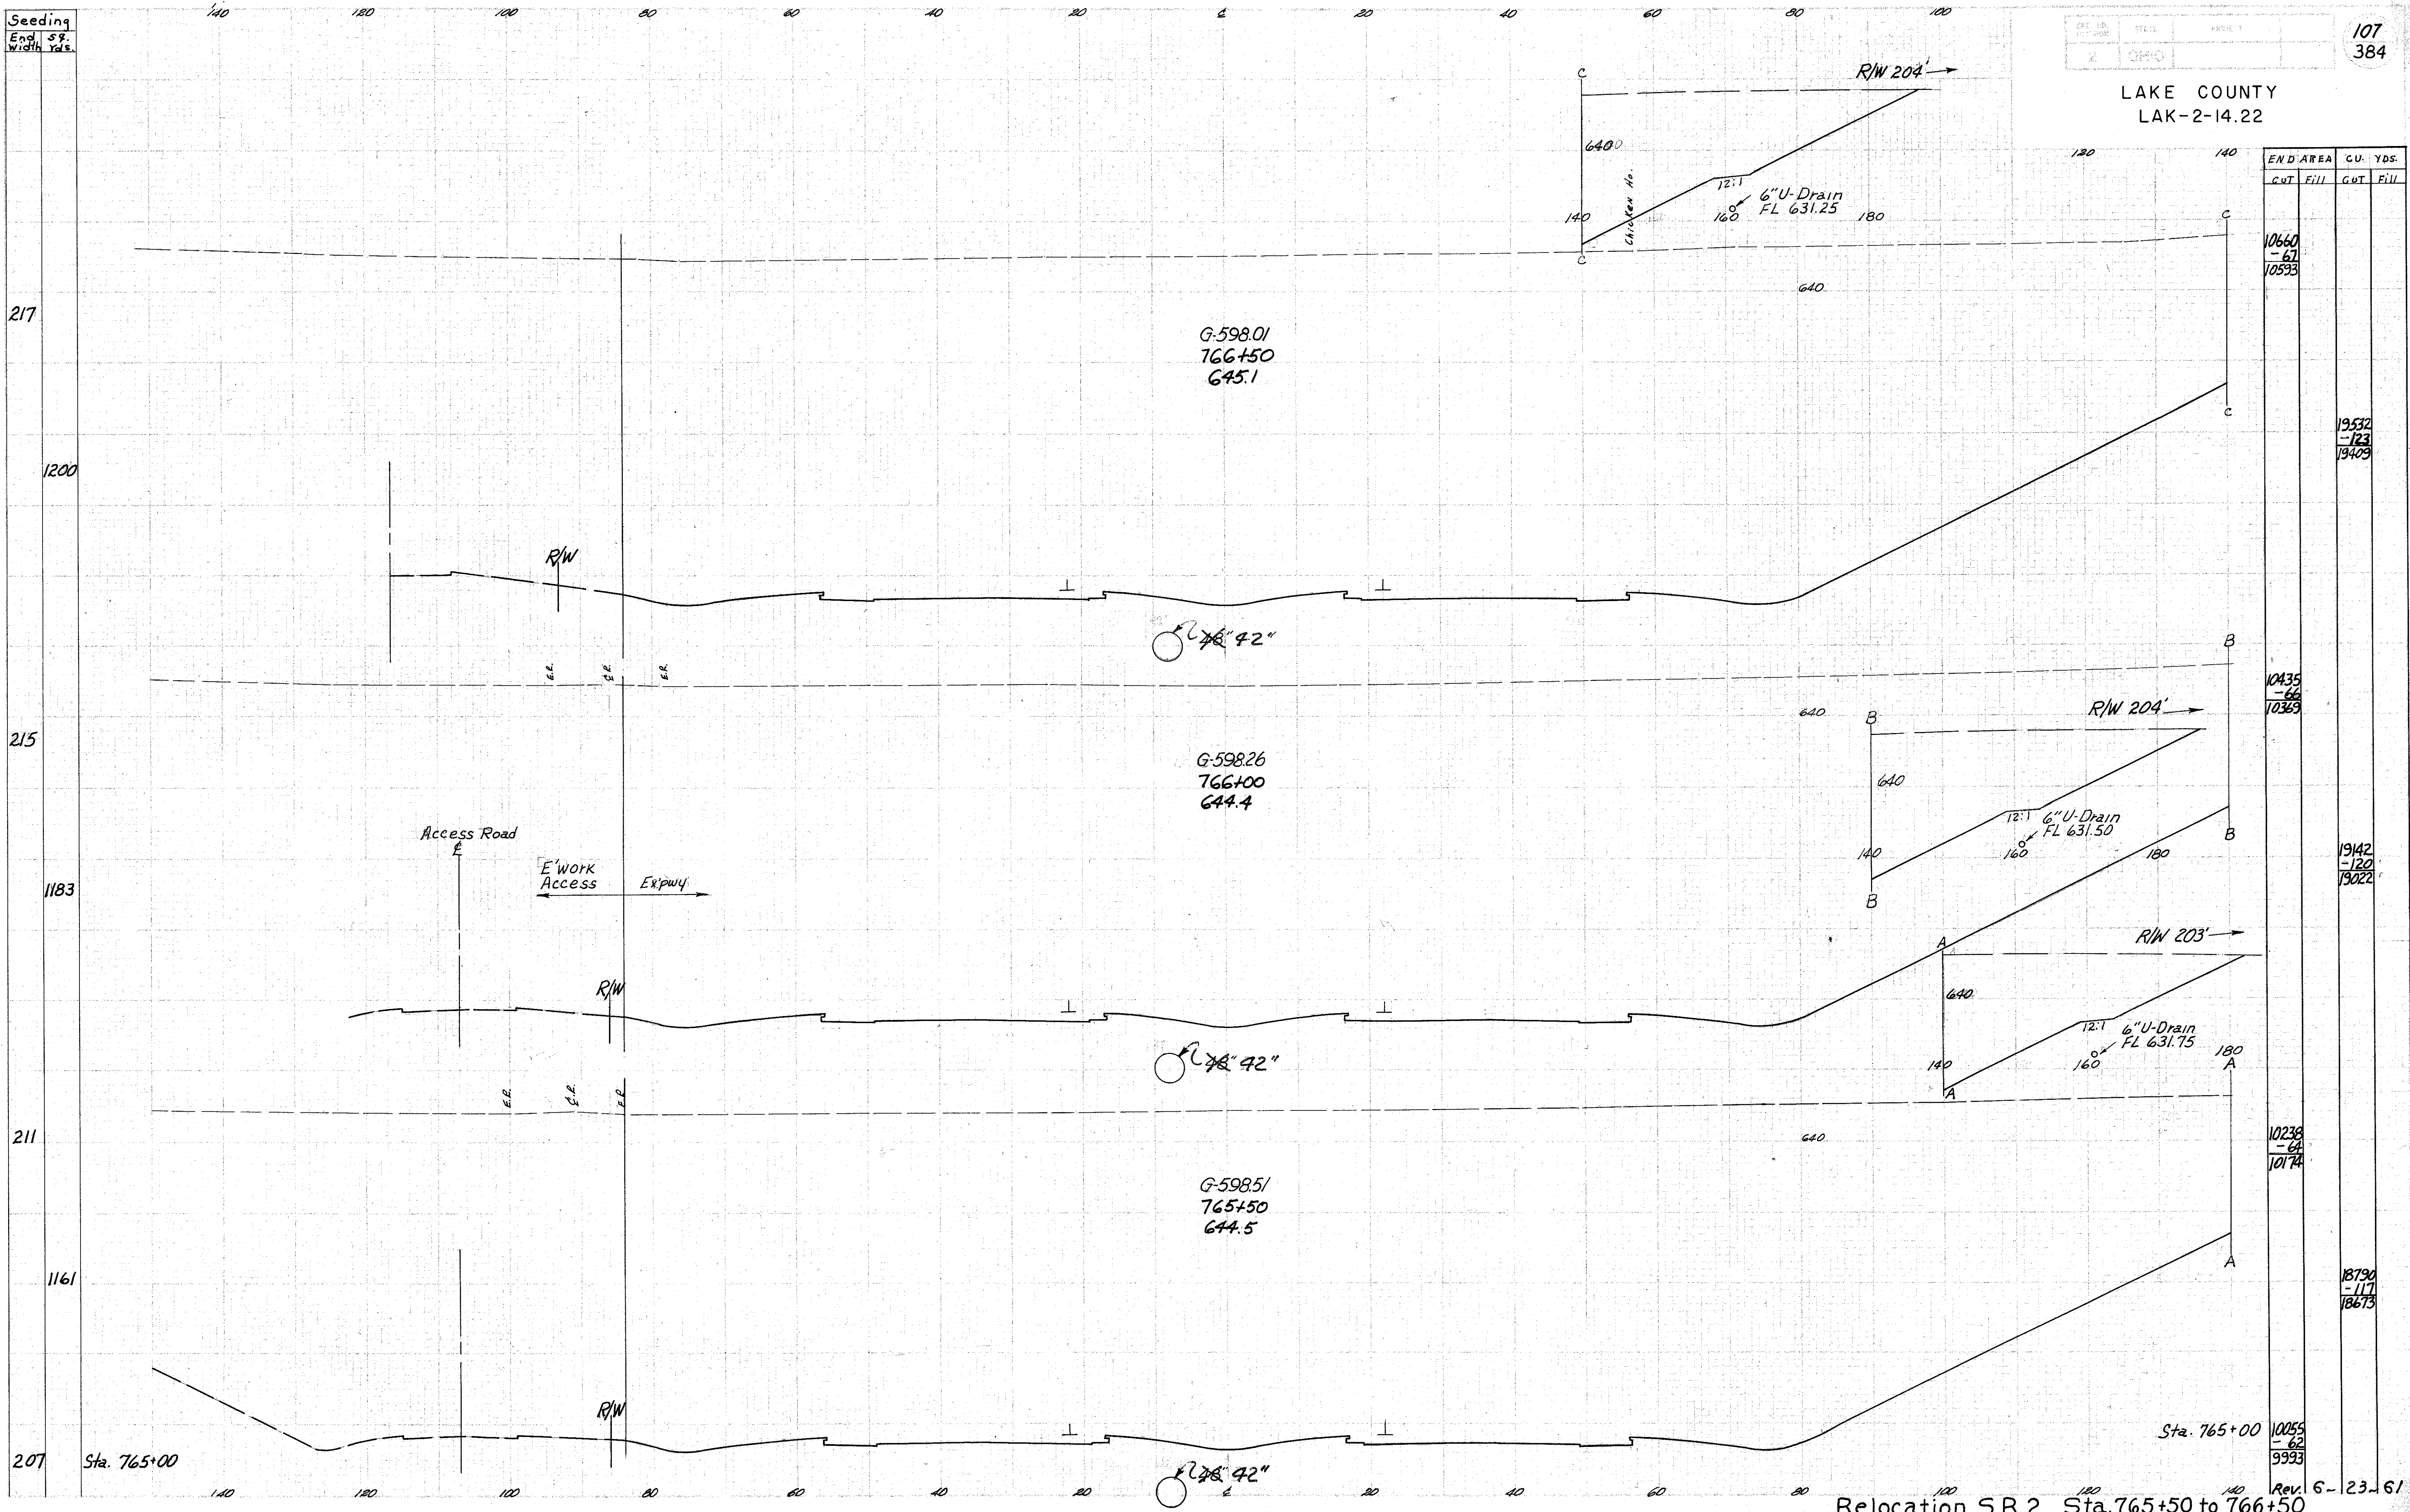

END AREA	CU. YDS.	
	CUT	FILL
10660 -67 10593		
10435 -66 10369		
10238 -64 10174		
10055 -62 9993		