FED. RD. DIV.	STATE	PROJECT	
2	OHIO		

109
384

LAKE COUNTY
LAK-2-14.22

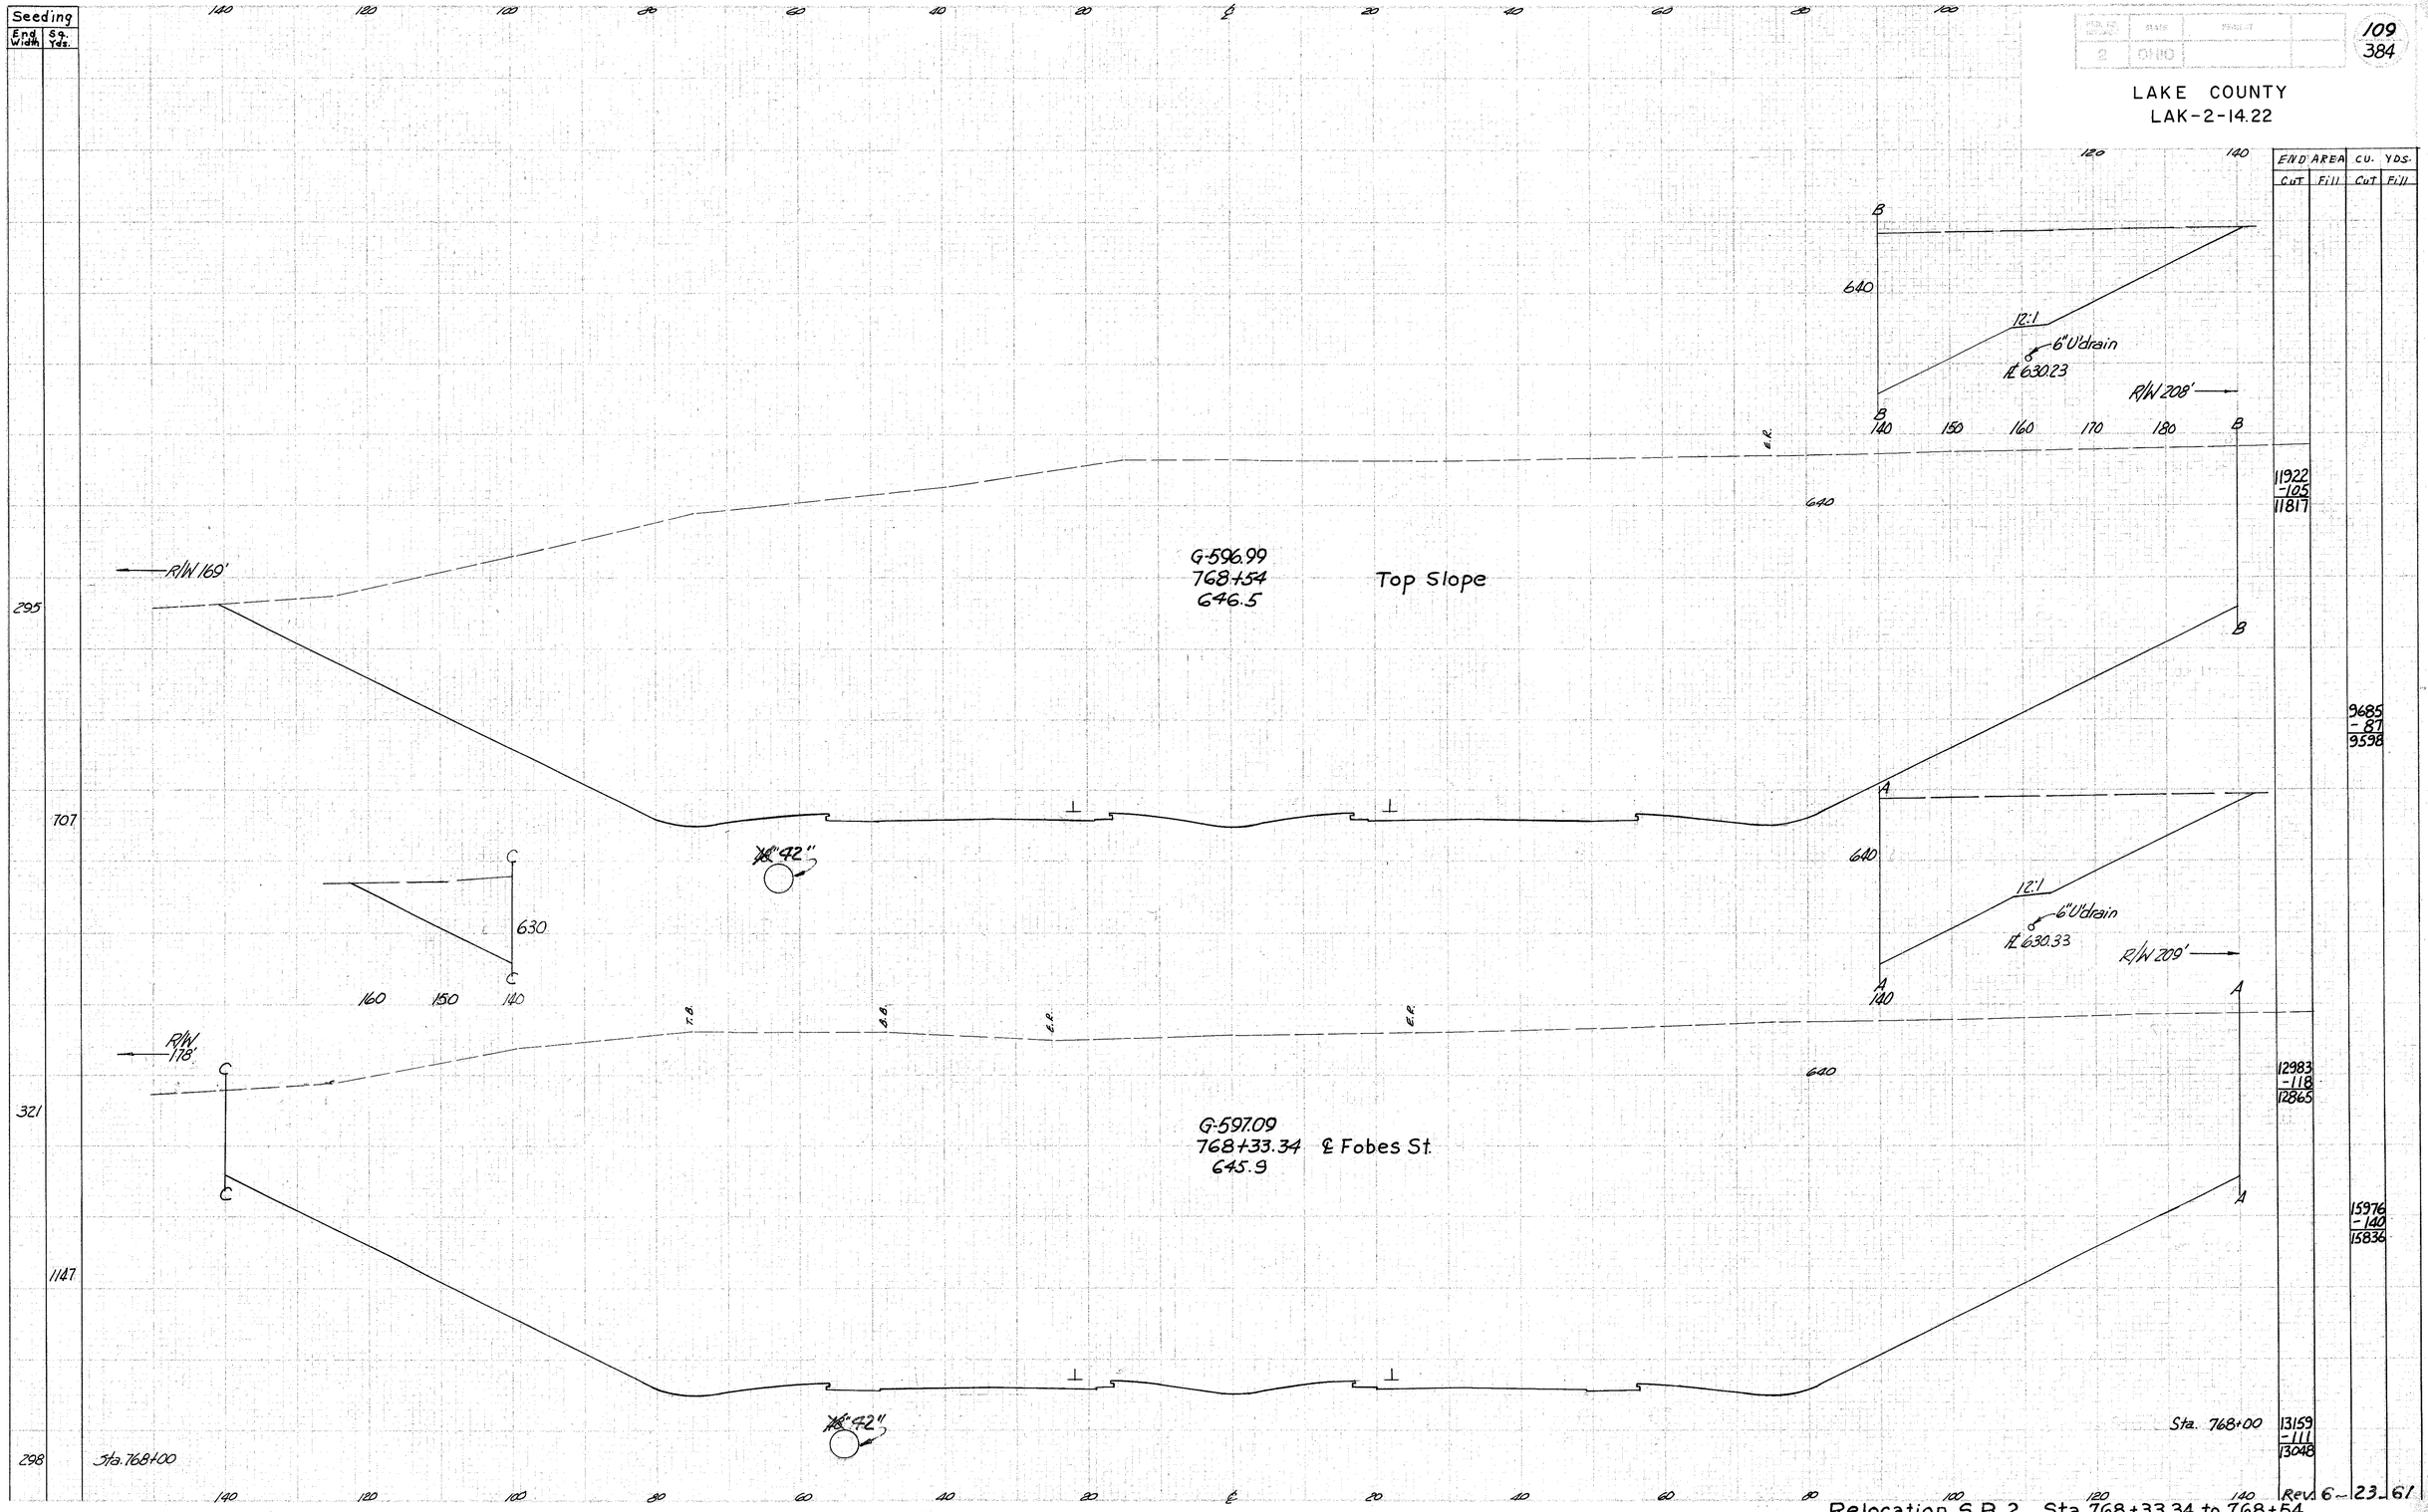

END AREA Cut	END AREA Fill	CU. YDS. Cut	CU. YDS. Fill
11922			
-105			
11817			
		9685	
		-87	
		9598	
12983			
-118			
12865			
		15976	
		-140	
		15836	
13159			
-111			
13048			

Rev. 6-23-61

Relocation S.R. 2 Sta. 768+33.34 to 768+54