

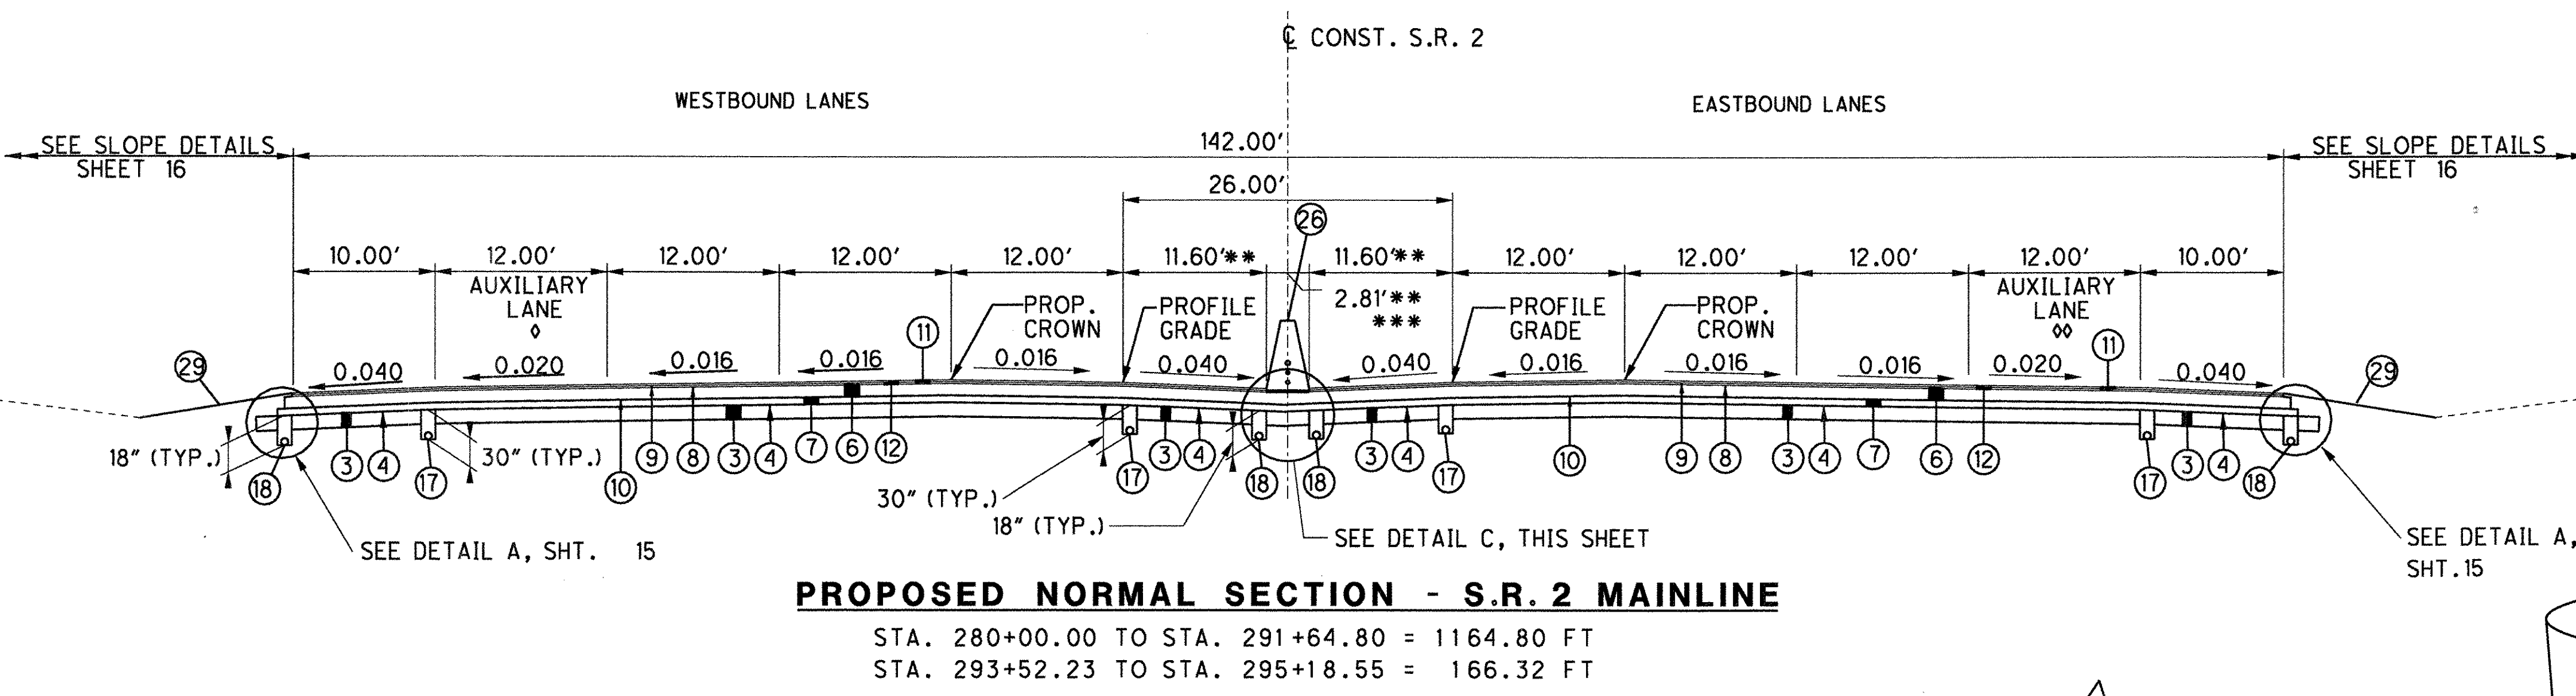
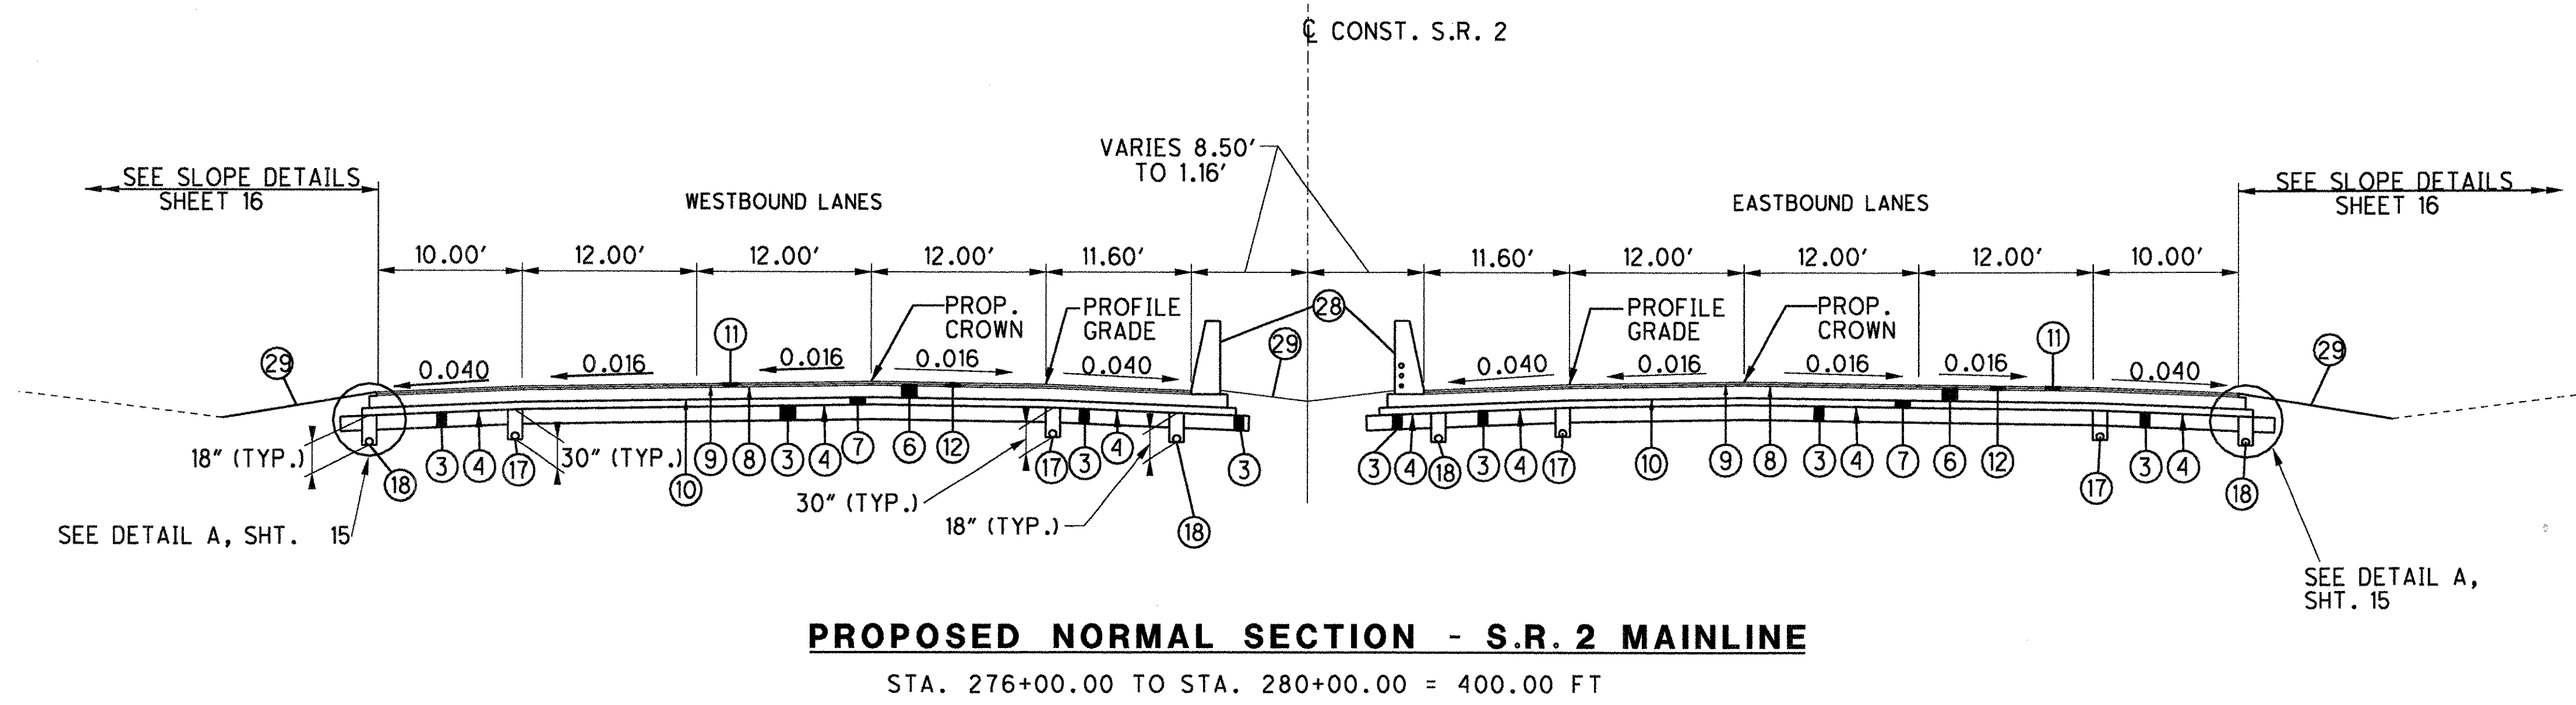


LEGEND

- ① ITEM 202 PAVEMENT REMOVED
- ② ITEM 204 SUBGRADE COMPACTION
- ③ ITEM 206 12" CEMENT STABILIZED SUBGRADE
- ④ ITEM 206 CURING COAT
- ⑤ ITEM 254 PAVEMENT PLANING, ASPHALT CONCRETE (3" MAX)
- ⑥ ITEM 302 10" ASPHALT CONCRETE BASE
- ⑦ ITEM 304 6" AGGREGATE BASE
- ⑧ ITEM 407 TACK COAT @ 0.10 GAL./SY
- ⑨ ITEM 407 TACK COAT FOR INTERMEDIATE COURSE @ 0.05 GAL./SY
- ⑩ ITEM 408 PRIME COAT @ 0.40 GAL./SY
- ⑪ ITEM 442 1.5" ASPHALT CONCRETE SURFACE COURSE, 12.5MM TYPE A (446)
- ⑫ ITEM 442 1.75" ASPHALT CONCRETE INTERMEDIATE COURSE, 19.0 MM TYPE A (446)
- ⑬ ITEM 446 1.75" ASPHALT CONCRETE INTERMEDIATE COURSE, TYPE 2, PG64-22
- ⑭ ITEM 448 1.25" ASPHALT CONCRETE SURFACE COURSE TYPE 1, PG64-22
- ⑮ ITEM 448 3" ASPHALT CONCRETE, INTERMEDIATE COURSE, TYPE 1, PG64-22, UNDER GUARDRAIL, AS PER PLAN
- ⑯ ITEM 451 9" REINFORCED CONCRETE PAVEMENT
- ⑰ ITEM 605 6" SHALLOW PIPE UNDERDRAIN WITH FABRIC WRAP
- ⑱ ITEM 605 6" BASE PIPE UNDERDRAIN WITH FABRIC WRAP
- ⑲ ITEM 606 NOISE BARRIER (ABSORPTIVE), OVER 10' TO 14' & OVER 14' TO 20' HEIGHT
- ⑳ ITEM 606 NOISE BARRIER MISC: READY FIT CLEAR PANEL
- ㉑ ITEM 606 GUARDRAIL, TYPE 5
- ㉒ ITEM 608 4" CONCRETE WALK
- ㉓ ITEM 609 COMBINATION CURB AND GUTTER, TYPE 2
- ㉔ ITEM 609 CURB, TYPE 2-A
- ㉕ ITEM 609 CURB, TYPE 6
- ㉖ ITEM 622 CONCRETE BARRIER, SINGLE SLOPE, TYPE B1
- ㉗ ITEM 622 CONCRETE BARRIER, SINGLE SLOPE, TYPE B, AS PER PLAN
- ㉘ ITEM 622 CONCRETE BARRIER, SINGLE SLOPED, TYPE D
- ㉙ ITEM 659 SEEDING AND MULCHING
- ㉚ ITEM 609 6" CONCRETE TRAFFIC ISLAND
- ㉛ ITEM 452 8" NON-REINFORCED CONCRETE PAVEMENT
- ㉜ ITEM 609 9" CONCRETE TRAFFIC MEDIAN
- ㉝ ITEM 209 LINEAR GRADING, AS PER PLAN
- ㉞ ITEM 511 1.25" CLASS S CONCRETE, BRIDGE DECK

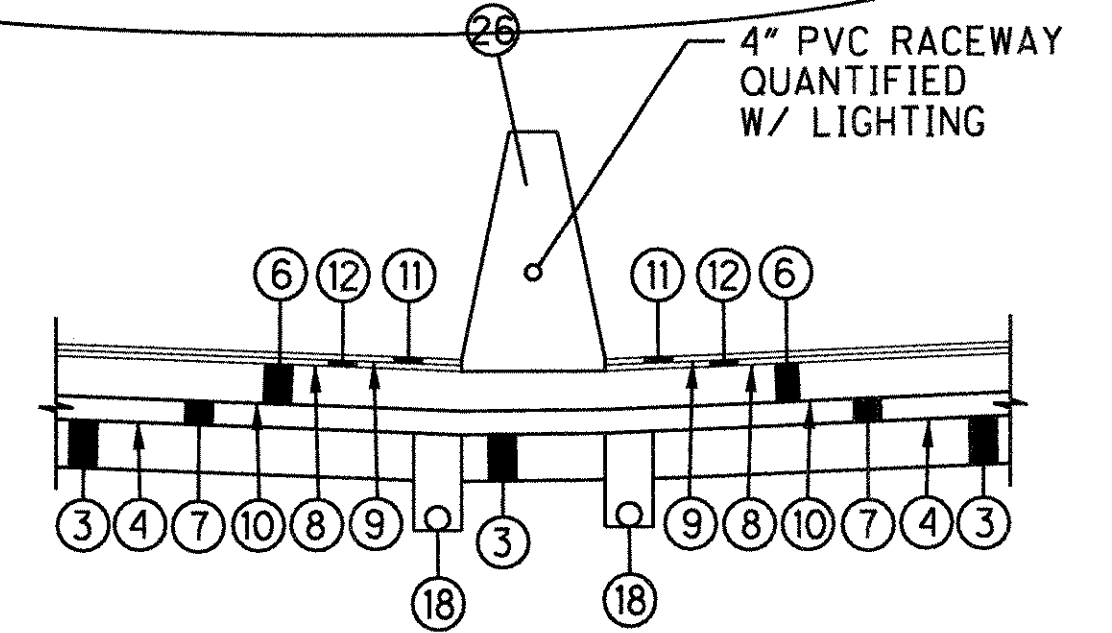

REVISION 01/13/09:
ADDED ITEM 511

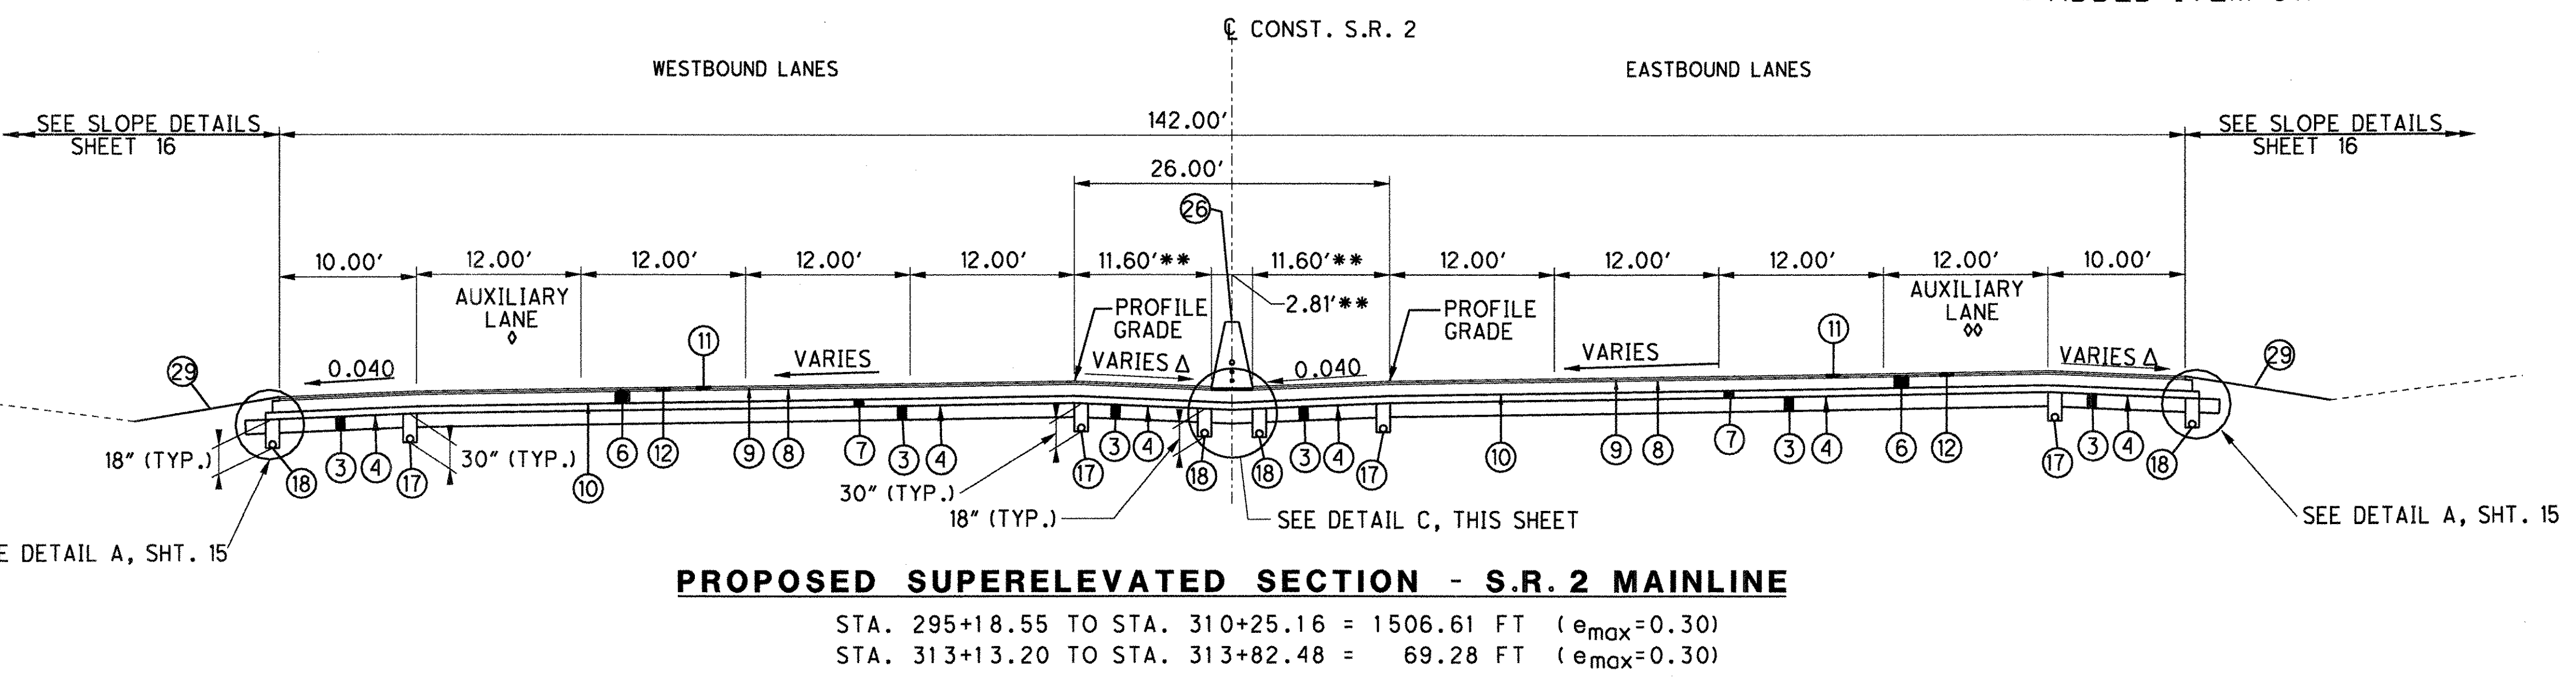

- ** MEDIAN BARRIER TAPERS FROM 33 3/4" TO 41 1/2" OVER 10' SECTION ABUTTING TO MAINLINE BRIDGES, PIERS, AND OVERHEAD SIGN SUPPORTS. LOCATIONS AS DETAILED IN PLAN SHEETS.
- *** BARRIER TRANSITIONS FROM SEPARATE LEFT AND RIGHT TYPE D BARRIERS TO A SINGLE TYPE B1 BARRIER. TYPE B1 BARRIER WIDTH VARIES 5.64' TO 2.81', STA. 280+00.00 TO STA. 281+08.75
- Δ FOR HIGH SIDE SHOULDER SLOPES AND BREAK LOCATION ON SUPERELEVATED SECTIONS, SEE SHOULDER DETAILS, SHEET 16
- ◇ AUXILIARY LANE STA. 284+38.98 TO STA. 289+70.00
- ◇◇ AUXILIARY LANE STA. 285+28.99 TO STA. 297+49.23

TYPICAL SECTIONS - S.R. 2 MAINLINE

LAK-2-3.32

G:\Project\lak\13486\roadway\sheet\13486GYP01.dgn 1/13/2009 4:05:02 PM PBerdis