

NOT TO SCALE

CALCULATED  
TRR  
CHECKED  
MAH


SOM CENTER RD. (S.R. 91) RAMPS A & B - DETOUR PLAN  
CONSTRUCTION STAGE 3 PHASE B

LAK-2-3.32

175  
1679



- NOTES:
1. THE CLOSURE OF THE S.R. 91 RAMPS SHALL NOT EXCEED ~~THIRTY (30)~~ **FORTY-FIVE (45)** CALENDAR DAYS
  2. NO CONSECUTIVE RAMPS IN THE EASTBOUND OR WESTBOUND DIRECTION SHALL BE CLOSED AT THE SAME TIME.
  3. RAMP CLOSURES SHALL BE AS STD. DWG. MT-98.29 AND MT-101.60
  4. DETOUR SIGNING LOCATIONS SHALL BE AS PER OMTCD
  5. ALL SIGNS FOR THE S.R. 91 INTERCHANGE SHALL BE OVERLAYED WITH A CLOSED PLAQUE WHEN THE DETOUR IS IN EFFECT
  6. WHENEVER THE CLOSURE OCCURS, THE TOTAL DETOUR SIGNING AS INDICATED ON THIS PLAN SHALL BE IMPLEMENTED
  7. DETOUR SIGNS SHALL BE UNCOVERED AND VISIBLE TO TRAFFIC ONLY WHEN THE RAMP CLOSURE IS IN EFFECT

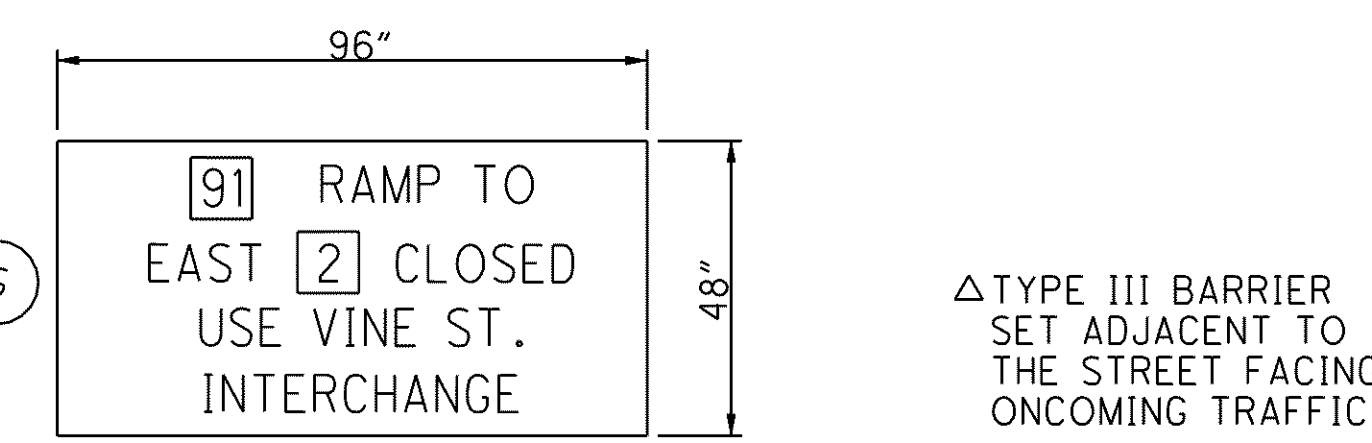

LEGEND	
⊢/⊣	SIGN
⊢	TYPE III BARRICADE
▨	WORK AREA
—	DETOUR ROUTE

(A)	(B)	(C)	(D)	(E)	(F)	(G)	(H)	(I)
(J)	(K)	(L)	(M)	(N)	(O)	(P)	(Q)	(R)

\\Akrn01\Data\Civil\2004108\00\13486\mot\sheet\13486MD01.dgn 6/16/2008 7:43:40 AM svarrecchia