



VINE STREET
PART

AUTHORIZATION ORDER NO. 6269620

KEY MAP


#60

CITY OF WILLOUGHBY SHEETS ATT: #60
EXCHANGE C: WLGHOBY AREA NO. 26207 DISTRICT
LOCATION: VINE ST AT E. 365 TH ST

PREPARED BY: _____ DATE: _____
TELE NO: _____

APPROVED BY: _____ DATE: _____

KEY MAP - NO SCALE

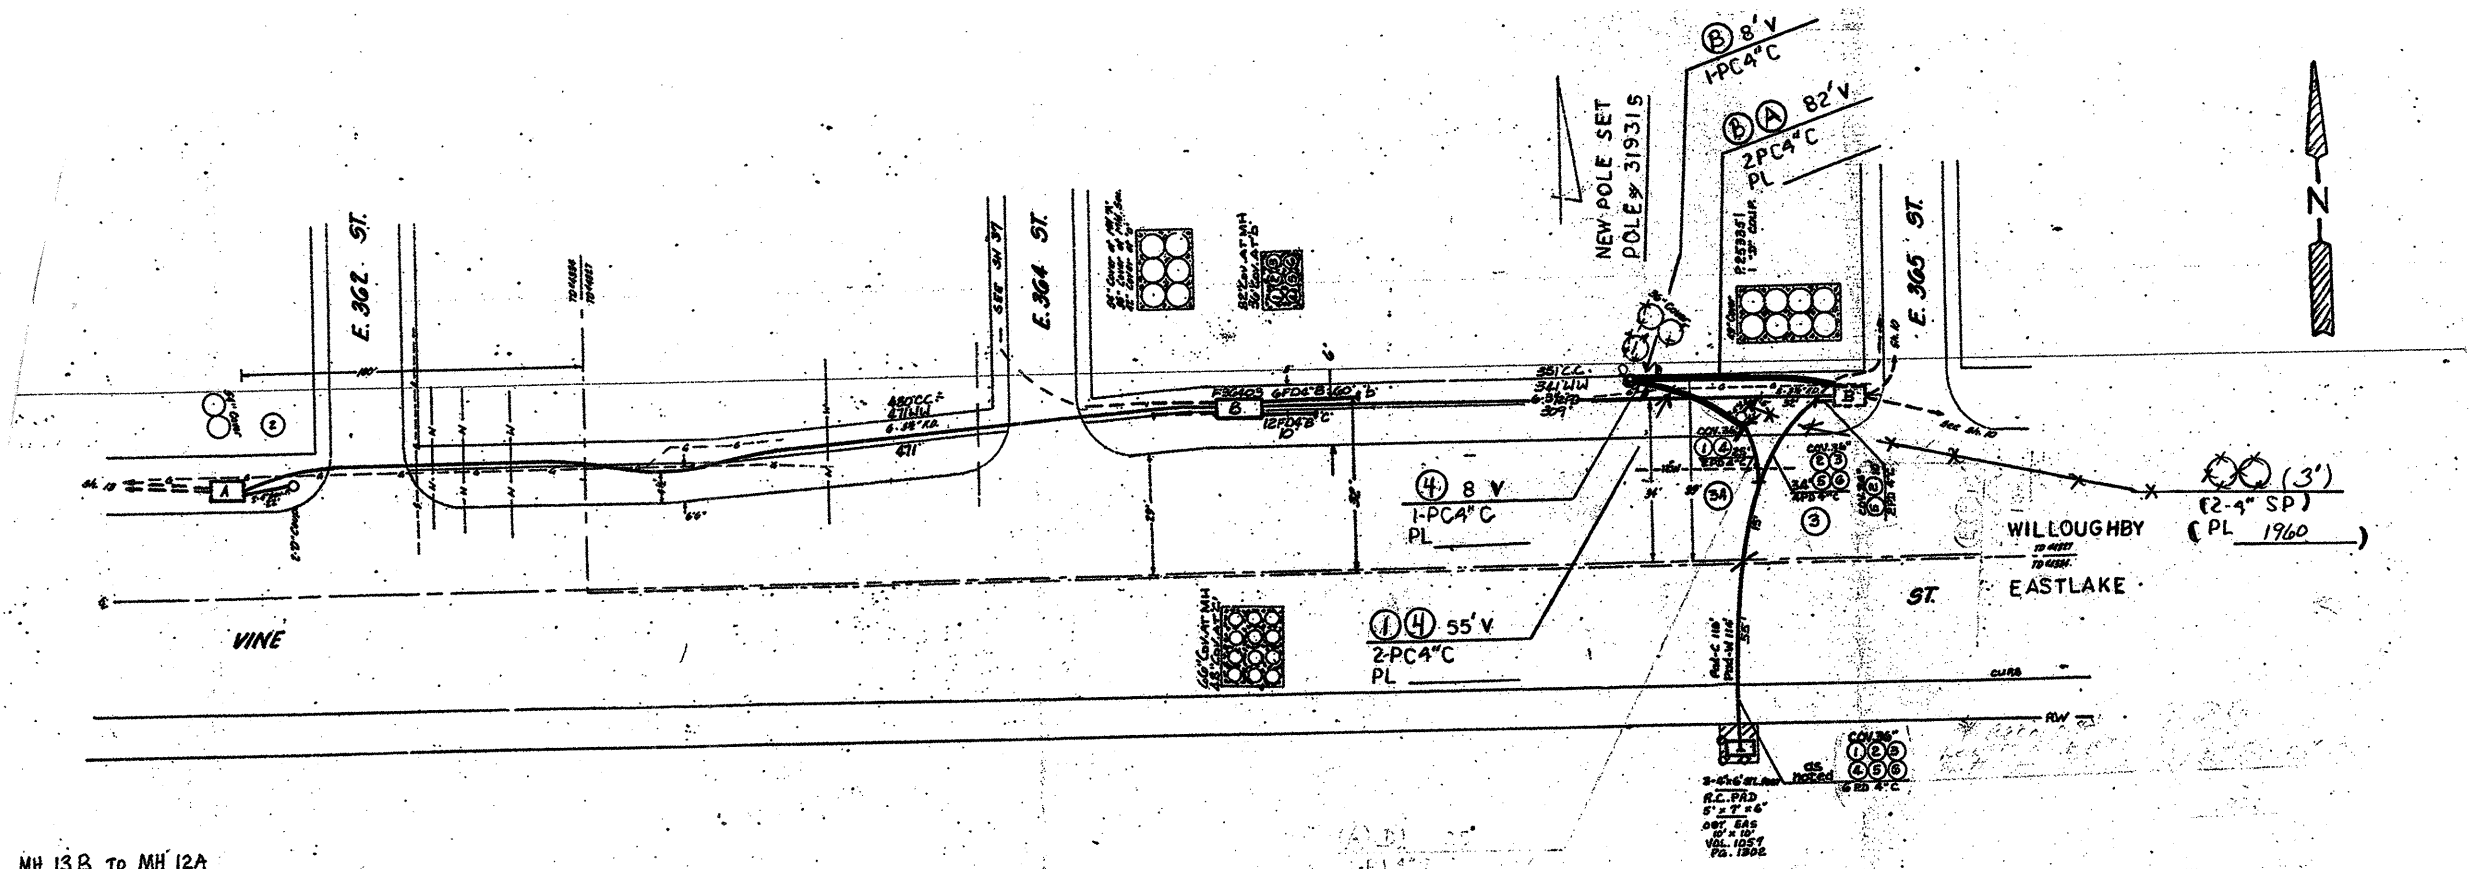

MH 13B TO MH 12A
W-W 470'
D-C 480'

MH-12-B TO POLE # 319315
W-P 90' V
C-P 96' V

X-BOX F.36542 TO POLE 319315
X-BOX-P 158' V