



TYPE E ANCHOR ASSEMBLY - PLAN, ELEVATION, & SECTIONS
 OPTION 'B'

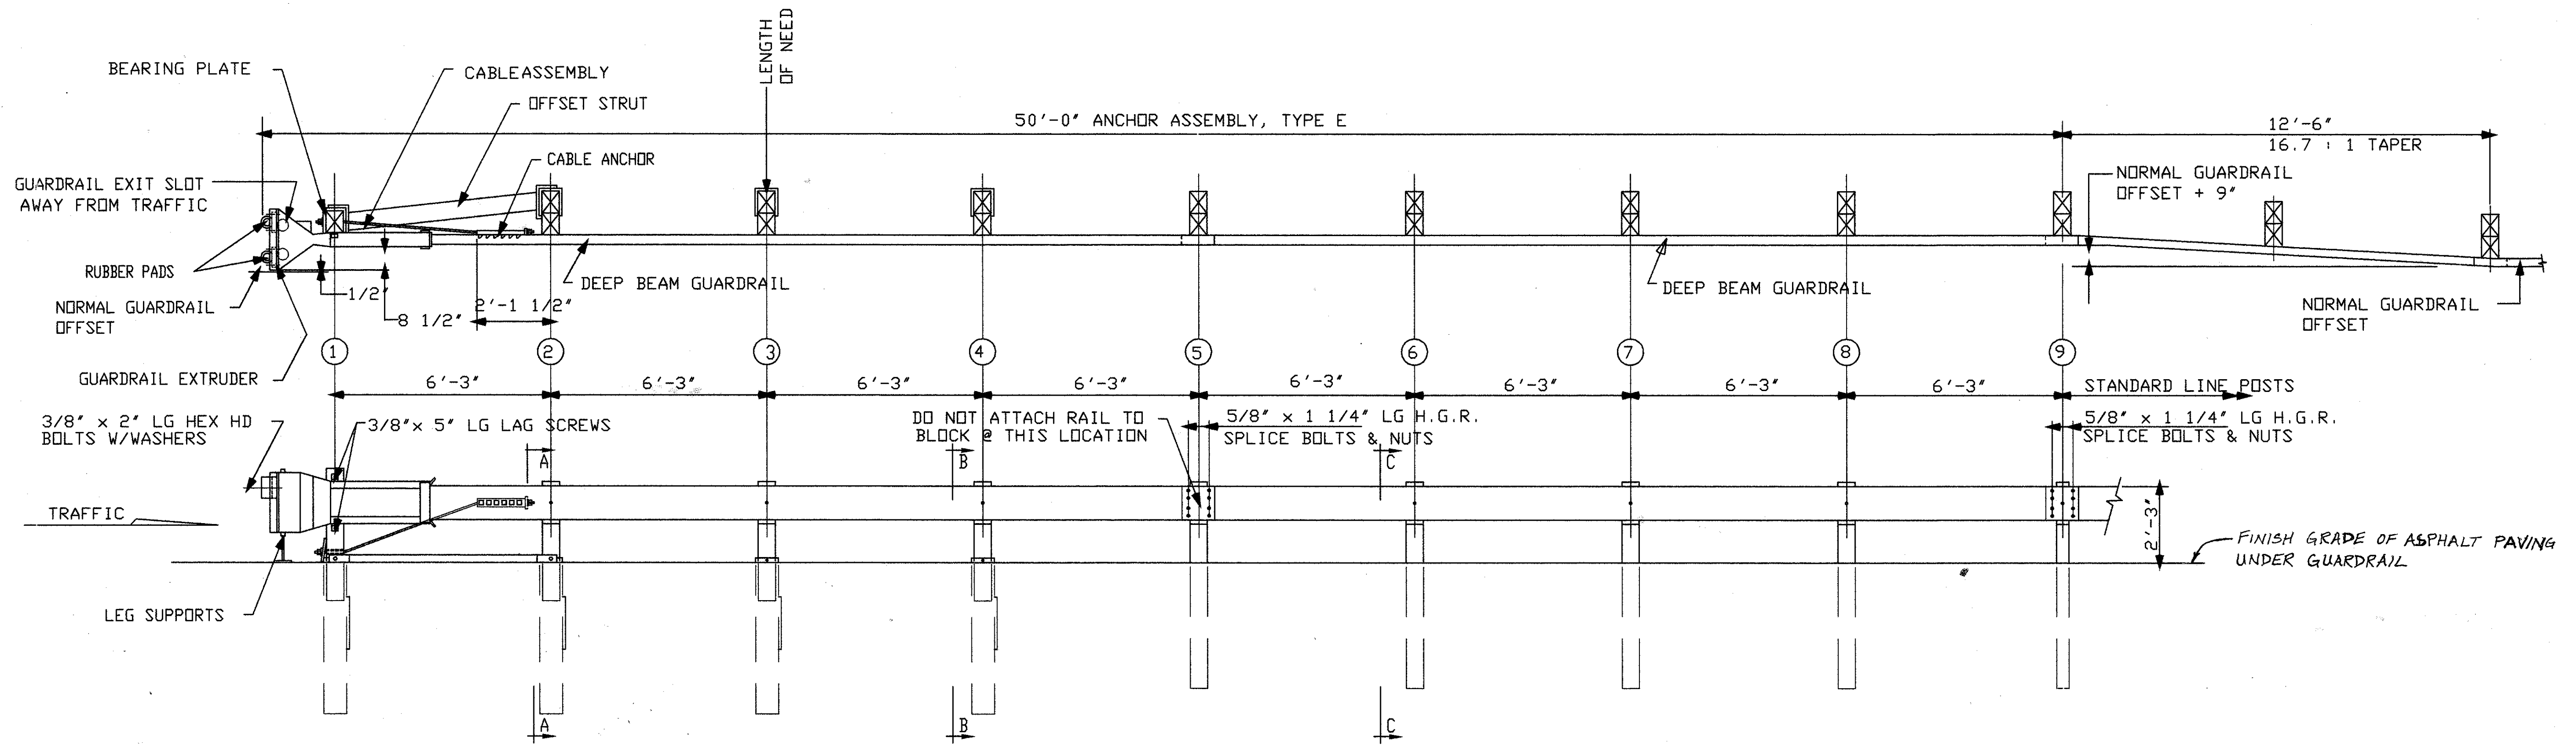

- NOTES:
- 1.) THE 5/8" FLAT WASHER IS USED UNDER THE NUT, BEHIND THE POST ONLY. NO WASHER IS USED AT THE RAIL.
 - 2.) THE BREAKAWAY POSTS @ LOCATIONS #5, 6, 7 & 8 MAY BE AS SHOWN OR MAY UTILIZE POSTS AS SHOWN WITH FOUNDATION TUBES. POSTS @ LOCATIONS #1, 2, 3 & 4 MUST USE FOUNDATION TUBES.
 - 3.) TYPE E WAS TESTED ON FLAT & LEVEL TERRAIN. IT IS NOT RECOMMENDED ON SLOPES.

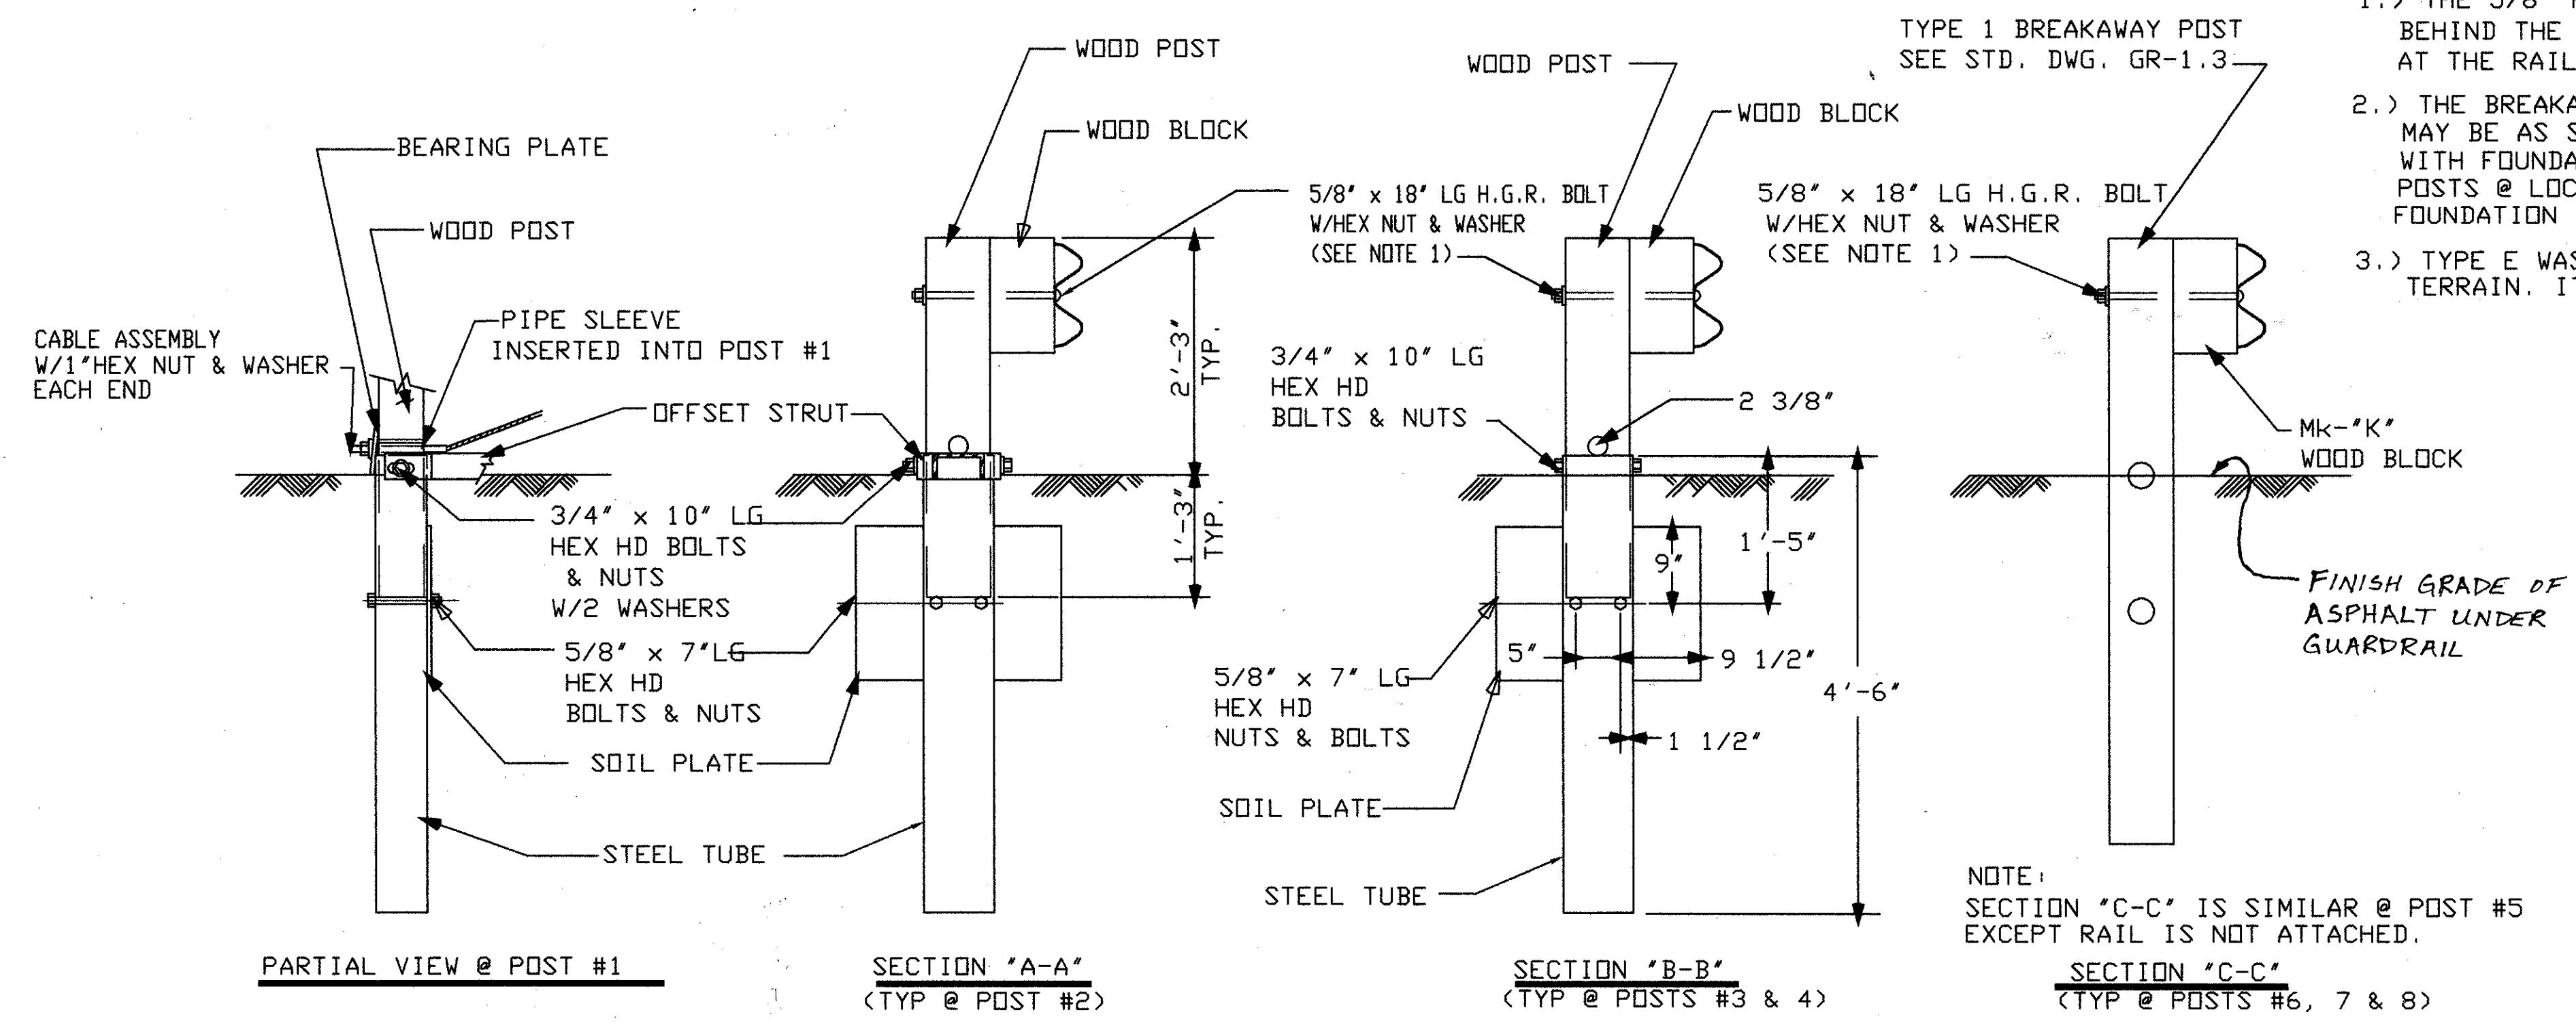

THIS DETAIL IS SHOWN FOR ILLUSTRATIVE PURPOSES ONLY.
 THE EXACT REQUIREMENTS SHALL BE IN ACCORDANCE WITH THE MANUFACTURERS RECOMMENDATIONS AND SPECIFICATIONS

MISCELLANEOUS DETAILS

LAK-2-9.46