

FED. RD. DIVISION	STATE	PROJECT	FISCAL YEAR
2	OHIO		13


2
13

TYPICAL SECTION

TYPE T-35

SCALE $3\frac{1}{8} = 1'-0"$

LAKE COUNTY
LAK-20-(0.00-4.51)

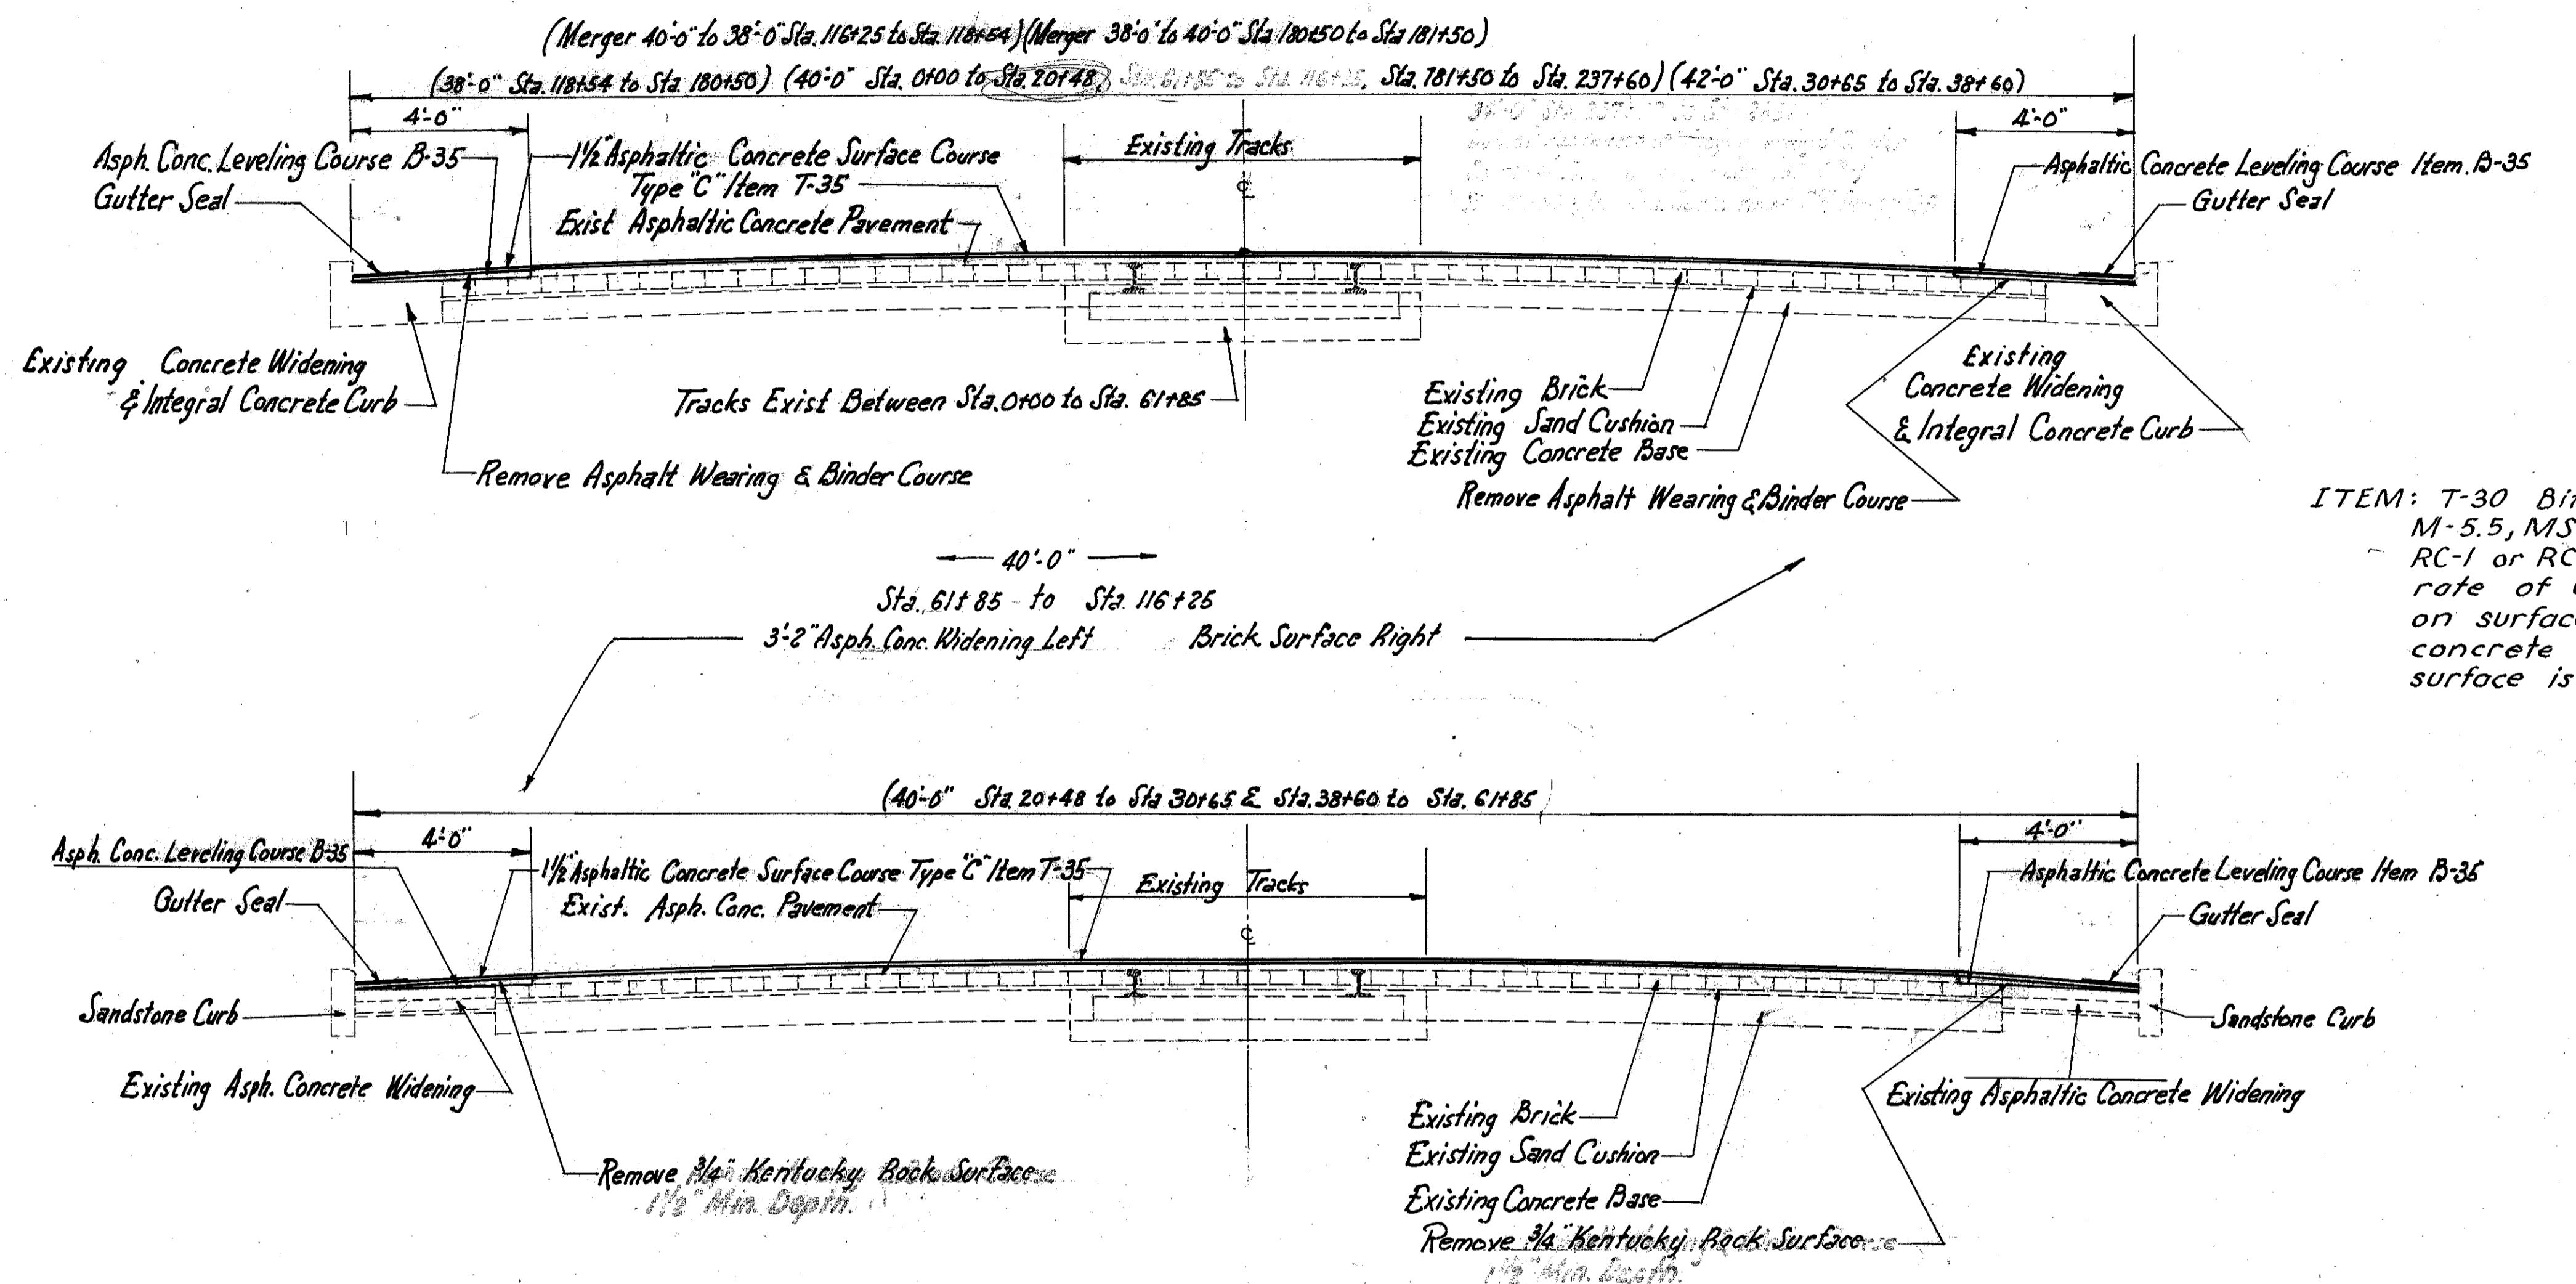

ITEM: T-30 Bituminous Tack Coat Sec. M-5.5, MS-2 or SS-1; or Sec. M-5.2, RC-1 or RC-2 shall be applied at rate of 0.10 gallons per sq. yd. on surface of existing brick and concrete where existing bituminous surface is being removed.

GENERAL NOTES

PROFILE: The Profile of the proposed surface course shall be approximately $1\frac{1}{2}$ " above profile grade as shown on plan sheets unless otherwise shown.

FILLING MAJOR DEPRESSIONS: Major depressions in existing pavement shall be filled and compacted with asphaltic concrete leveling material in advance of placing the regular surface course. These depressions shall be filled in layers not to exceed 3" in depth when compacted.

TRAFFIC: Traffic shall be maintained at all times. The length of one way traffic zones shall be kept to minimum consistent with the requirements of Sec. T-35.23. The item of maintaining traffic shall include furnishing lights, all signs, barricades and watchmen according to the requirement of Sec. G-7.07, Barricade, Danger and warning signs to secure the flow of traffic twenty four (24) hours daily.

UTILITIES: Any and all work required for private utilities will be done by and at the expense of their respective owners unless otherwise noted on these plans. The location of all utility items are shown hereon, and the State of Ohio does not guarantee the accuracy thereof.

GUTTERS: Special care shall be exercised during construction to obtain maximum compaction of asphaltic concrete in all gutters.

OPENING AT CURB INLET: T-35 Surface at curb intlets shall be feather to maintain a three (3) inch minimum opening for curb inlet castings.