


END AREA CU. YDS.
CUT FILL CUT FILL

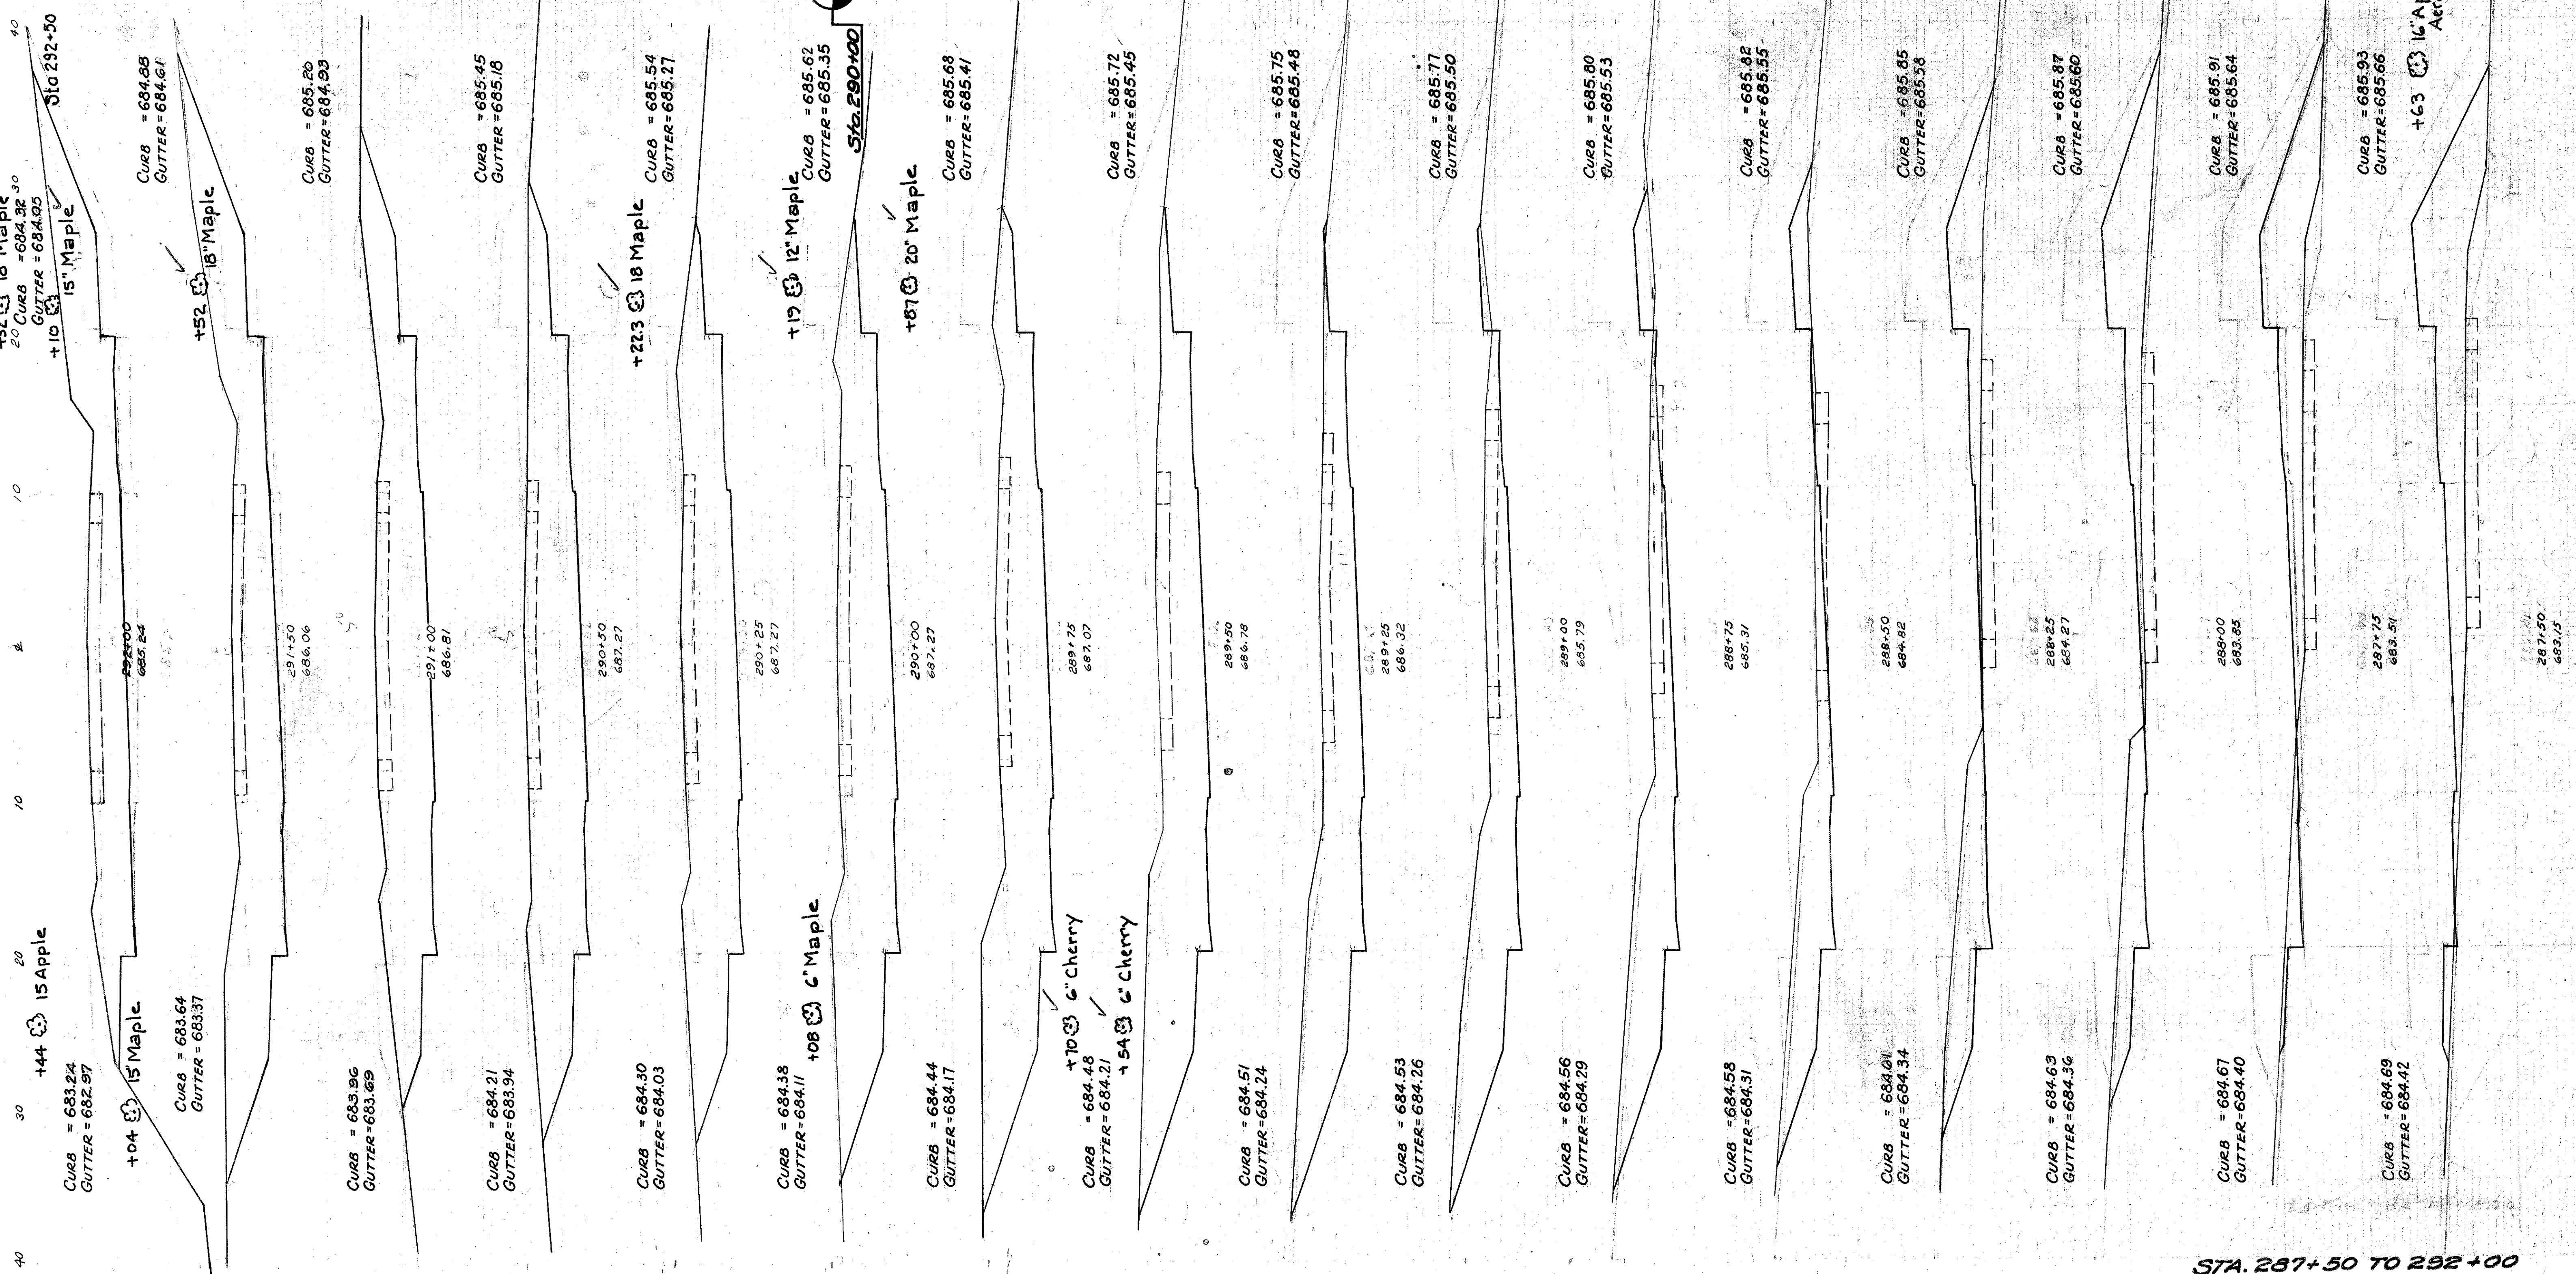

716 0	253 0	157 0	277 0	142 0	275 0	155 0	138 0	143 0	137 0	153 0	145 0	139 0	120 0	96 2	73 6	54 14	37 33	28 56	19 63	6 79
116 0	253 0	157 0	277 0	142 0	275 0	155 0	138 0	143 0	137 0	153 0	145 0	139 0	120 0	96 2	73 6	54 14	37 33	28 56	19 63	6 79

FED. RD. DIST. NO.	STATE	FED. AID PROJECT	FISCAL YEAR
10	OHIO	4(4)	1939

17
68

CLEVELAND-BUFFALO ROAD
S.H. NO. 2 SEC. J (PT.)
LAKE COUNTY

STA. 287+50 TO 292+00