


FED. RD. DIST. NO.	STATE	FED. AID PROJECT	FISCAL YEAR
10	OHIO	4(4)	1939

CLEVELAND - BUFFALO ROAD
S.H. N#2 SEC. J (PT.)
LAKE COUNTY

19
68

Excavation 3604 cu yds
Embankment 1983 " "
Embankment +30% 2448 " "

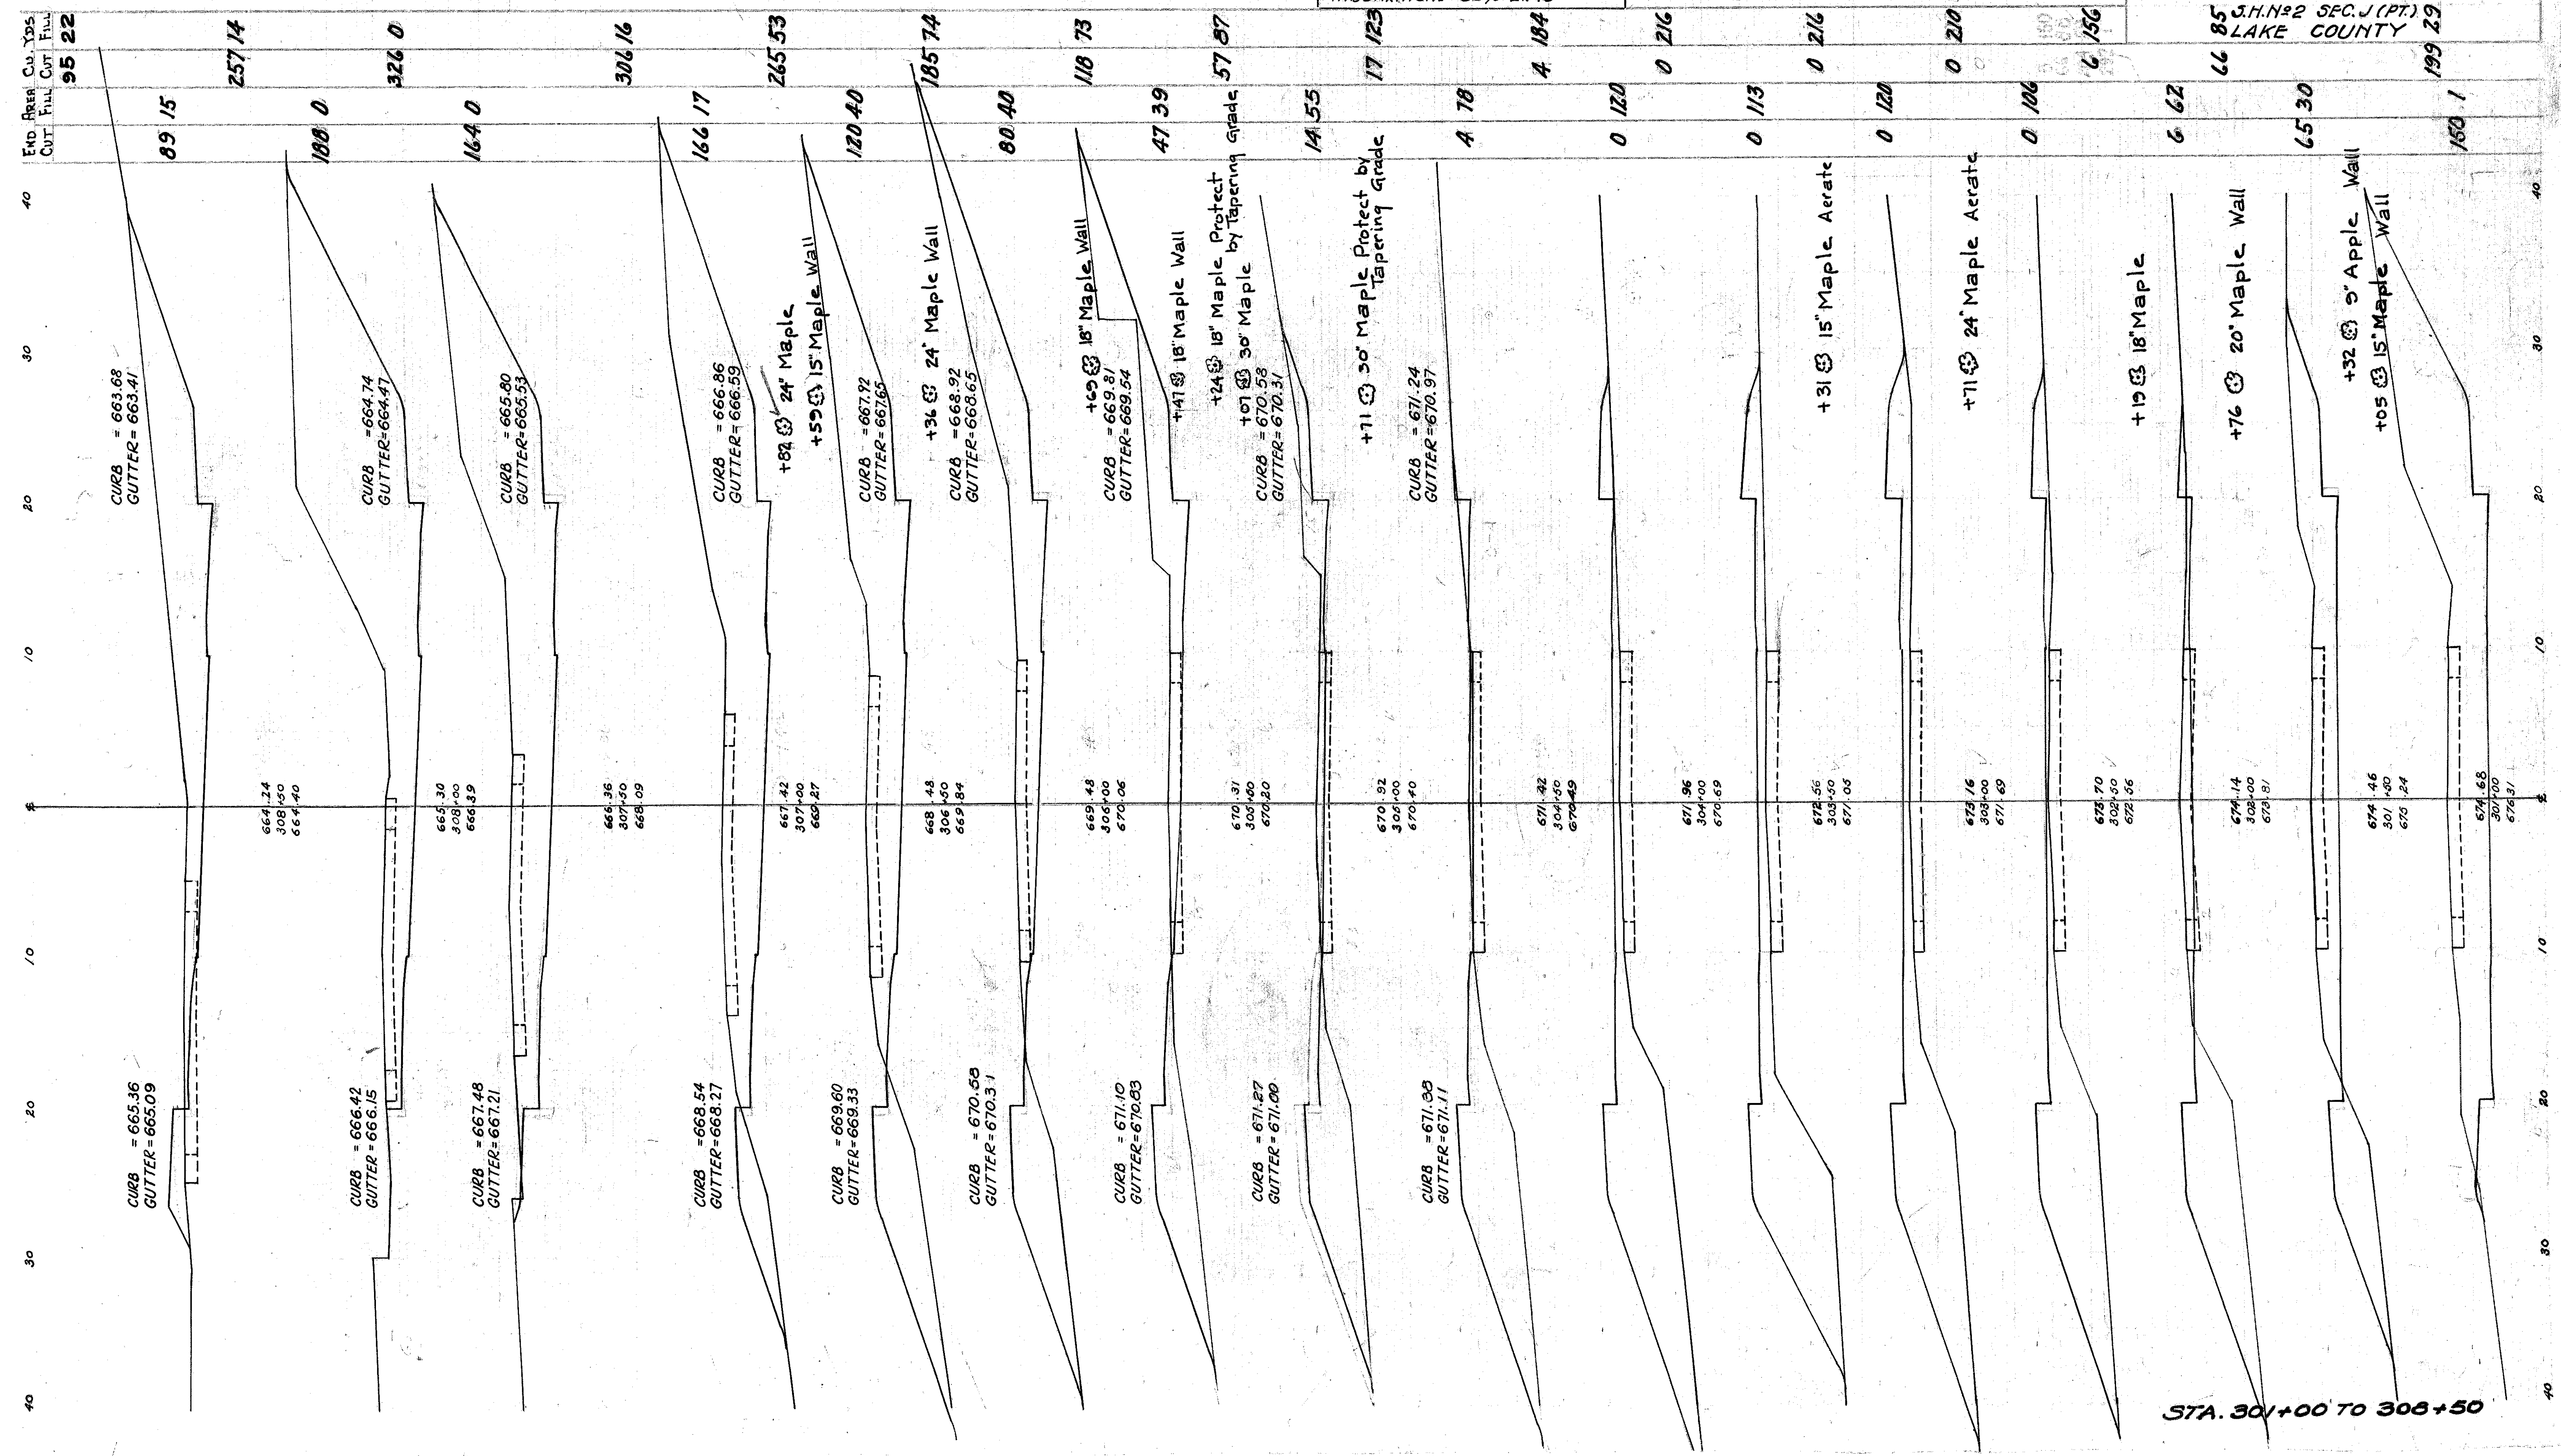

STA. 301+00 TO 308+50