

SOUTH DRIVES

Sta 360+30
Excavation 2 Cu. Yds
Aggregate 1 "

Sta 359+25
Excavation 2 Cu. Yds
Aggregate 1 "

Sta. 353+35
Excavation 2 Cu. Yds
Aggregate 1 "

Sta 345+95
Excavation 2 Cu. Yds
Embankment 2 "
Aggregate 2 "

Sta. 348+36
Excavation 2 Cu. Yds
Embankment 0 "
Aggregate 1 "

Sta. 342+84
Excavation 2 Cu. Yds
Embankment 0 "
Aggregate 1 "

Sta. 340+96
Excavation 5 Cu. Yds
Embankment 0 "
Aggregate 2.5 "

Sta. 335+06
Excavation 6 Cu. Yds
Embankment 0 "
Aggregate 2.5 "

Sta. 334+30
Excavation 5 Cu. Yds
Embankment 0 "
Aggregate 2.5 "

Sta. 326+21
Excavation 5 Cu. Yds
Embankment 0 "
Aggregate 2.5 "

NORTH DRIVES

680 Sta. 353+41
Excavation 1 Cu. Yds
Embankment 0 "
Aggregate 1 "

Sta 350+85
Excavation 2 Cu. Yds
Aggregate 1 "

680 Sta. 348+55
Excavation 1 Cu. Yds
Embankment 0 "
Aggregate 1 "

Sta 356+30
Excavation 2 Cu. Yds
Embankment 2 "
Aggregate 2 "

680 Sta. 343+69
Excavation 3 Cu. Yds
Embankment 0 "
Aggregate 2 "

675 Sta. 340+71
Excavation 5 Cu. Yds
Embankment 0 "
Aggregate 2.5 "

675 Sta. 336+61
Excavation 5 Cu. Yds
Embankment 0 "
Aggregate 2.5 "









680 Sta. 332+65
Excavation 5 Cu. Yds
Embankment 0 "
Aggregate 2.5 "

~~680 Sta. 330+56
Excavation 4 Cu. Yds
Embankment 0 "
Aggregate 2 "~~

Sta. 329+92
Excavation 3 Cu. Yds
Aggregate 2 "

~~675 Sta. 329+50
Excavation 3 Cu. Yds
Embankment 0 "
Aggregate 2 "~~

NORTH DRIVES

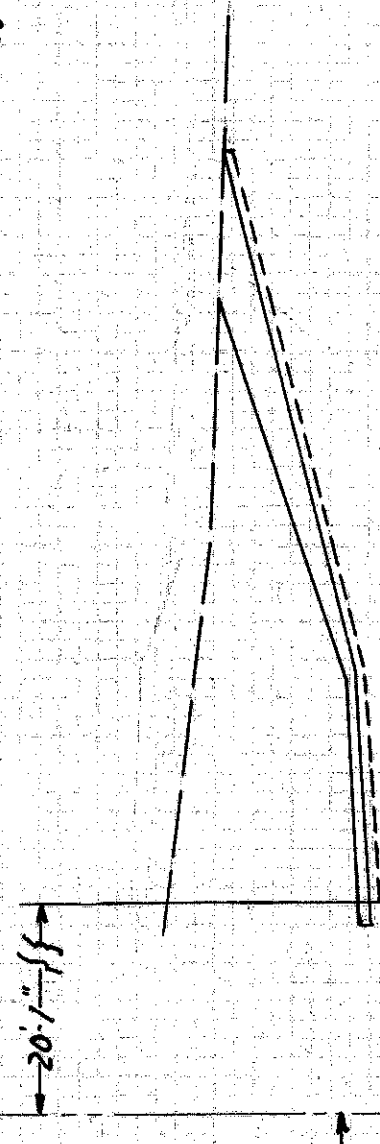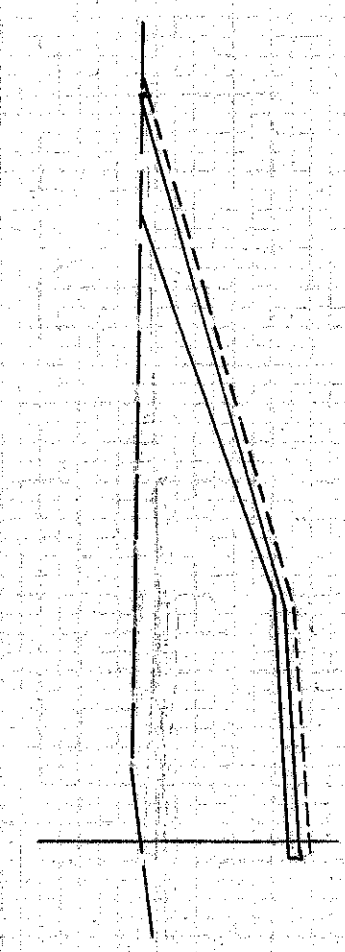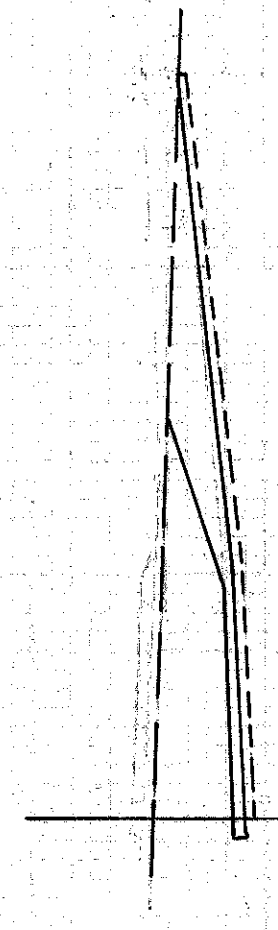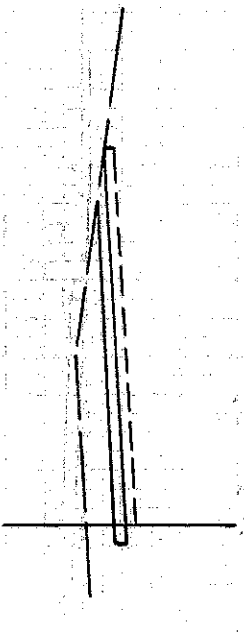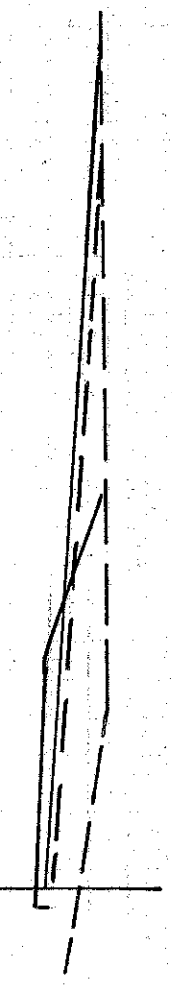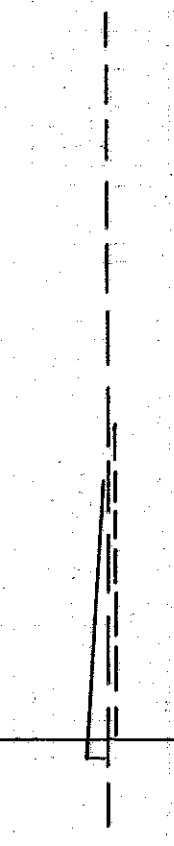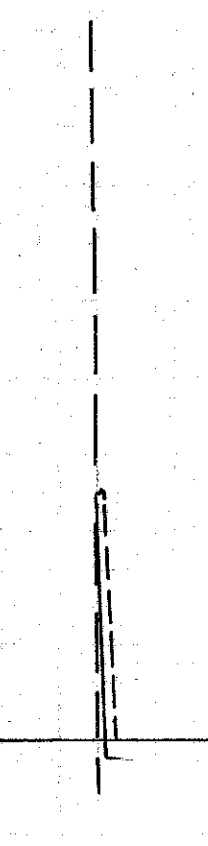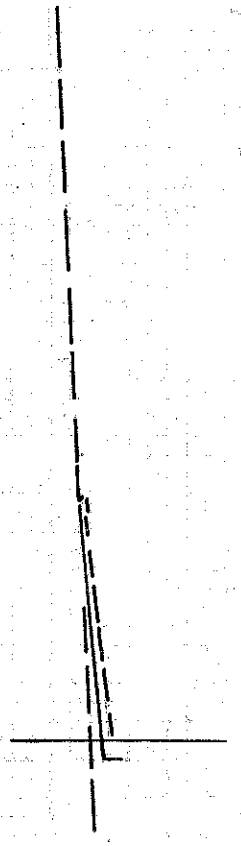

50 40 30 20 10 0 10 20 30 40 50