


CALCULATED
CHECKED

TRAFFIC CONTROL PLAN
RICHMOND STREET & JACKSON STREET

LAKE COUNTY
LAK-20-22.916/VARIOUS

50
111

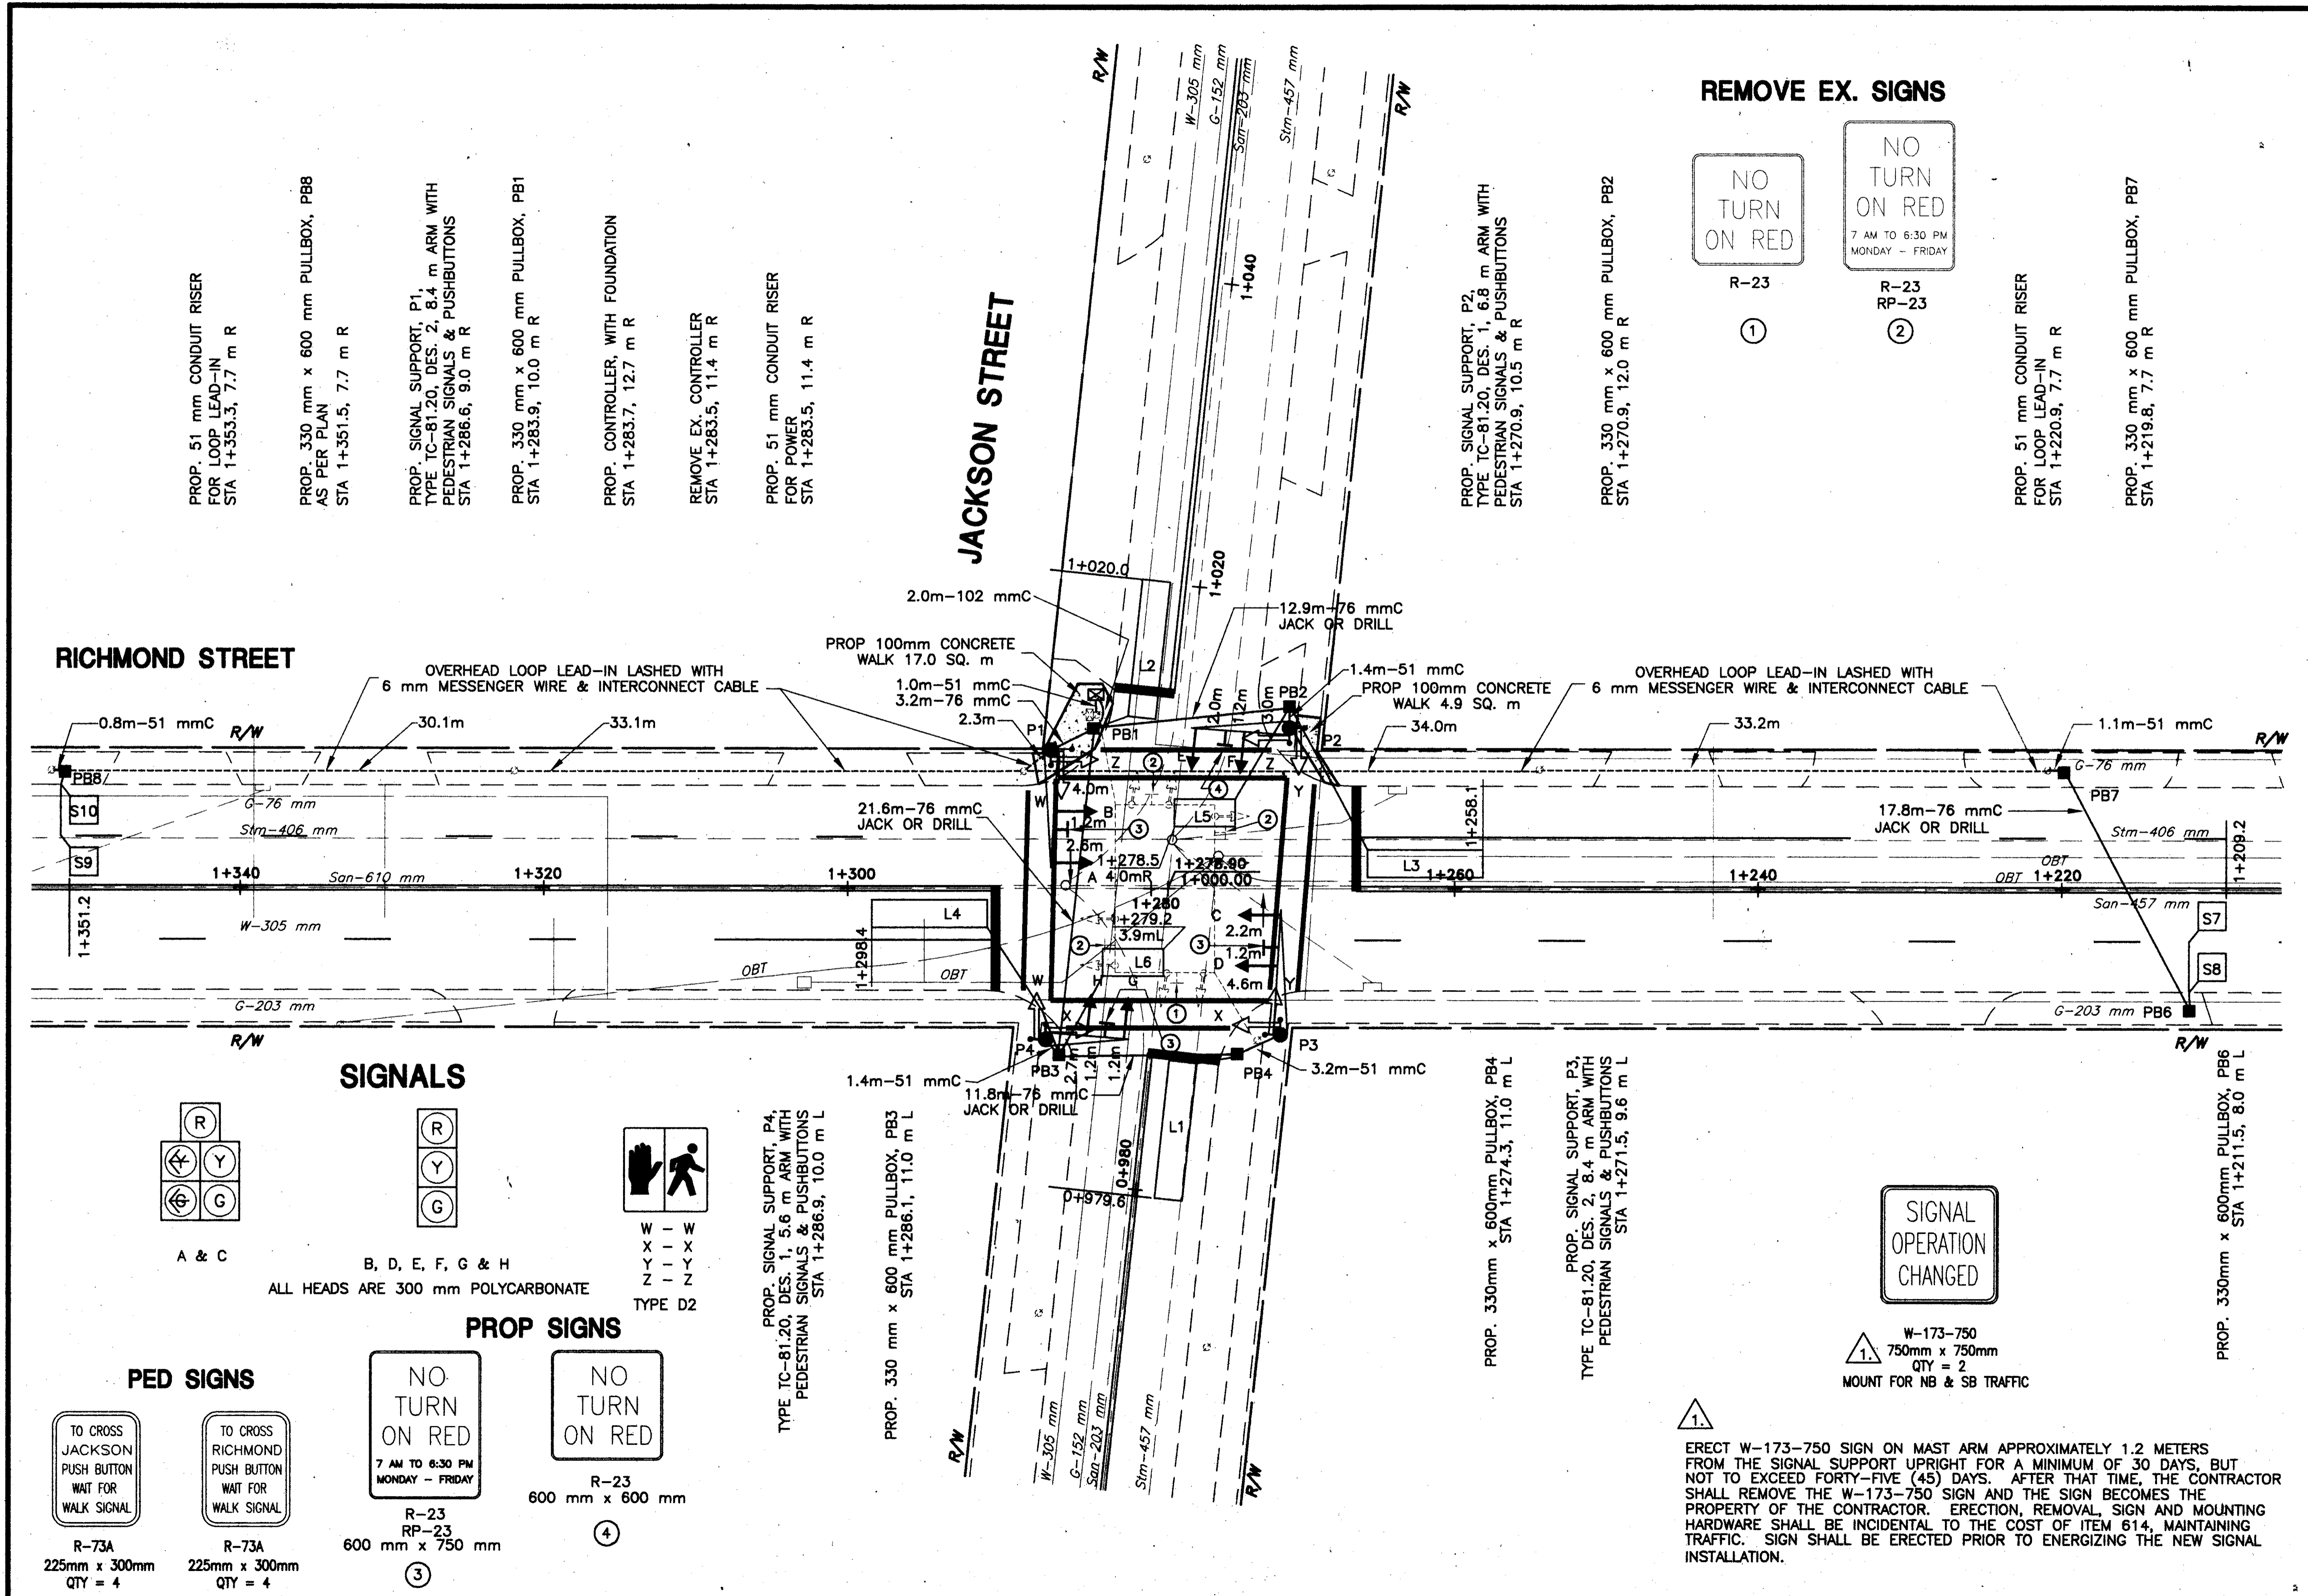

PROP. 51 mm CONDUIT RISER FOR LOOP LEAD-IN STA 1+353.3, 7.7 m R

PROP. 330 mm x 600 mm PULLBOX, PB8 AS PER PLAN STA 1+351.5, 7.7 m R

PROP. SIGNAL SUPPORT, P1, TYPE TC-81.20, DES. 2, 8.4 m ARM WITH PEDESTRIAN SIGNALS & PUSHBUTTONS STA 1+286.6, 9.0 m R

PROP. 330 mm x 600 mm PULLBOX, PB1 STA 1+283.9, 10.0 m R

PROP. CONTROLLER WITH FOUNDATION STA 1+283.7, 12.7 m R

REMOVE EX. CONTROLLER STA 1+283.5, 11.4 m R

PROP. 51 mm CONDUIT RISER FOR POWER STA 1+283.5, 11.4 m R


PROP. SIGNAL SUPPORT, P2, TYPE TC-81.20, DES. 1, 6.8 m ARM WITH PEDESTRIAN SIGNALS & PUSHBUTTONS STA 1+270.9, 10.5 m R

PROP. 330 mm x 600 mm PULLBOX, PB2 STA 1+270.9, 12.0 m R

PROP. 51 mm CONDUIT RISER FOR LOOP LEAD-IN STA 1+220.9, 7.7 m R


PROP. 330 mm x 600 mm PULLBOX, PB7 STA 1+219.8, 7.7 m R

REMOVE EX. SIGNS

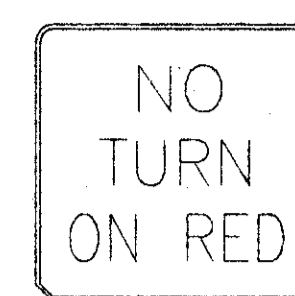

R-23


①

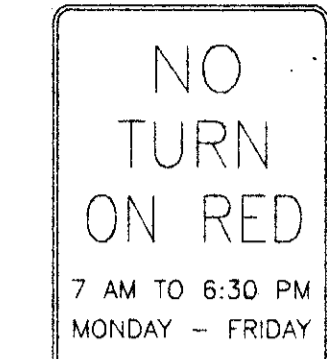


R-23
RP-23

②

SIGNALS

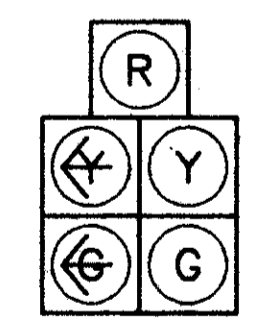


A & C

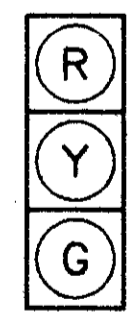

B, D, E, F, G & H

ALL HEADS ARE 300 mm POLYCARBONATE

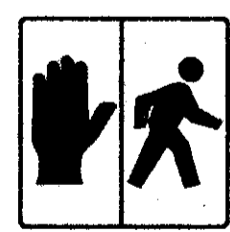


W - W
X - X
Y - Y
Z - Z
TYPE D2


PROP SIGNS




R-73A
225mm x 300mm
QTY = 4

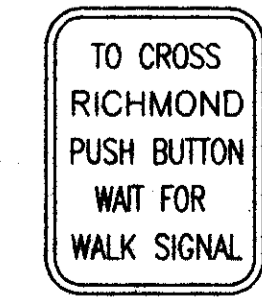

R-73A
225mm x 300mm
QTY = 4

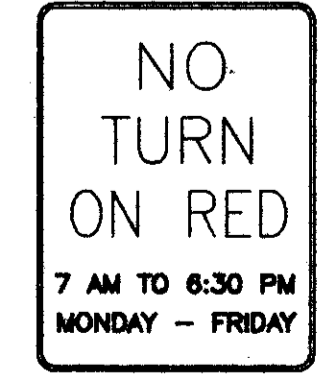

R-23
RP-23
600 mm x 750 mm

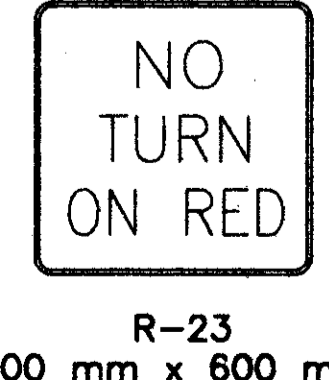

R-23
600 mm x 600 mm

③

④

PROP. SIGNAL SUPPORT, P4, TYPE TC-81.20, DES. 1, 5.6 m ARM WITH PEDESTRIAN SIGNALS & PUSHBUTTONS STA 1+286.9, 10.0 m L

PROP. 330 mm x 600 mm PULLBOX, PB3 STA 1+286.1, 11.0 m L

PROP. 330mm x 600mm PULLBOX, PB4 STA 1+274.3, 11.0 m L

PROP. SIGNAL SUPPORT, P3, TYPE TC-81.20, DES. 2, 8.4 m ARM WITH PEDESTRIAN SIGNALS & PUSHBUTTONS STA 1+271.5, 9.6 m L



W-173-750
750mm x 750mm
QTY = 2
MOUNT FOR NB & SB TRAFFIC



ERECT W-173-750 SIGN ON MAST ARM APPROXIMATELY 1.2 METERS FROM THE SIGNAL SUPPORT UPRIGHT FOR A MINIMUM OF 30 DAYS, BUT NOT TO EXCEED FORTY-FIVE (45) DAYS. AFTER THAT TIME, THE CONTRACTOR SHALL REMOVE THE W-173-750 SIGN AND THE SIGN BECOMES THE PROPERTY OF THE CONTRACTOR. ERECTION, REMOVAL, SIGN AND MOUNTING HARDWARE SHALL BE INCIDENTAL TO THE COST OF ITEM 614, MAINTAINING TRAFFIC. SIGN SHALL BE ERECTED PRIOR TO ENERGIZING THE NEW SIGNAL INSTALLATION.

PROP. 330mm x 600mm PULLBOX, PB6 STA 1+211.5, 8.0 m L