

CLEVELAND-BUFFALO ROAD

S.H. NO. 2
LAKE
PERRY

SEC. J

TOWNSHIP

PET. NO.
COUNTY
NOV. 1928

RELOCATION AT RED MILL CREEK

FED. RD. DIST. No.	STATE	FED. AID PROJECT	FISCAL YEAR	(1/10)
	OHIO			

S.H. 2 SEC. J
LAKE COUNTY


U.S.R. 20 28.162

The Standard Specifications of the State of Ohio, Department of Highways in force on date of contract will govern this improvement.

I hereby approve these plans and declare that the making of this improvement will not require the closing to traffic of the highway.

CONVENTIONAL SIGNS

State Line	_____
County Line	_____
Township Line	_____
Section Line	_____
Property Line not fenced	_____
Center Line	_____
City or Village line	_____
Fence	_____
Telephone or Telegraph	TTTTTTTT
Stream Railroad	_____
Electric Line	_____
Guard Rail	_____
Drain Pipe - new	_____
Drain Pipe - old	_____

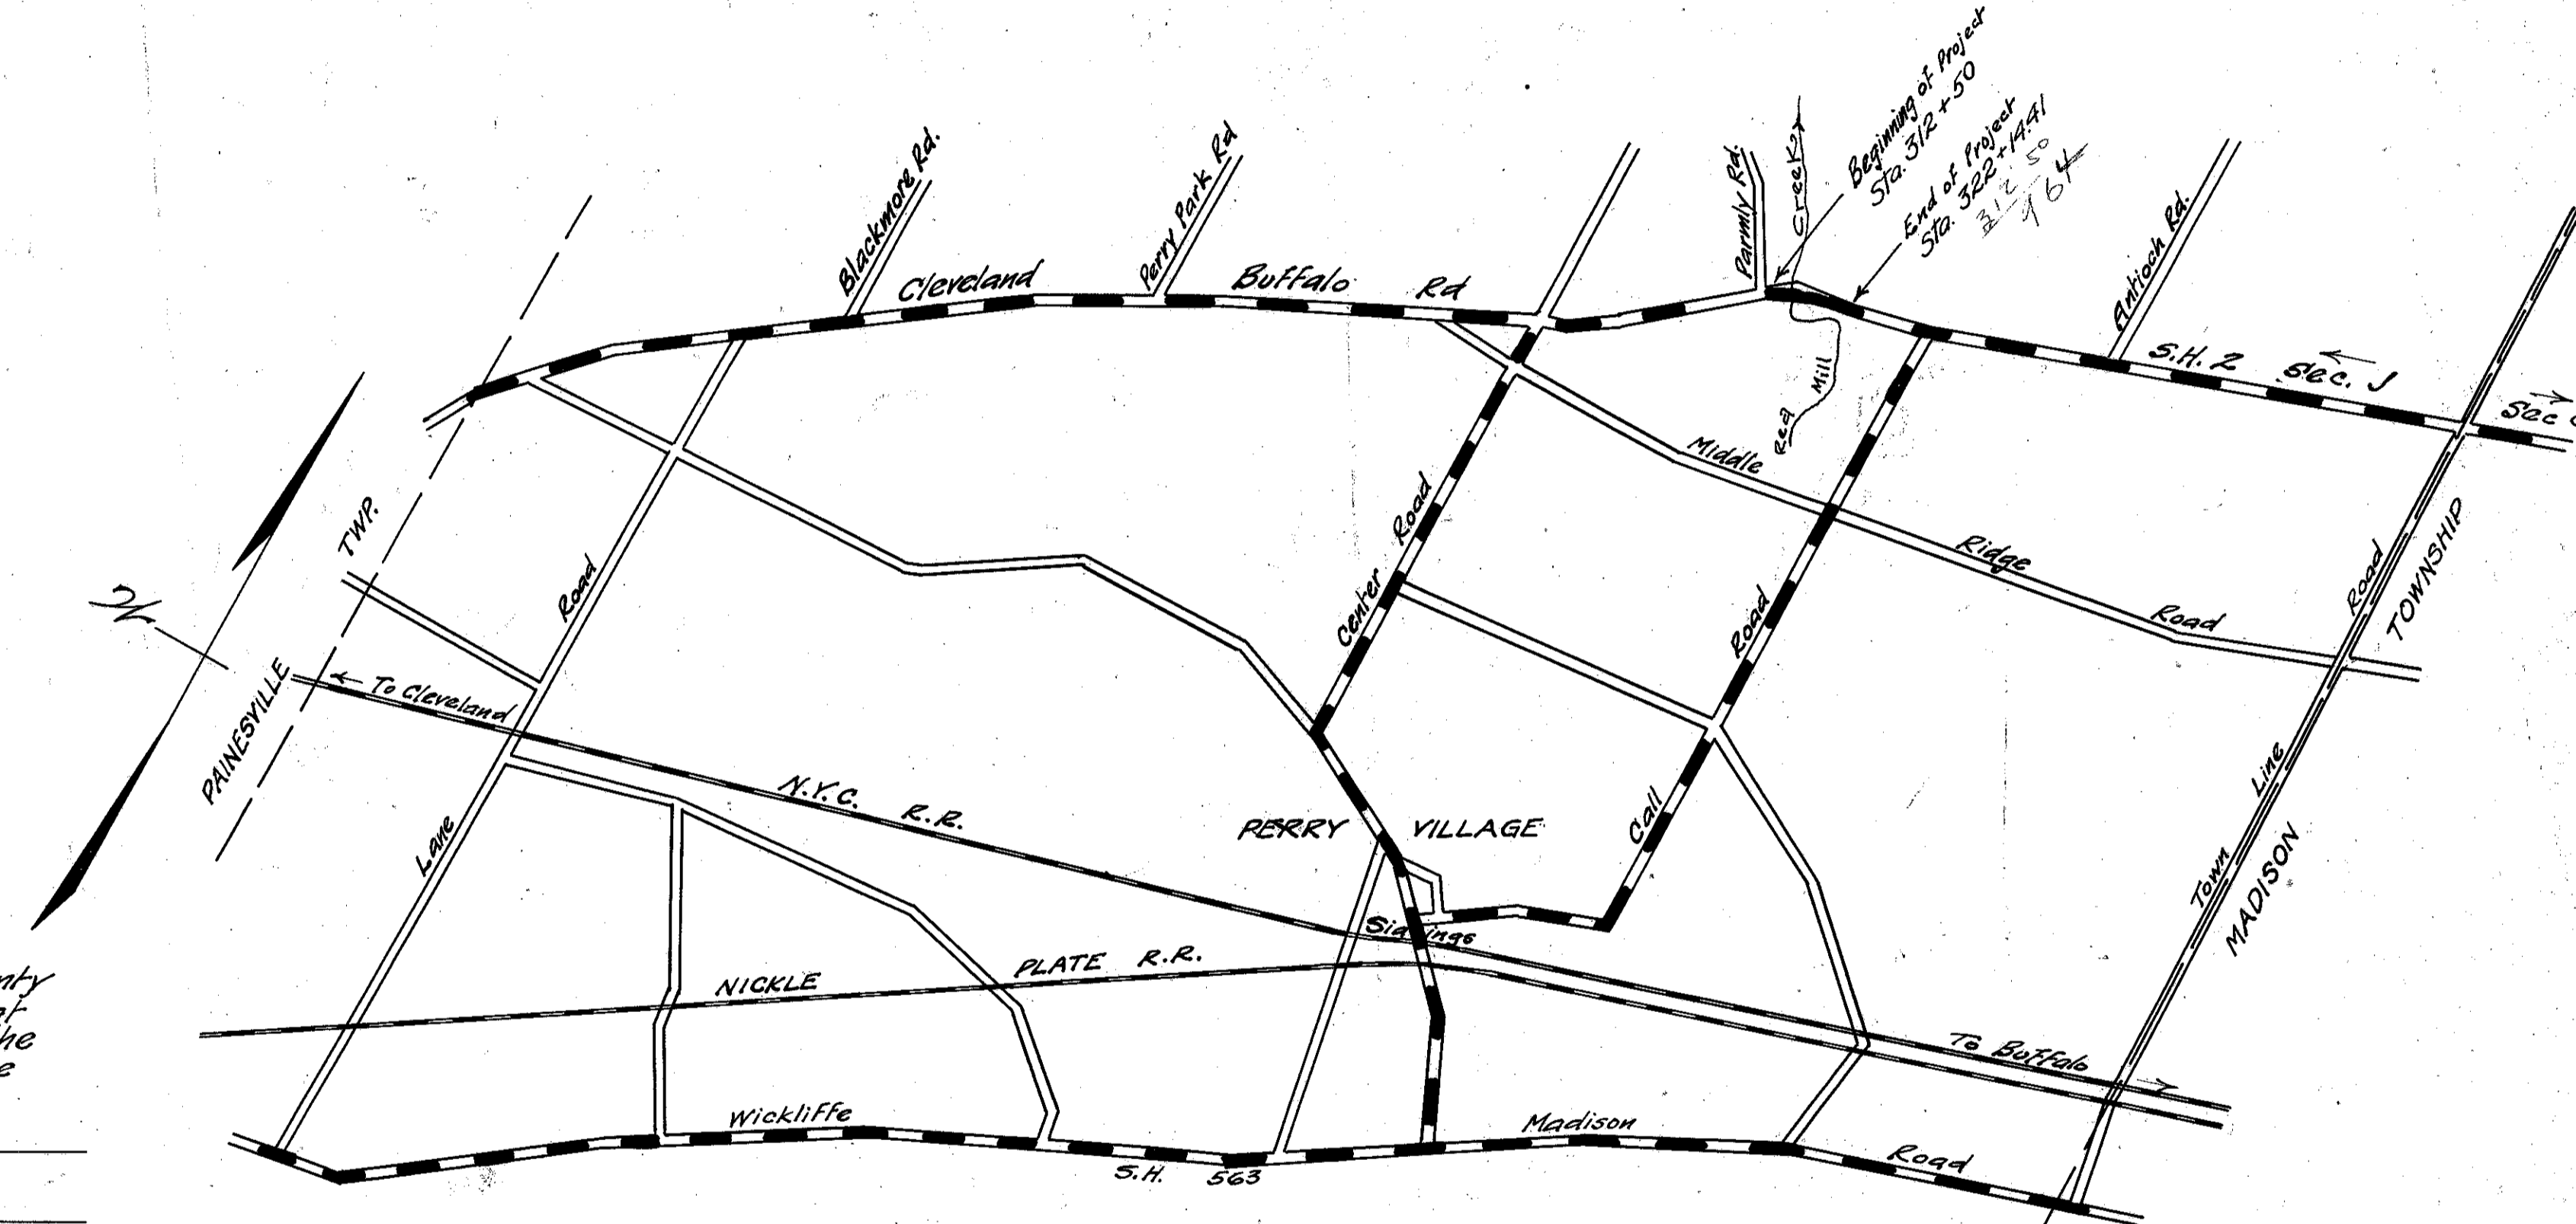


We, the Commissioners of Lake County hereby approve these plans and certify that the right of way wide is available for the construction, maintenance and repair of the above highway.

Date, _____ County Commissioners

SCALES

Plan	1" = 100'
Profile (vertical)	1" = 10'
Profile (horizontal)	1" = 100'
Cross Sections	1" = 5'

LOCATION PLAN

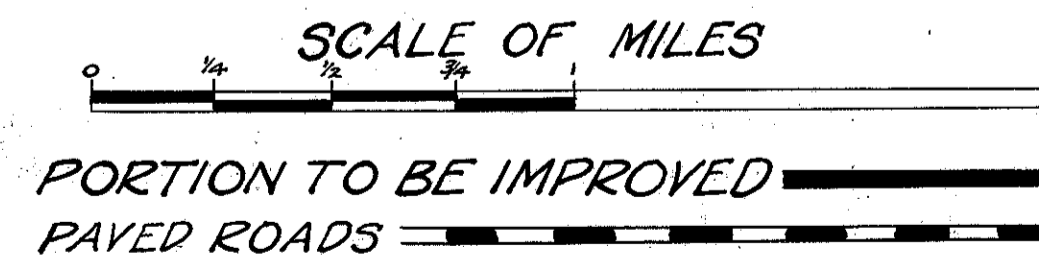

INDEX OF SHEETS PROJECT TRACINGS

Title Page	p. 1
Typical Cross Section	p. 2
Plan & Profile	p. 3
Cross Sections	p. 4-8
Structural Plan	p. 9
Summary Sheet	p. 9
Right-of-Way Plan	p. 10

OK'd
4/28/29

Approved: Clyde Otts
Date, Dec 11/28 Resident District
Deputy Director

Approved: L. A. Breen
Date, 12-20-28 Resident Division
Deputy Director

Approved: Am. W. DeWitt
Date, 1/28/29 Deputy Director
Bureau of Construction

Approved: _____
Date, _____ Deputy Director
Bureau of Maintenance

Approved: J. R. Burkey
Date, 3-9-29 Deputy Director
Bureau of Bridges

Approved: Paul S. Baughman
Date, 4-9-29 1st Assistant Director

Approved: Robt. W. Ward
Date, 4-9-29 Director of Highways

Recommended for Approval: _____
Date, _____ District Engineer
Bureau of Public Roads

Recommended for Approval: _____
Date, _____ Chief Engineer
Bureau of Public Roads

Approved: _____
Date, _____ Chief of Bureau