

30 25 20 15 10 5 0 5 10 15 20 25 30 35 40 45 50 55 60 65 70 75 80 85 90 95 100

OLD E

|                |       |                  |             |
|----------------|-------|------------------|-------------|
| EED. RD. DIST. | STATE | FED. AID PROJECT | FISCAL YEAR |
|                | OHIO  |                  |             |


8  
10

SH. 2  
LAKE

SEC. J  
COUNTY

| END AREA |      | CU. YDS. |      |
|----------|------|----------|------|
| CUT      | FILL | CUT      | FILL |
| 145      | 2.2  |          |      |
| 200      | 3.0  |          |      |
| 291      | 8.3  |          |      |
| 120      | 6.2  |          |      |
| 411      | 6.3  |          |      |

Exc. = 407.4 Cu Yds.  
 Frob. = 5063.7 Cu Yds.  
 Frob. + 25% = 6329.6 Cu Yds.  
 Borrow = 5925.2 Cu Yds.

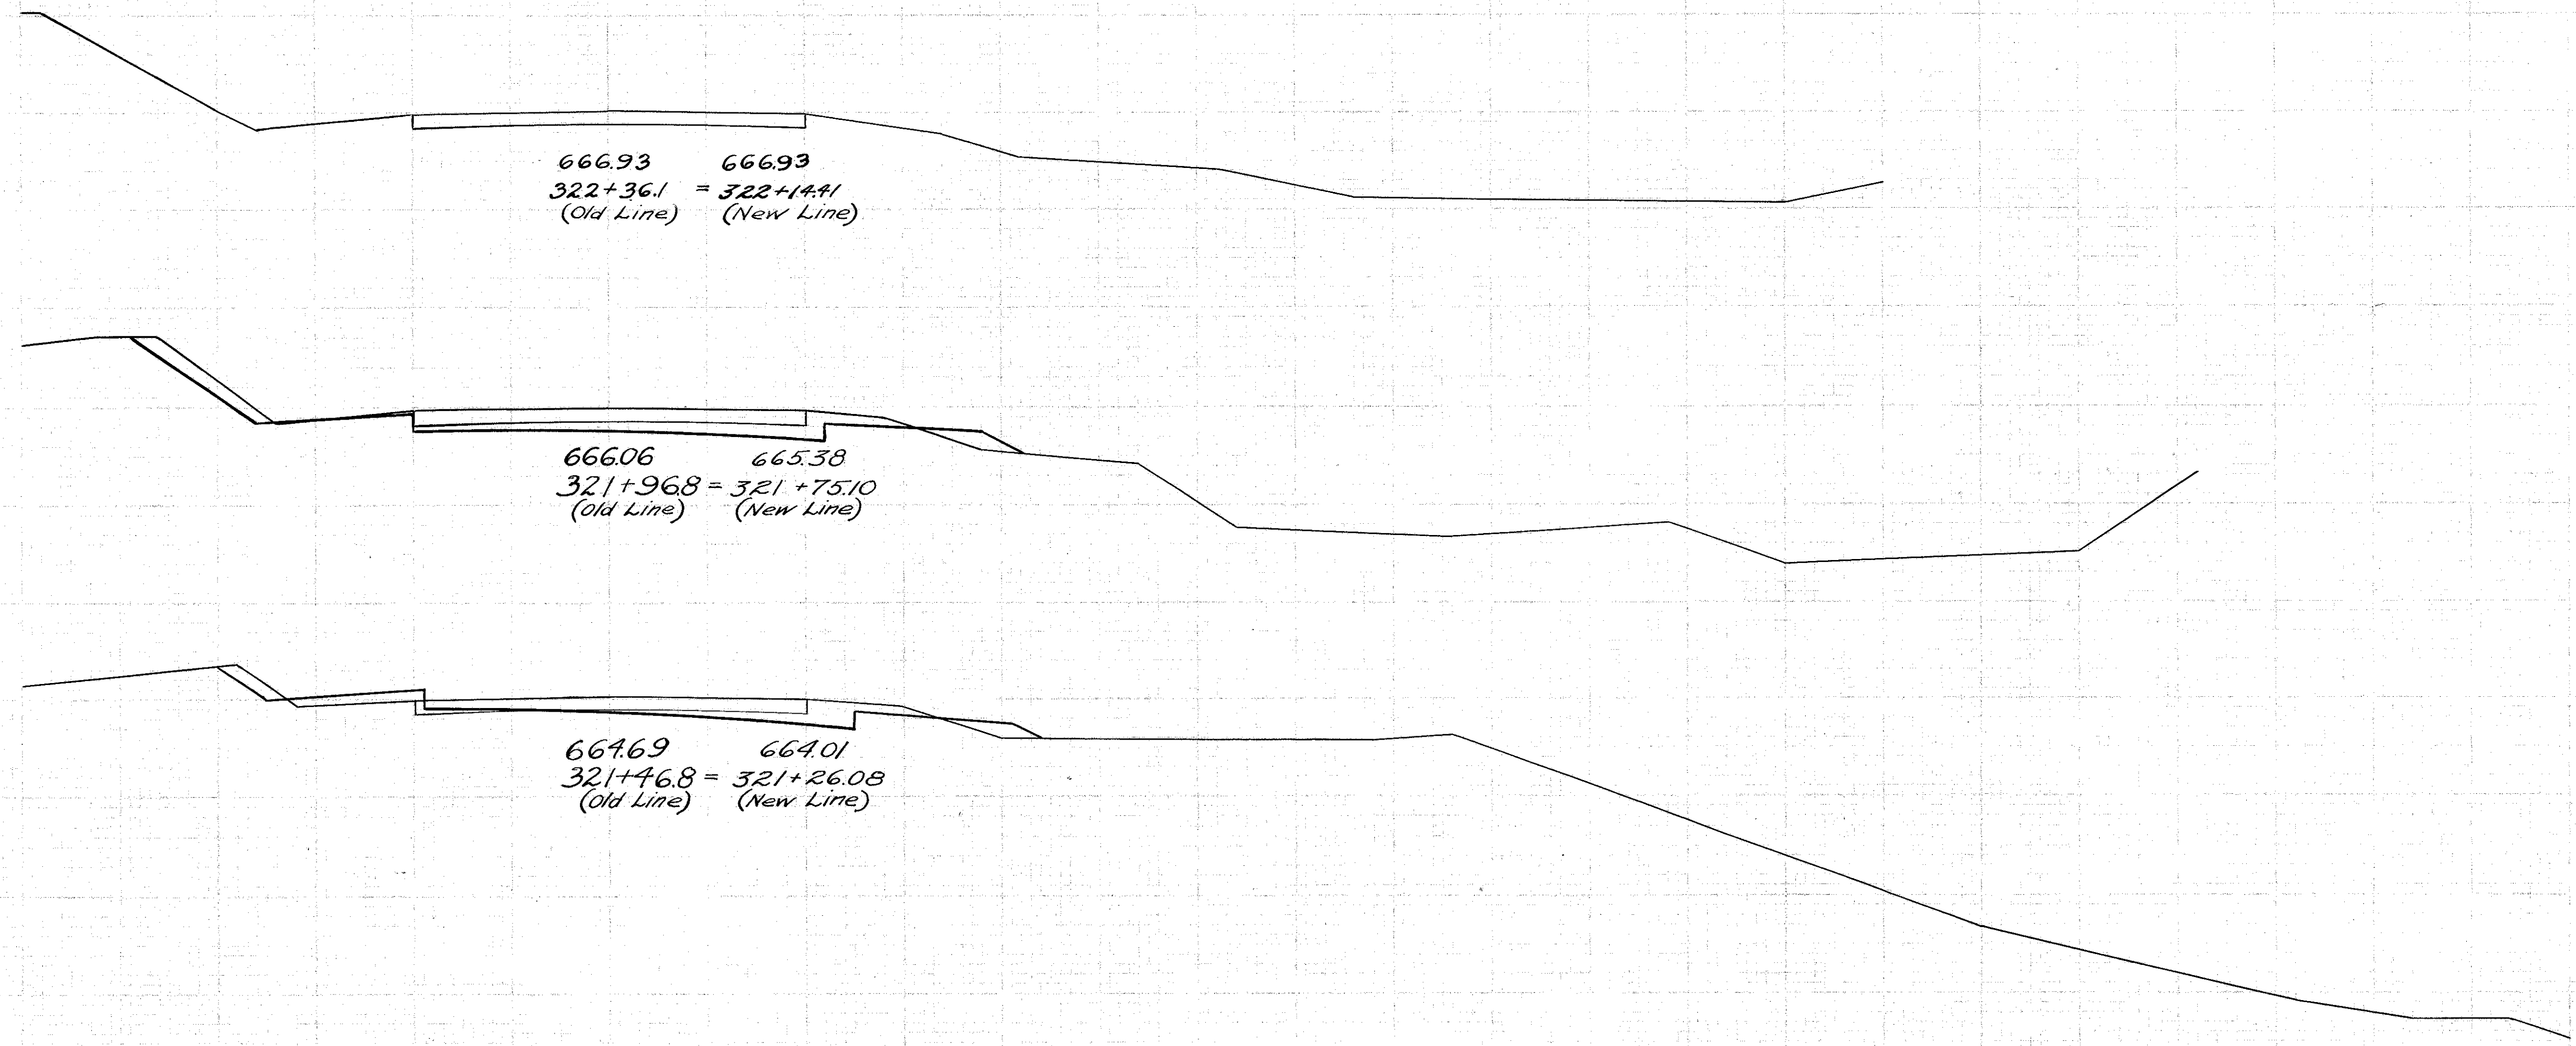

666.93    666.93  
 322+36.1 = 322+14.41  
 (Old Line)    (New Line)

666.06    665.38  
 321+96.8 = 321+75.10  
 (Old Line)    (New Line)

 321+46.8 = 321+26.08  
 (Old Line)    (New Line)