FED. ROAD DIST. NO.	STATE	FED. AID PROJ. NO.	FISCAL YEAR
10	OHIO	5	1918

2 / 20

I.C.H. No. 2 SEC. Q
LAKE COUNTY

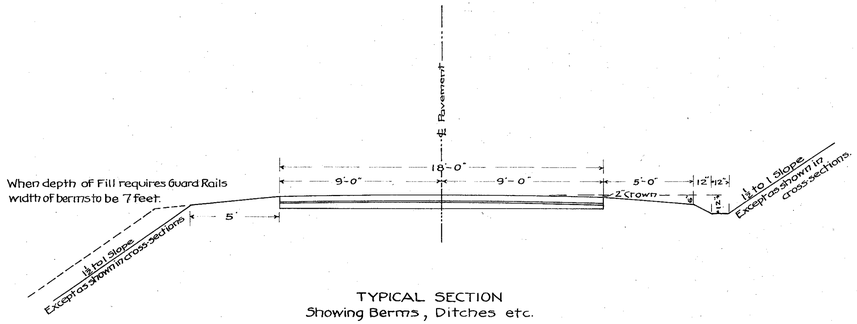

TYPICAL SECTION
Showing Berms, Ditches etc.

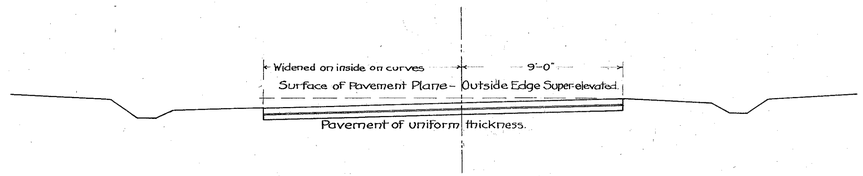

TYPICAL SECTION ON CURVES

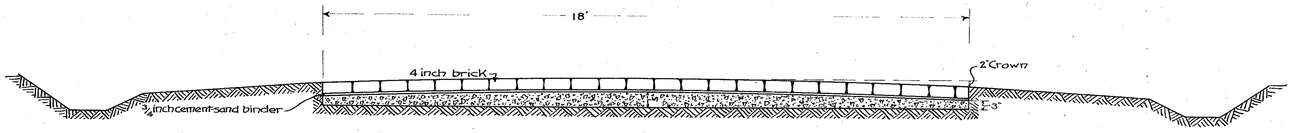

Typical Section of Semi-monolithic Brick Pavement.

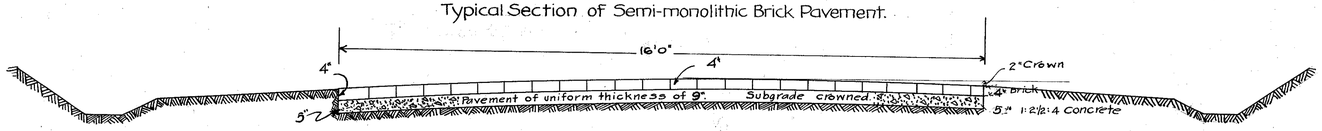

Typical Section of Monolithic Brick Pavement.

Typical Section of Concrete Pavement.

Coarse aggregate to Consist of Grade "A" Limestone

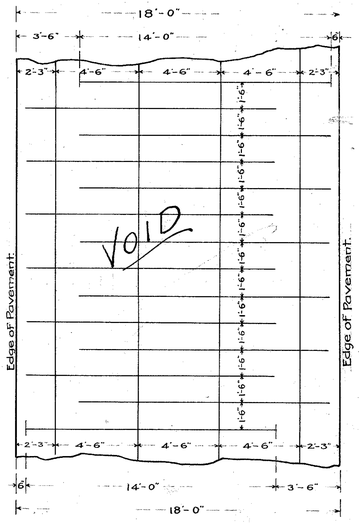

Plan showing spacing of re-inforcing bars.
All re-inforcing bars to be ⅜ inch square twisted.