


CALC BY JC  
 DATE 2-89  
 CHKD BY LME  
 DATE 9-20-89

SEEDING	
END WIDTH	SQUARE YDS
12	2.4
10	
10	
49	
13	
72	
13	
72	
13	
69	

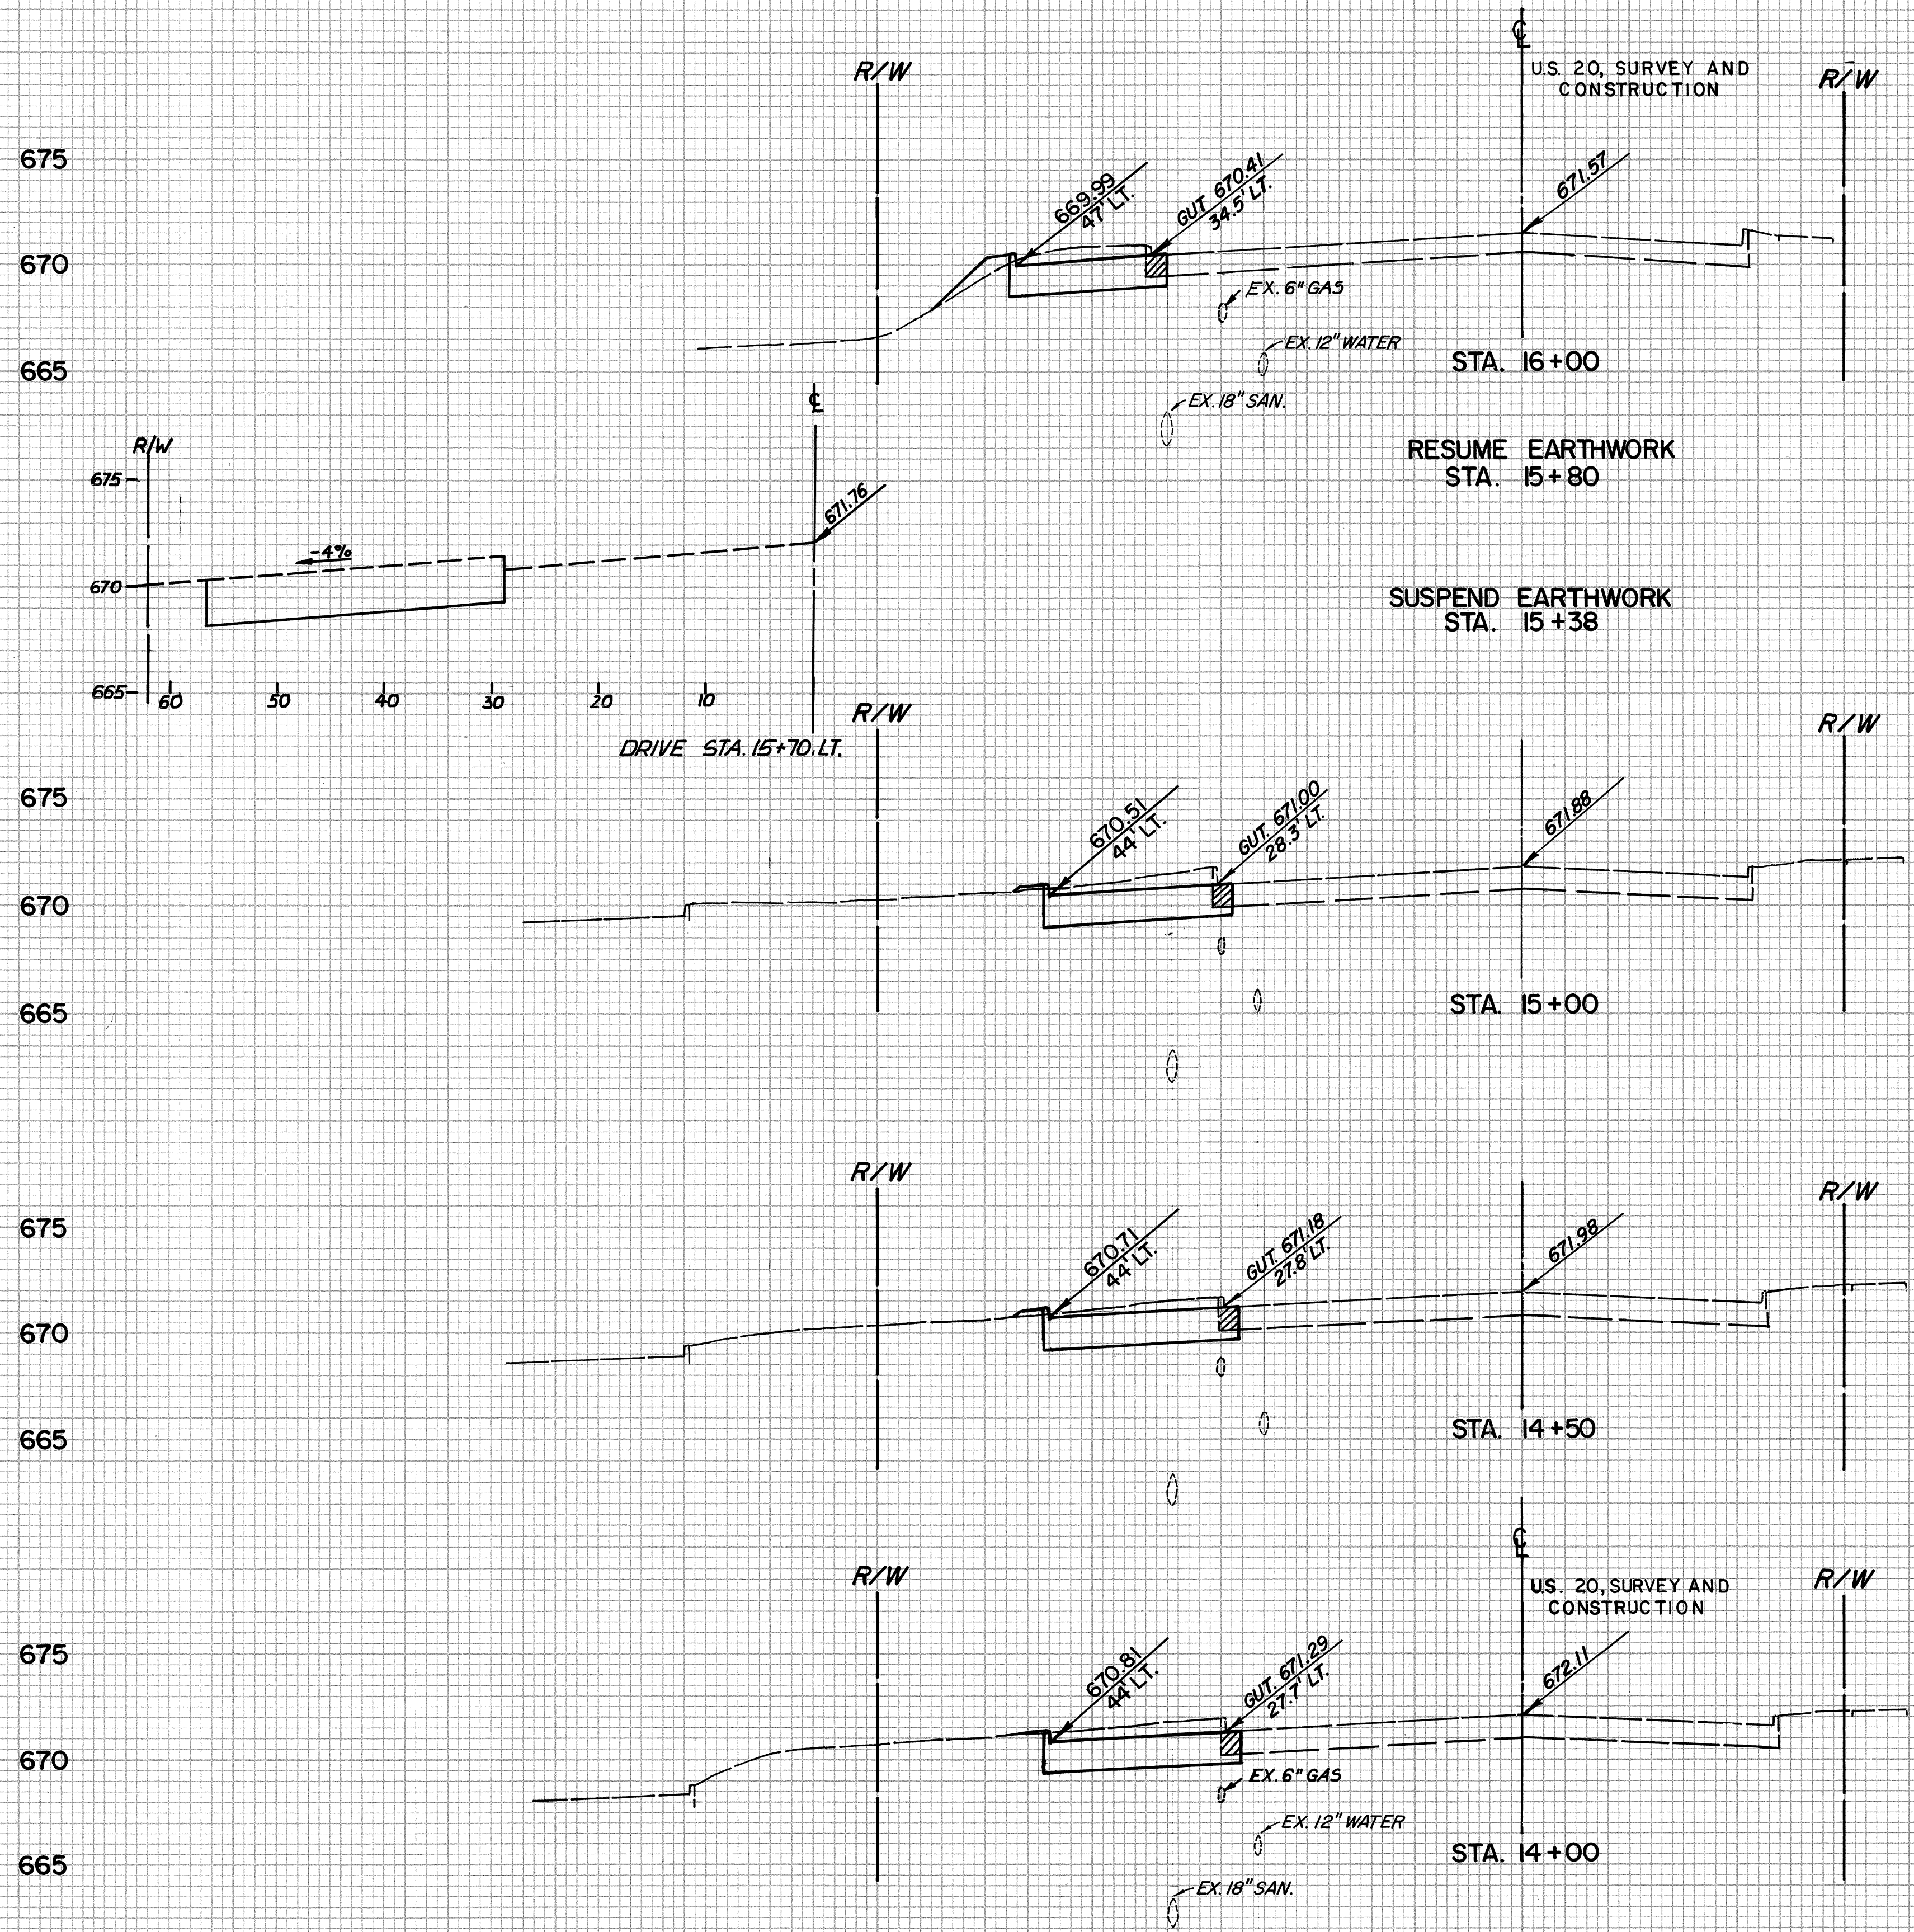

END	AREA		VOLUME	
	CUT	FILL	CUT	FILL
675				
670	32	5		
665			13	2
	3	0		
			26	2
675				
670	35	3		
665			65	6
675				
670	35	3		
665			65	3
675				
670	35	0		
665			69	0

FINAL SURVEY PLOTTED DATE AREAS CHECKED.

FINAL SURVEY PLOTTED DATE AREAS CHECKED.