

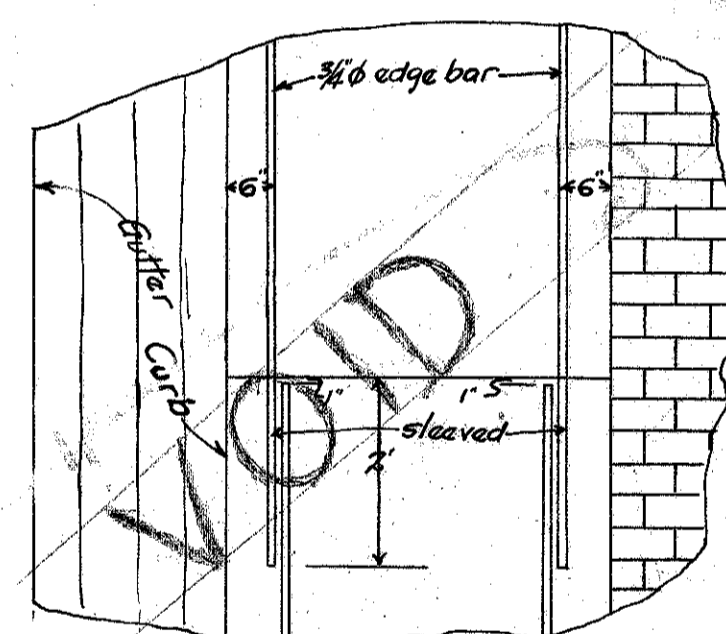


S.H. No. 2 Sec. G, H. & Mentor.  
LAKE COUNTY.

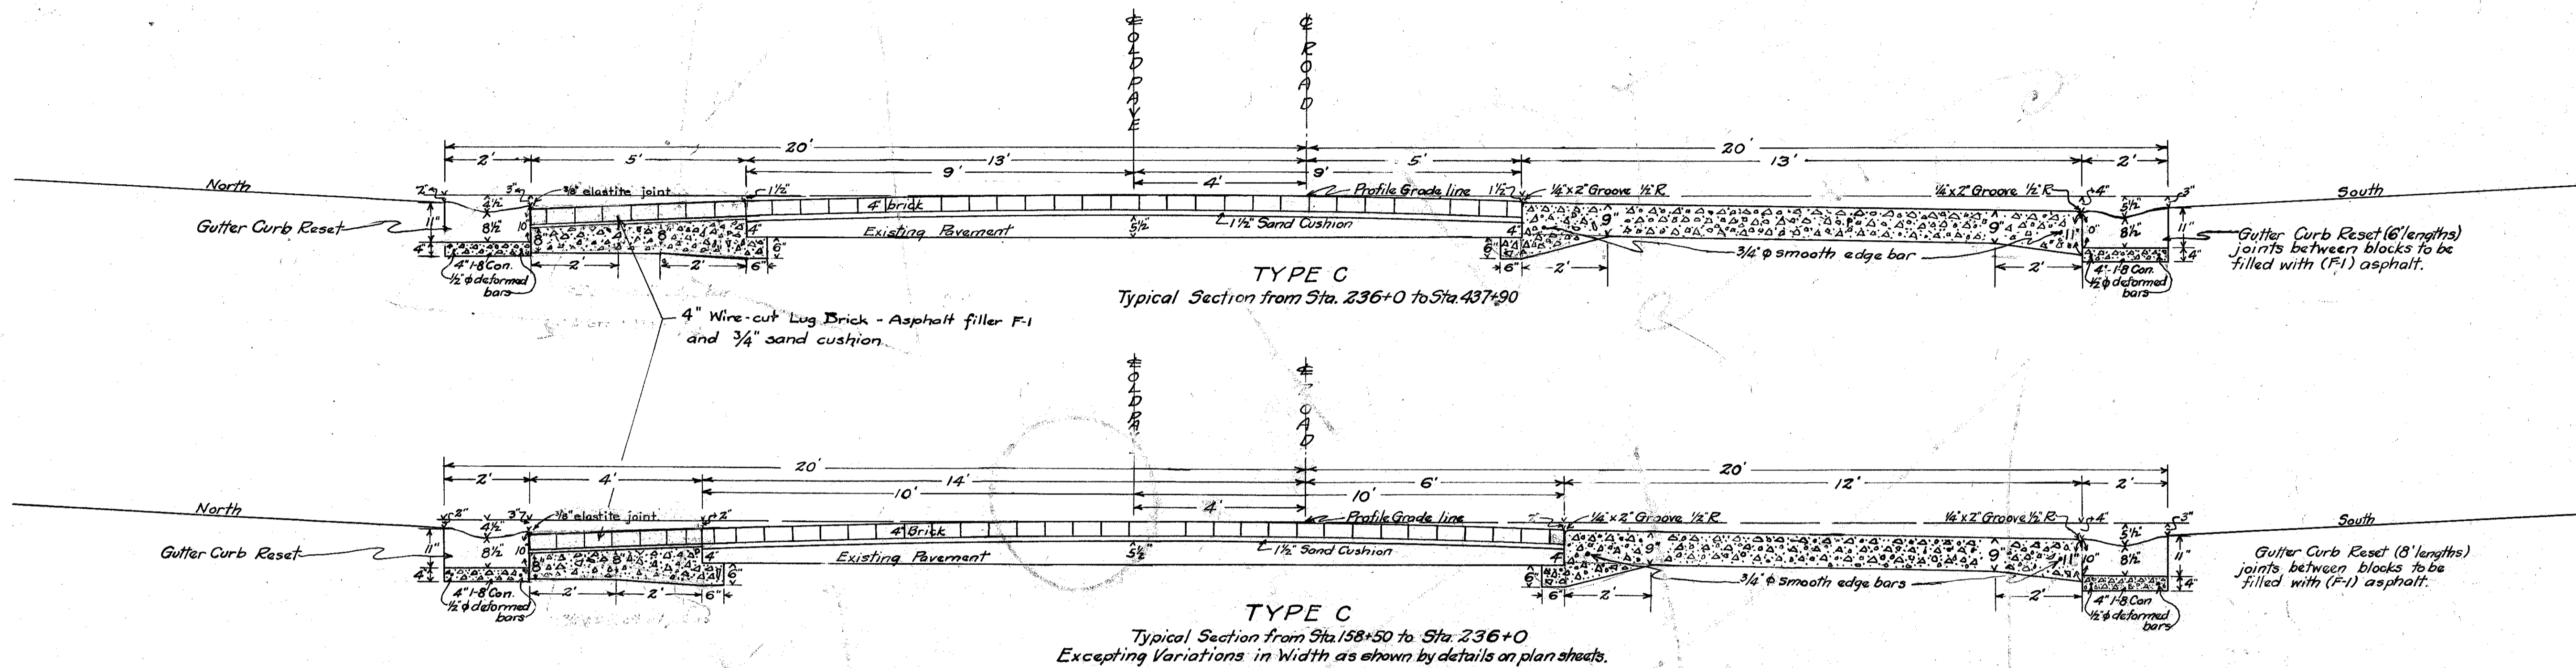


**PLAN OF JOINT**  
Note: Impressed Contraction Joints to be placed at 40 ft. intervals according to Construction Drawing No. 98.

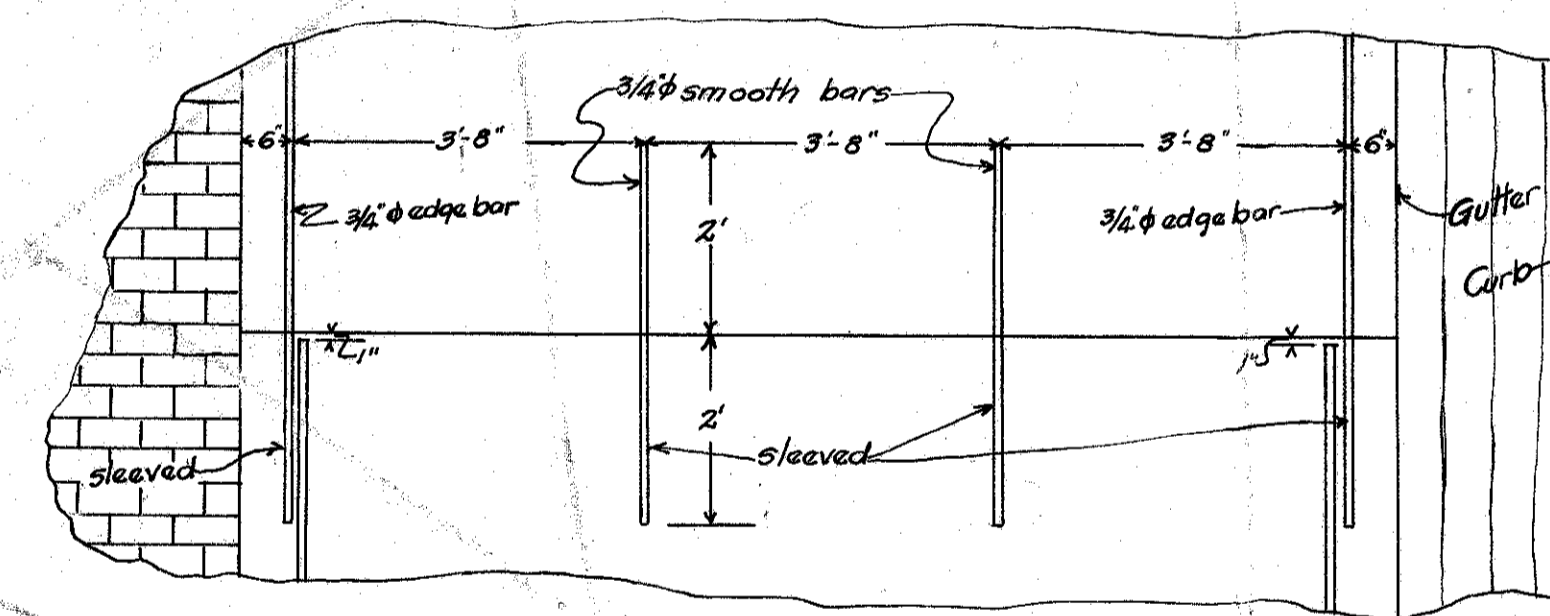

**NOTES**

- Concrete pavement 1-5% mix. All new concrete under existing pavement to be well spaded. Existing pavement damaged by the Contractor in removing old gutter curb or thru any other negligence to be repaired by the Contractor at his own expense.
- Contractor to provide for and maintain two way traffic over old pavement by providing at least two watchmen day and night and lanterns and barricades spaced not more than 300 ft. apart. South side to be completed before North side is touched.
- Contractor shall at no time grade in excess of 3500 lin. ft. ahead of paving.
- Trees to be removed as shown on Summary Sheet No. 52 unless otherwise directed by the Engineer. Trees min. diam. 2" to be planted for each tree removed as directed by the Engineer.
- Waste excavation to be dumped by Contractor on land abutting the improvement as requested by the land owners. Haul not to exceed 200 ft. from side line of road. Cost to be included in price bid for excavation.
- Suitable bridges to provide outlets for traffic to be built at intersecting roads and driveways as directed by the Engineer.

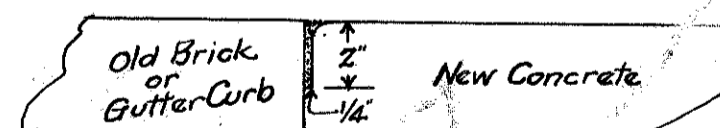

**DETAIL OF GROOVED JOINT.**  
Corner to be rounded to 1/4" R. 1/4" groove to be cut 2" deep below top of old and new pavement and filled with (F-1) asphalt.