



S. H. No 2 SEC. 6, Hin-Mentor LAKE COUNTY
 Geo. A. Cloran
 Chas. N. Rexford
 Persongge M.E. Church

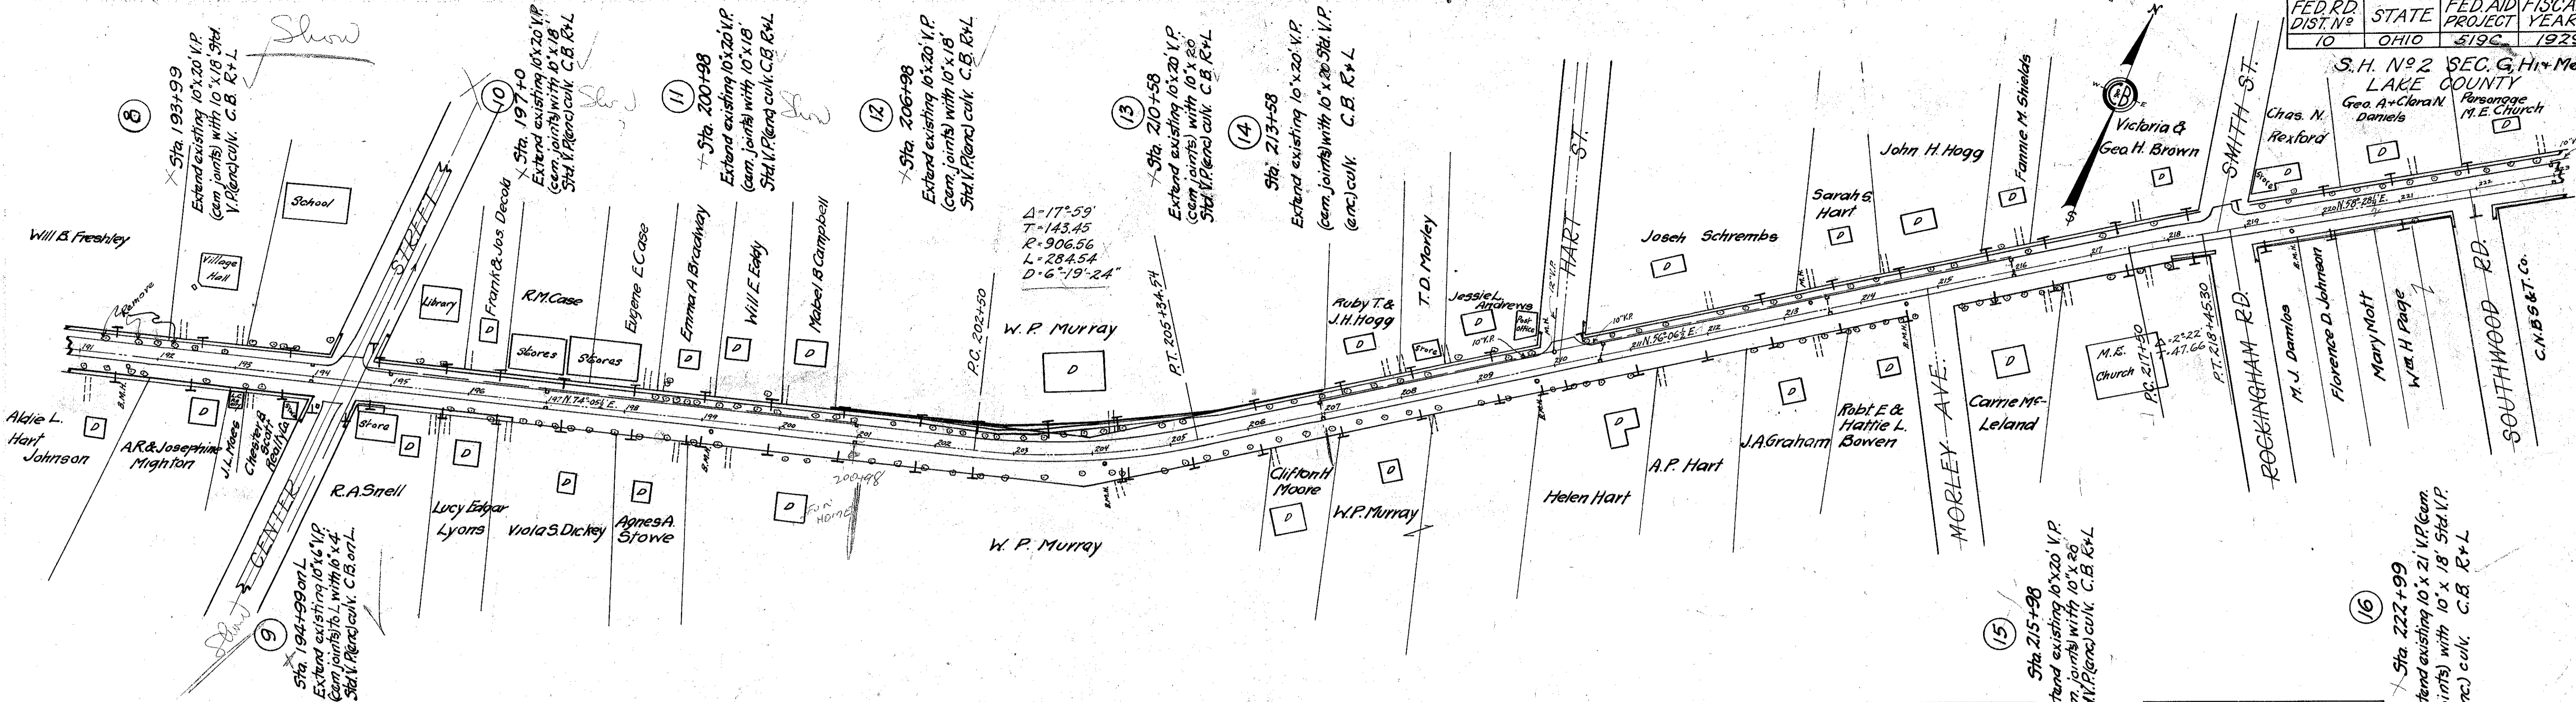

B.M. # 37 Sta. 192+40 Bronze tablets on steep stone U.S.G.S. 100' 60" L of ϕ Elev. = 695.25	B.M. # 38 Sta. 195+82 Spike in side 18" M. 22' 60" L of ϕ Elev. = 693.79	B.M. # 39 Sta. 200+96 Spike in rook 24" M. 24' 60" L of ϕ Elev. = 694.05	B.M. # 40 Sta. 206+33 Spike in rook 24" M. 21' 60" L of ϕ Elev. = 693.19	B.M. # 41 Sta. 212+55 Spike in rook 24" M. 22' 60" L of ϕ Elev. = 694.24	B.M. # 42 Sta. 217+86 Spike in rook 24" M. 24' 60" L of ϕ Elev. = 695.40	B.M. # 43 Sta. 222+80 Spike in side 24" M. 22' 60" L of ϕ Elev. = 692.11
---	--	--	--	--	--	--

Grade line is ϕ profile.

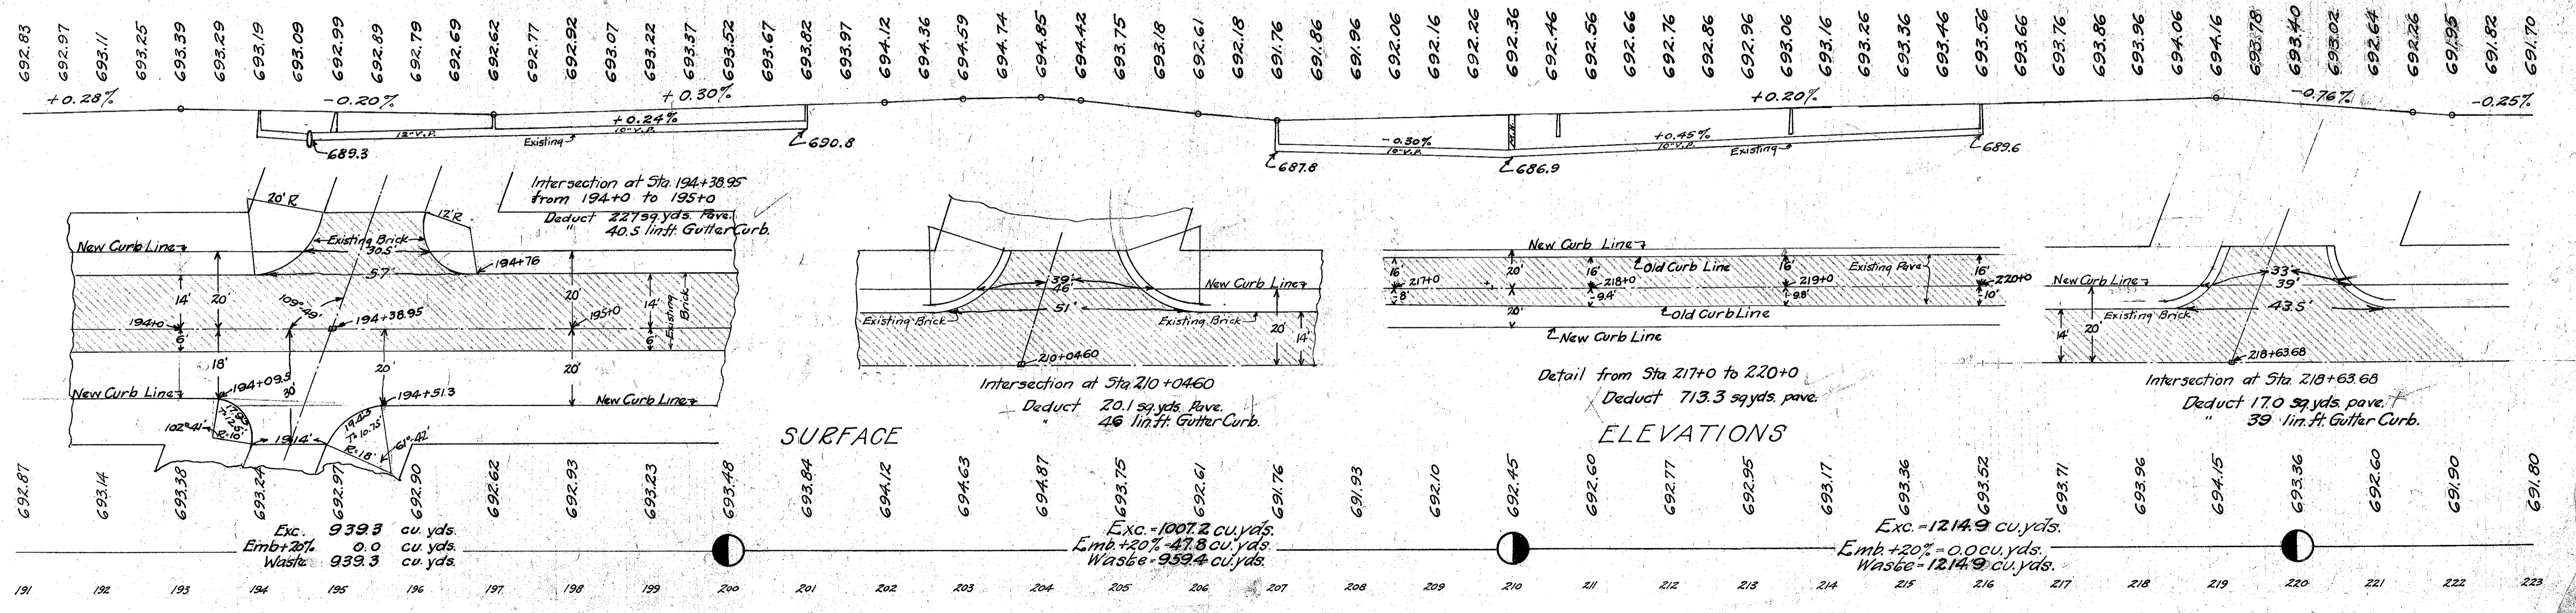

Exc. 939.3 cu. yds.
 Emb+20% 0.0 cu. yds.
 Waste 939.3 cu. yds.

Exc. = 1007.2 cu. yds.
 Emb+20% = 47.8 cu. yds.
 Waste = 959.4 cu. yds.

Exc. = 1214.9 cu. yds.
 Emb+20% = 0.0 cu. yds.
 Waste = 1214.9 cu. yds.