CC-5 #7

S

FED. RD. DIST. NO.	STATE	F.A.G.C. PROJECT	FISCAL YEAR	1 / 3
10	OHIO	FAGM-70A(1)	194	

LAKE COUNTY
SH 520 SEC. PAINESVILLE (PT)
GRADE SEPARATION

SR283-16.69

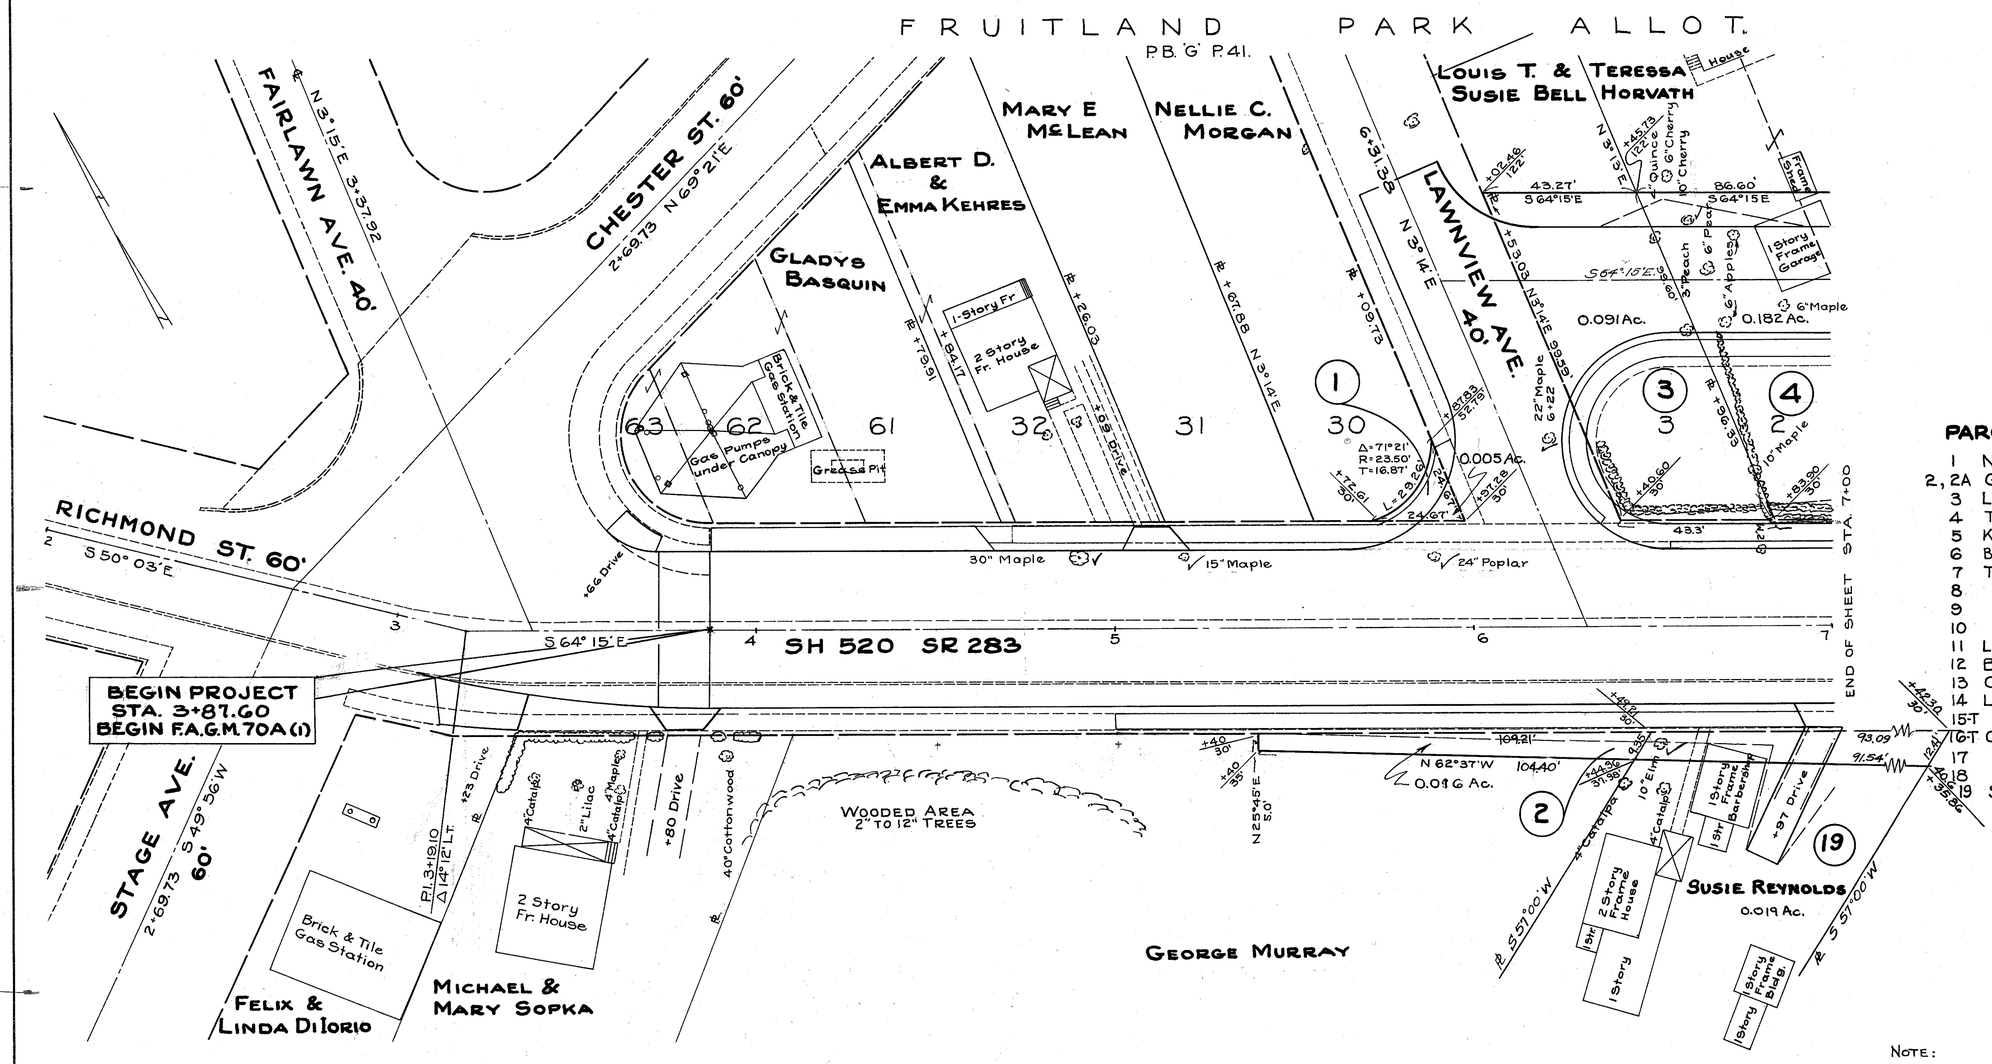

PARCEL LEGEND

1 NELLIE C. MORGAN
2, 2A GEORGE MURRAY
3 LOUIS T. & SUSIE BELL
4 TERESSA HORVATH
5 K. & ANNA SARNA
6 BEN JACKSON
7 THE L.S. & M.S. R.R. CO.
8 "
9 "
10 "
11 LAKE SHORE LUMBER & COAL CO. INC.
12 B. & O. R.R. CO.
13 CITY OF PAINESVILLE
14 LAKE SHORE LUMBER & COAL CO. INC.
15-T "
16-T CITY OF PAINESVILLE
17 "
18 "
19 SUSIE REYNOLDS

NOTE:

The dimensions in the property lines between Parcels 2, 19, & 2A were revised as of April 28, 1941

12

RIGHT OF WAY STA. 2+00 TO STA. 7+00