


Erad Area		Cu. Yds.	
Cut	Fill	Cut	Fill
0.0		751.0	
0		723	
0.0		808.0	
0		697	
0.0		762.2	
0		689	
0.0		725.0	
0		579	

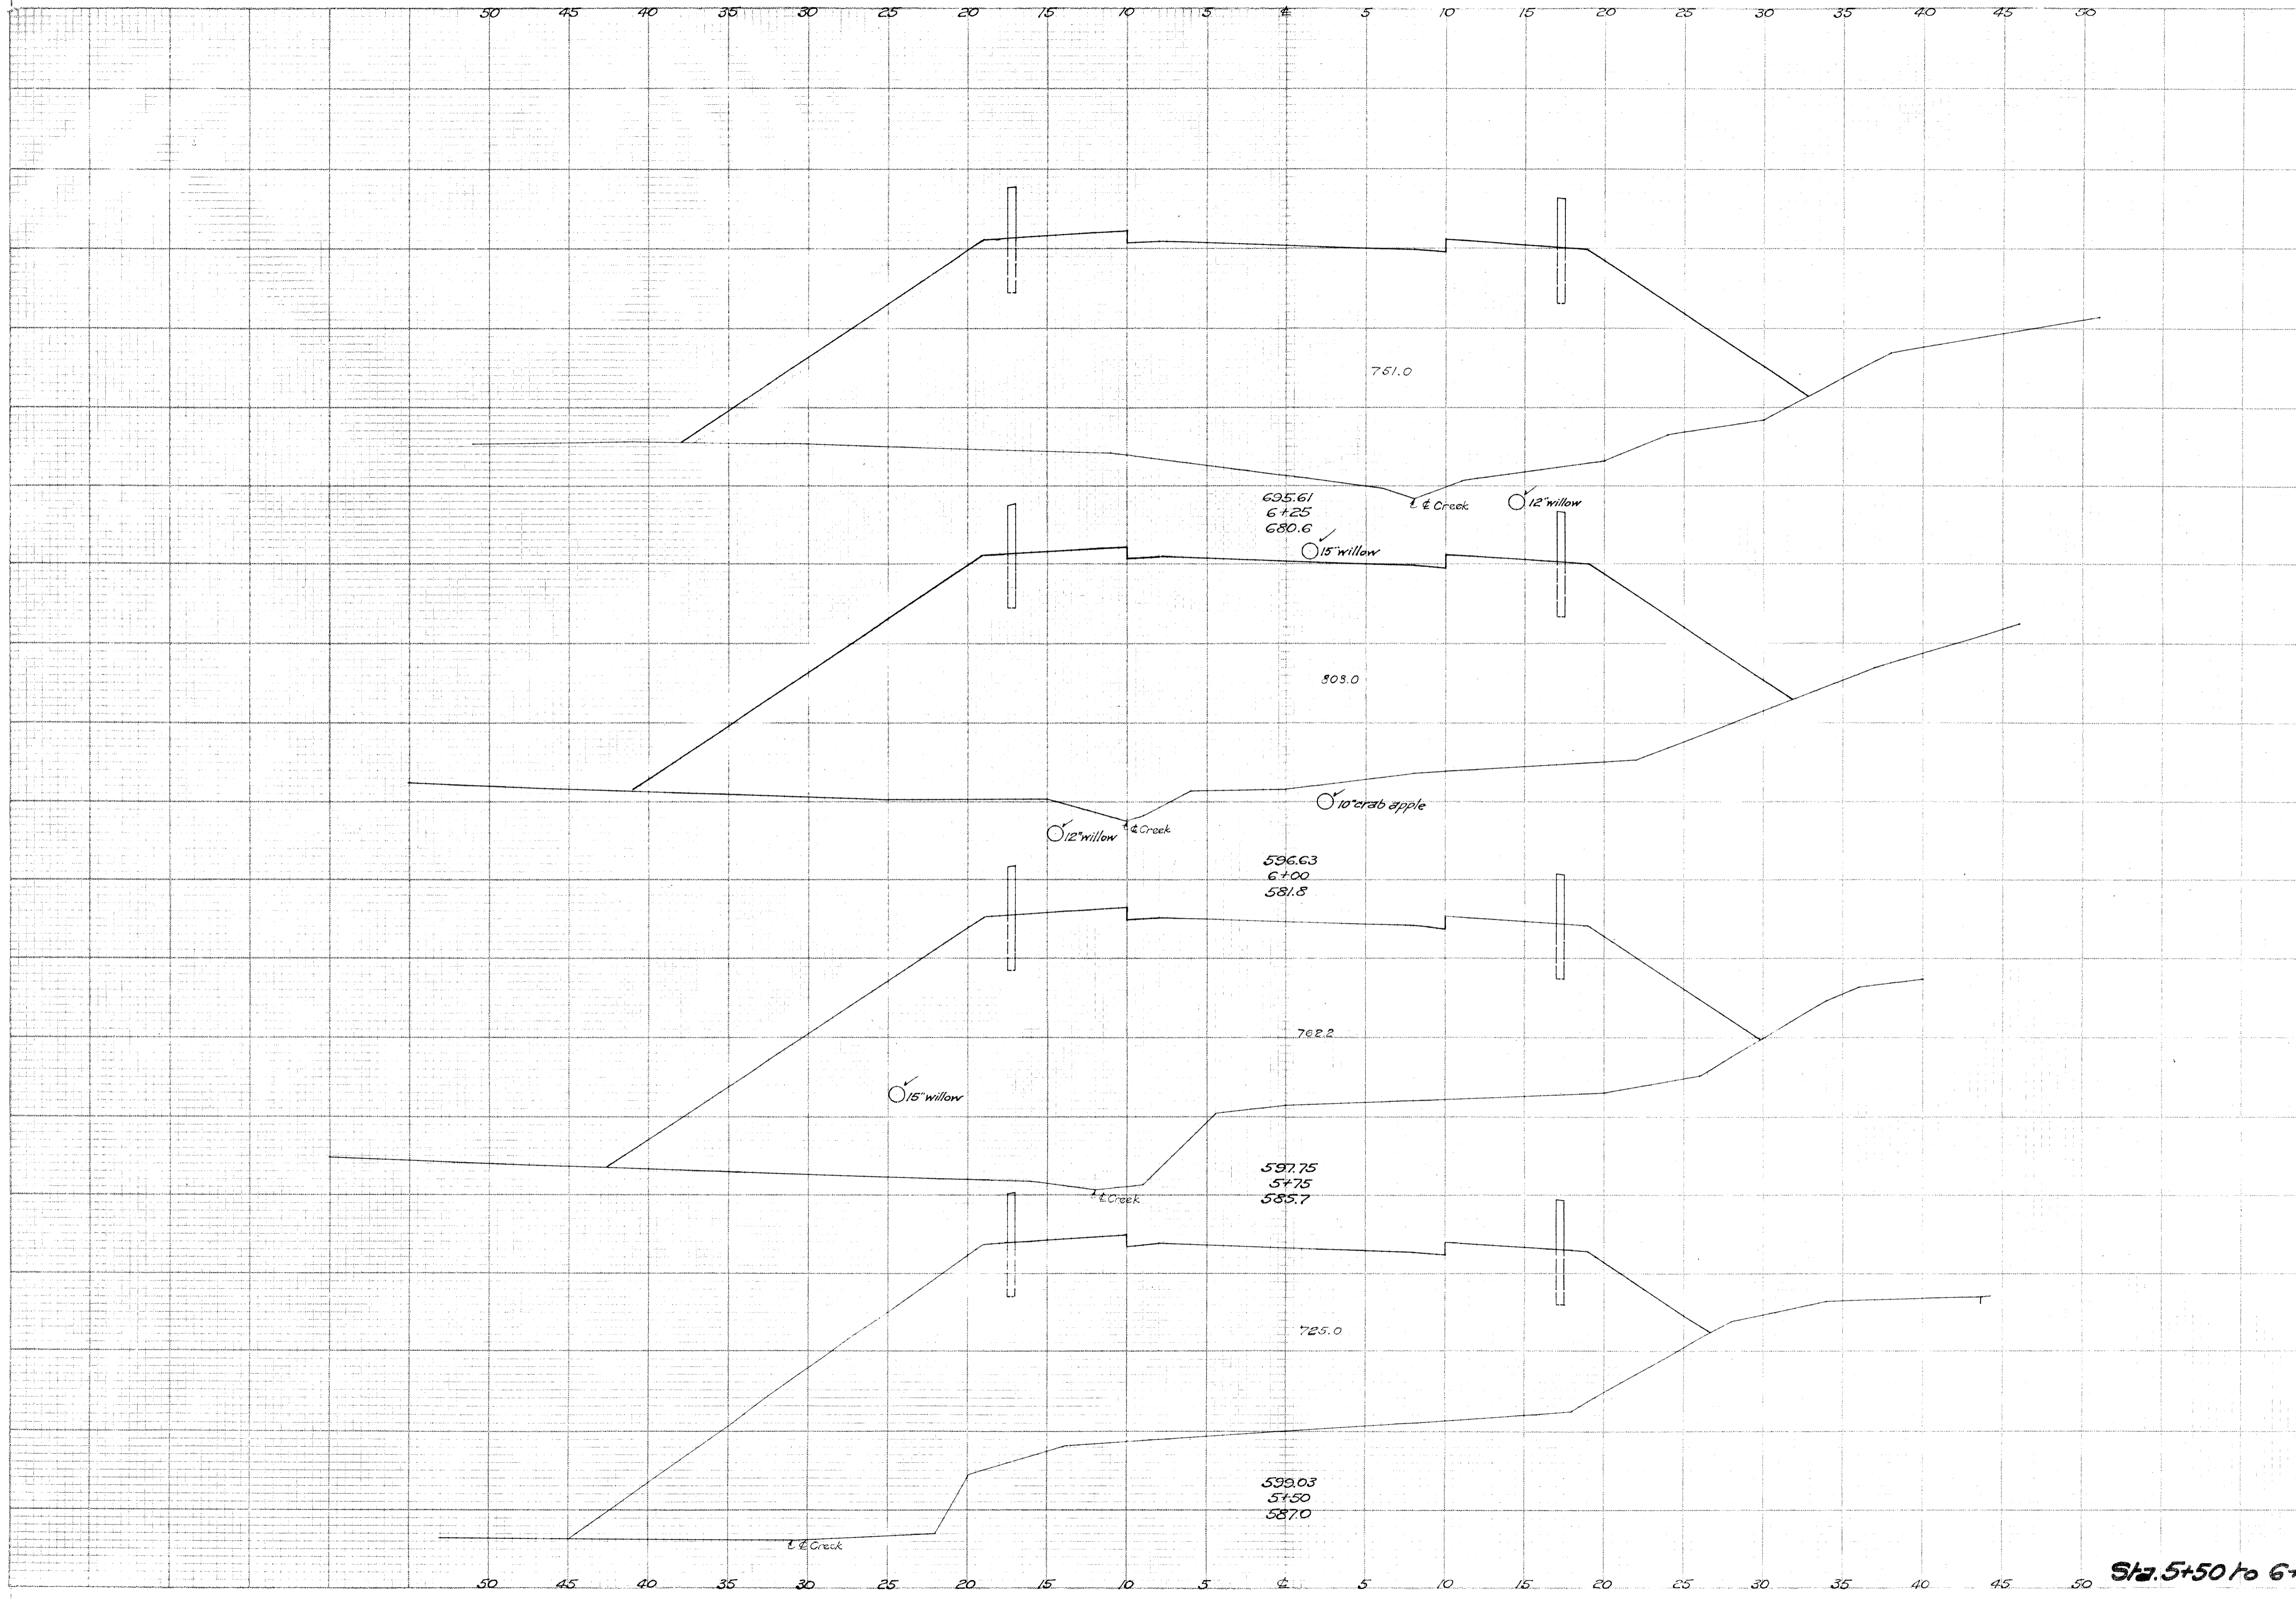

FINAL SURVEY  
 SUBMITTED BY  
 PLANNED BY  
 CHECKED BY  
 DATE

BY  
 DATE  
 CHECKED BY  
 DATE

Sta. 5+50 to 6+25