


UNDESIGNED
APR 24 1984


FHWA REGION	STATE	PROJECT	
5	OHIO		

83
101

LAKE COUNTY
LAK 306-6.15

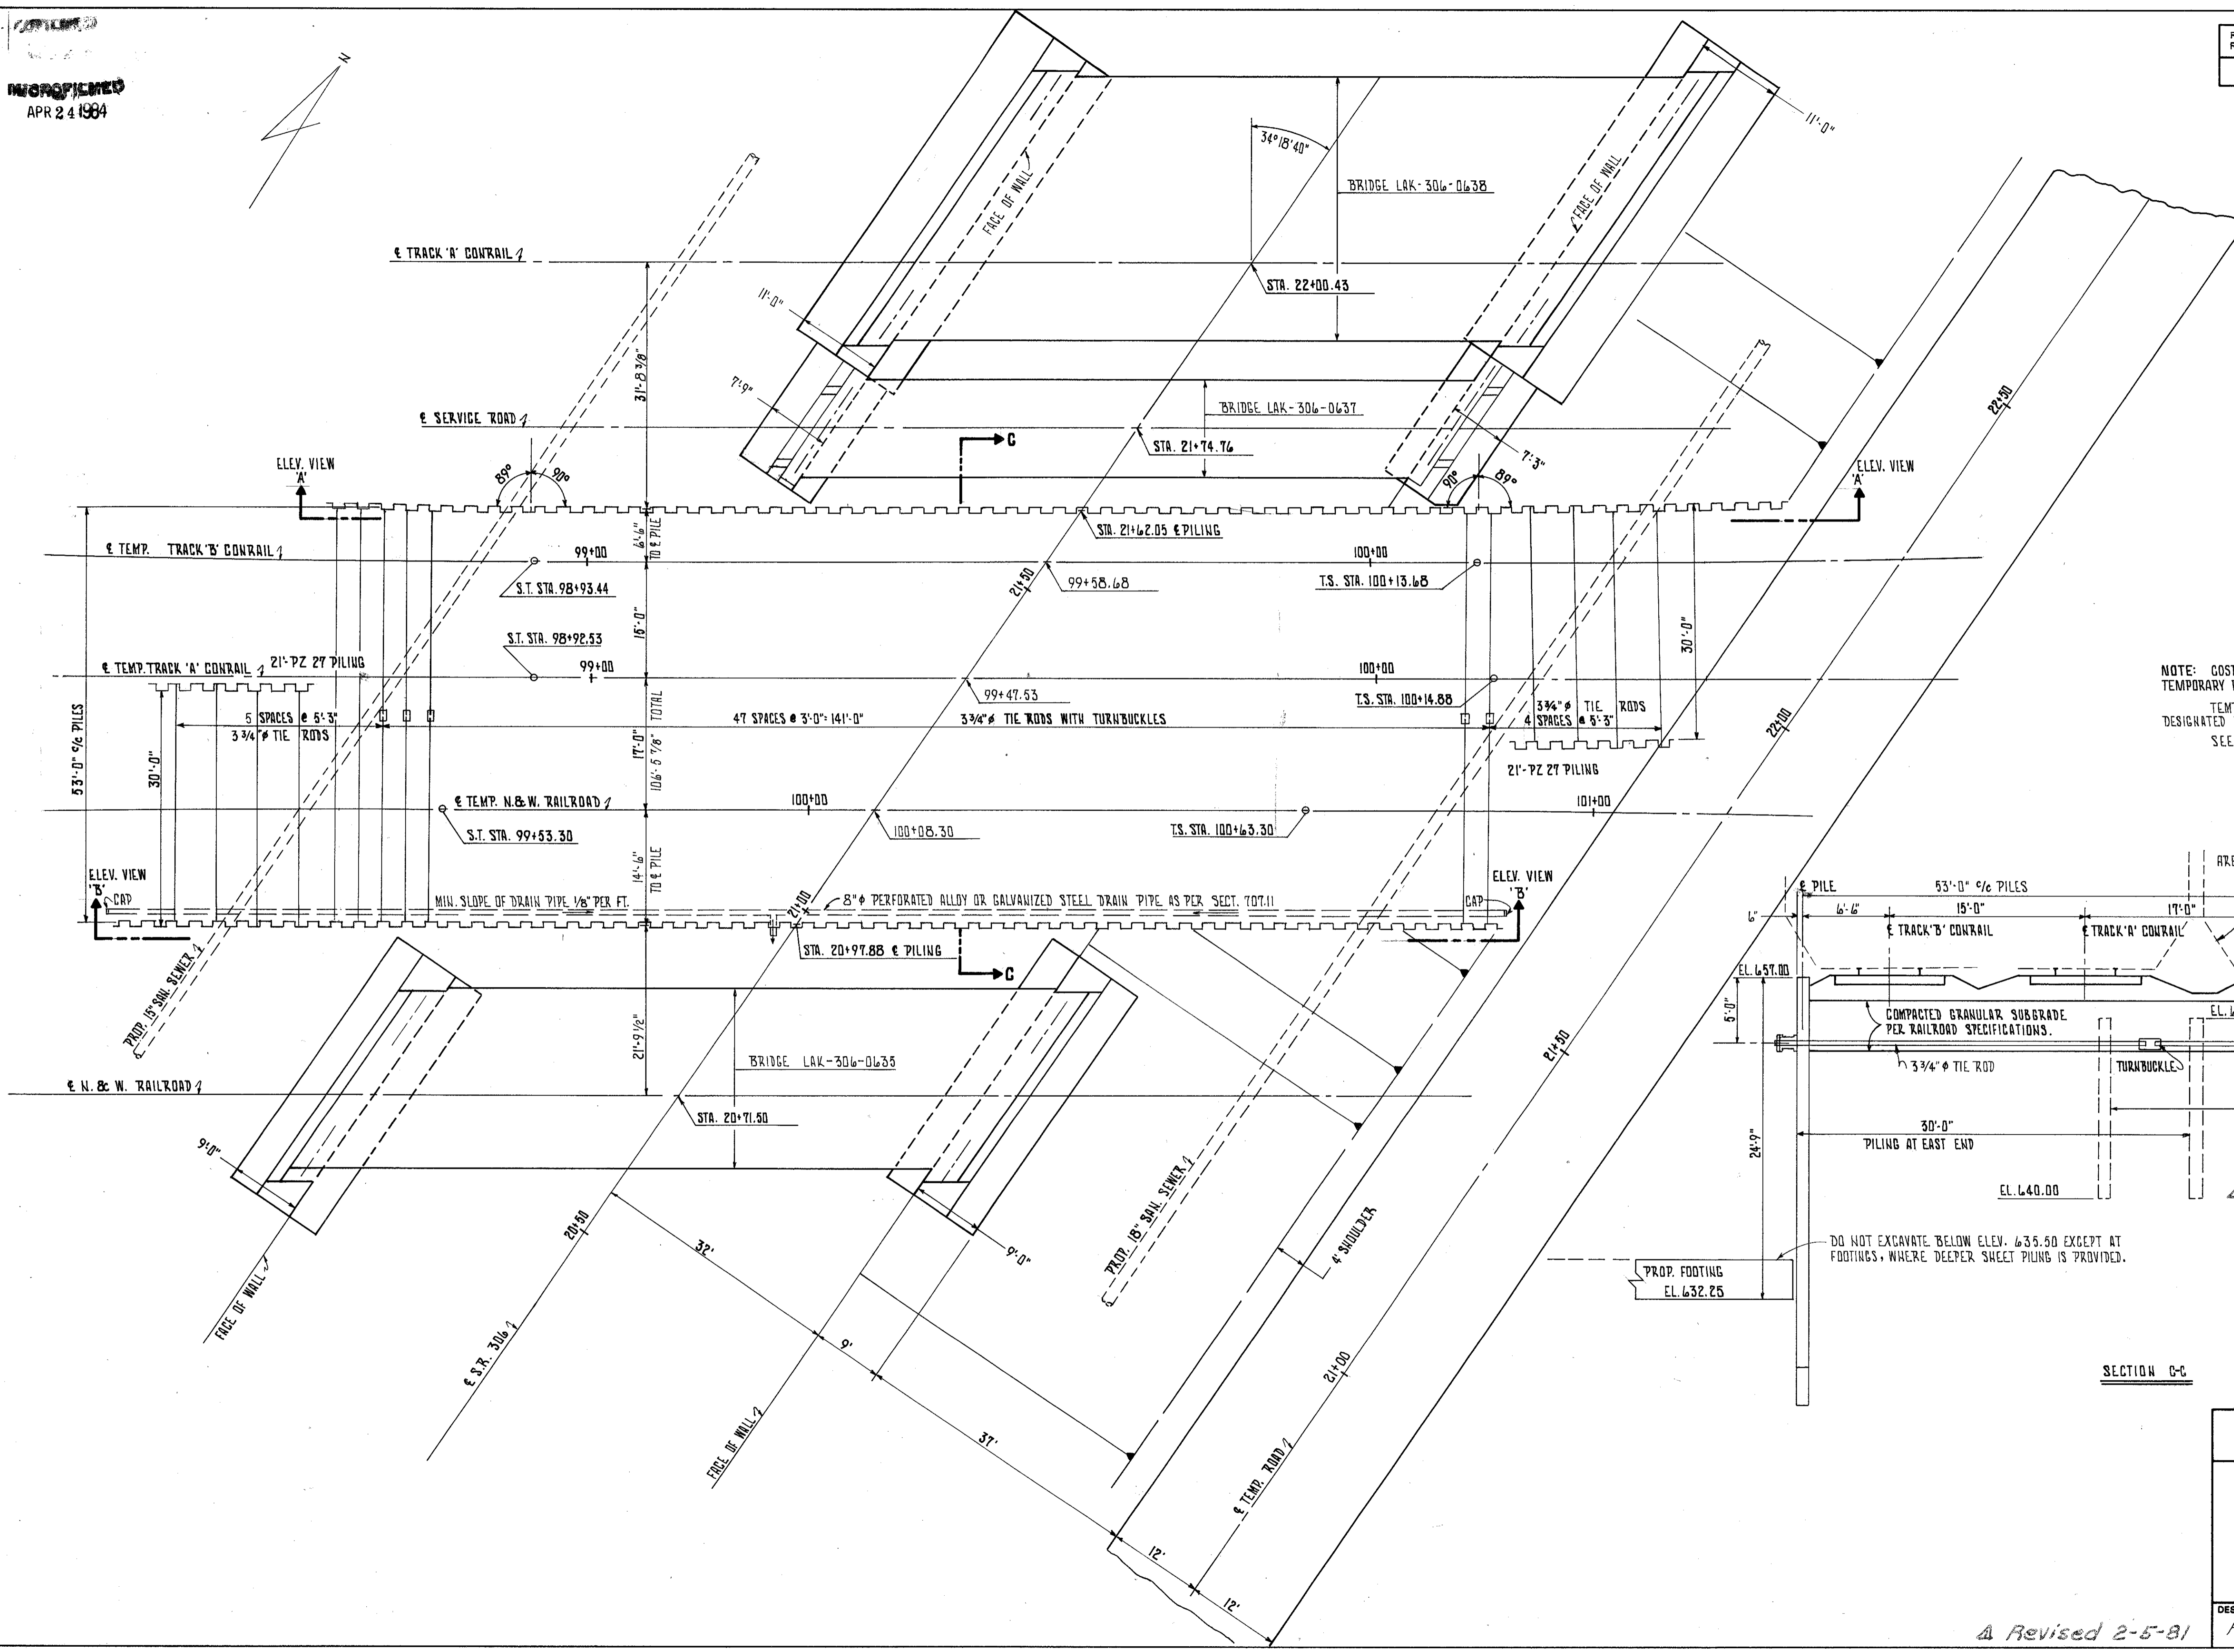

NOTE: COST OF SHEET PILING INCLUDED WITH COST OF TEMPORARY RUN-AROUND FOR RAILROADS.
TEMPORARY LOCATION OF SERVICE ROAD TO BE DESIGNATED BY CONTRACTOR.
SEE SHEET NO. 24 OF 28 FOR ELEVATION VIEWS.

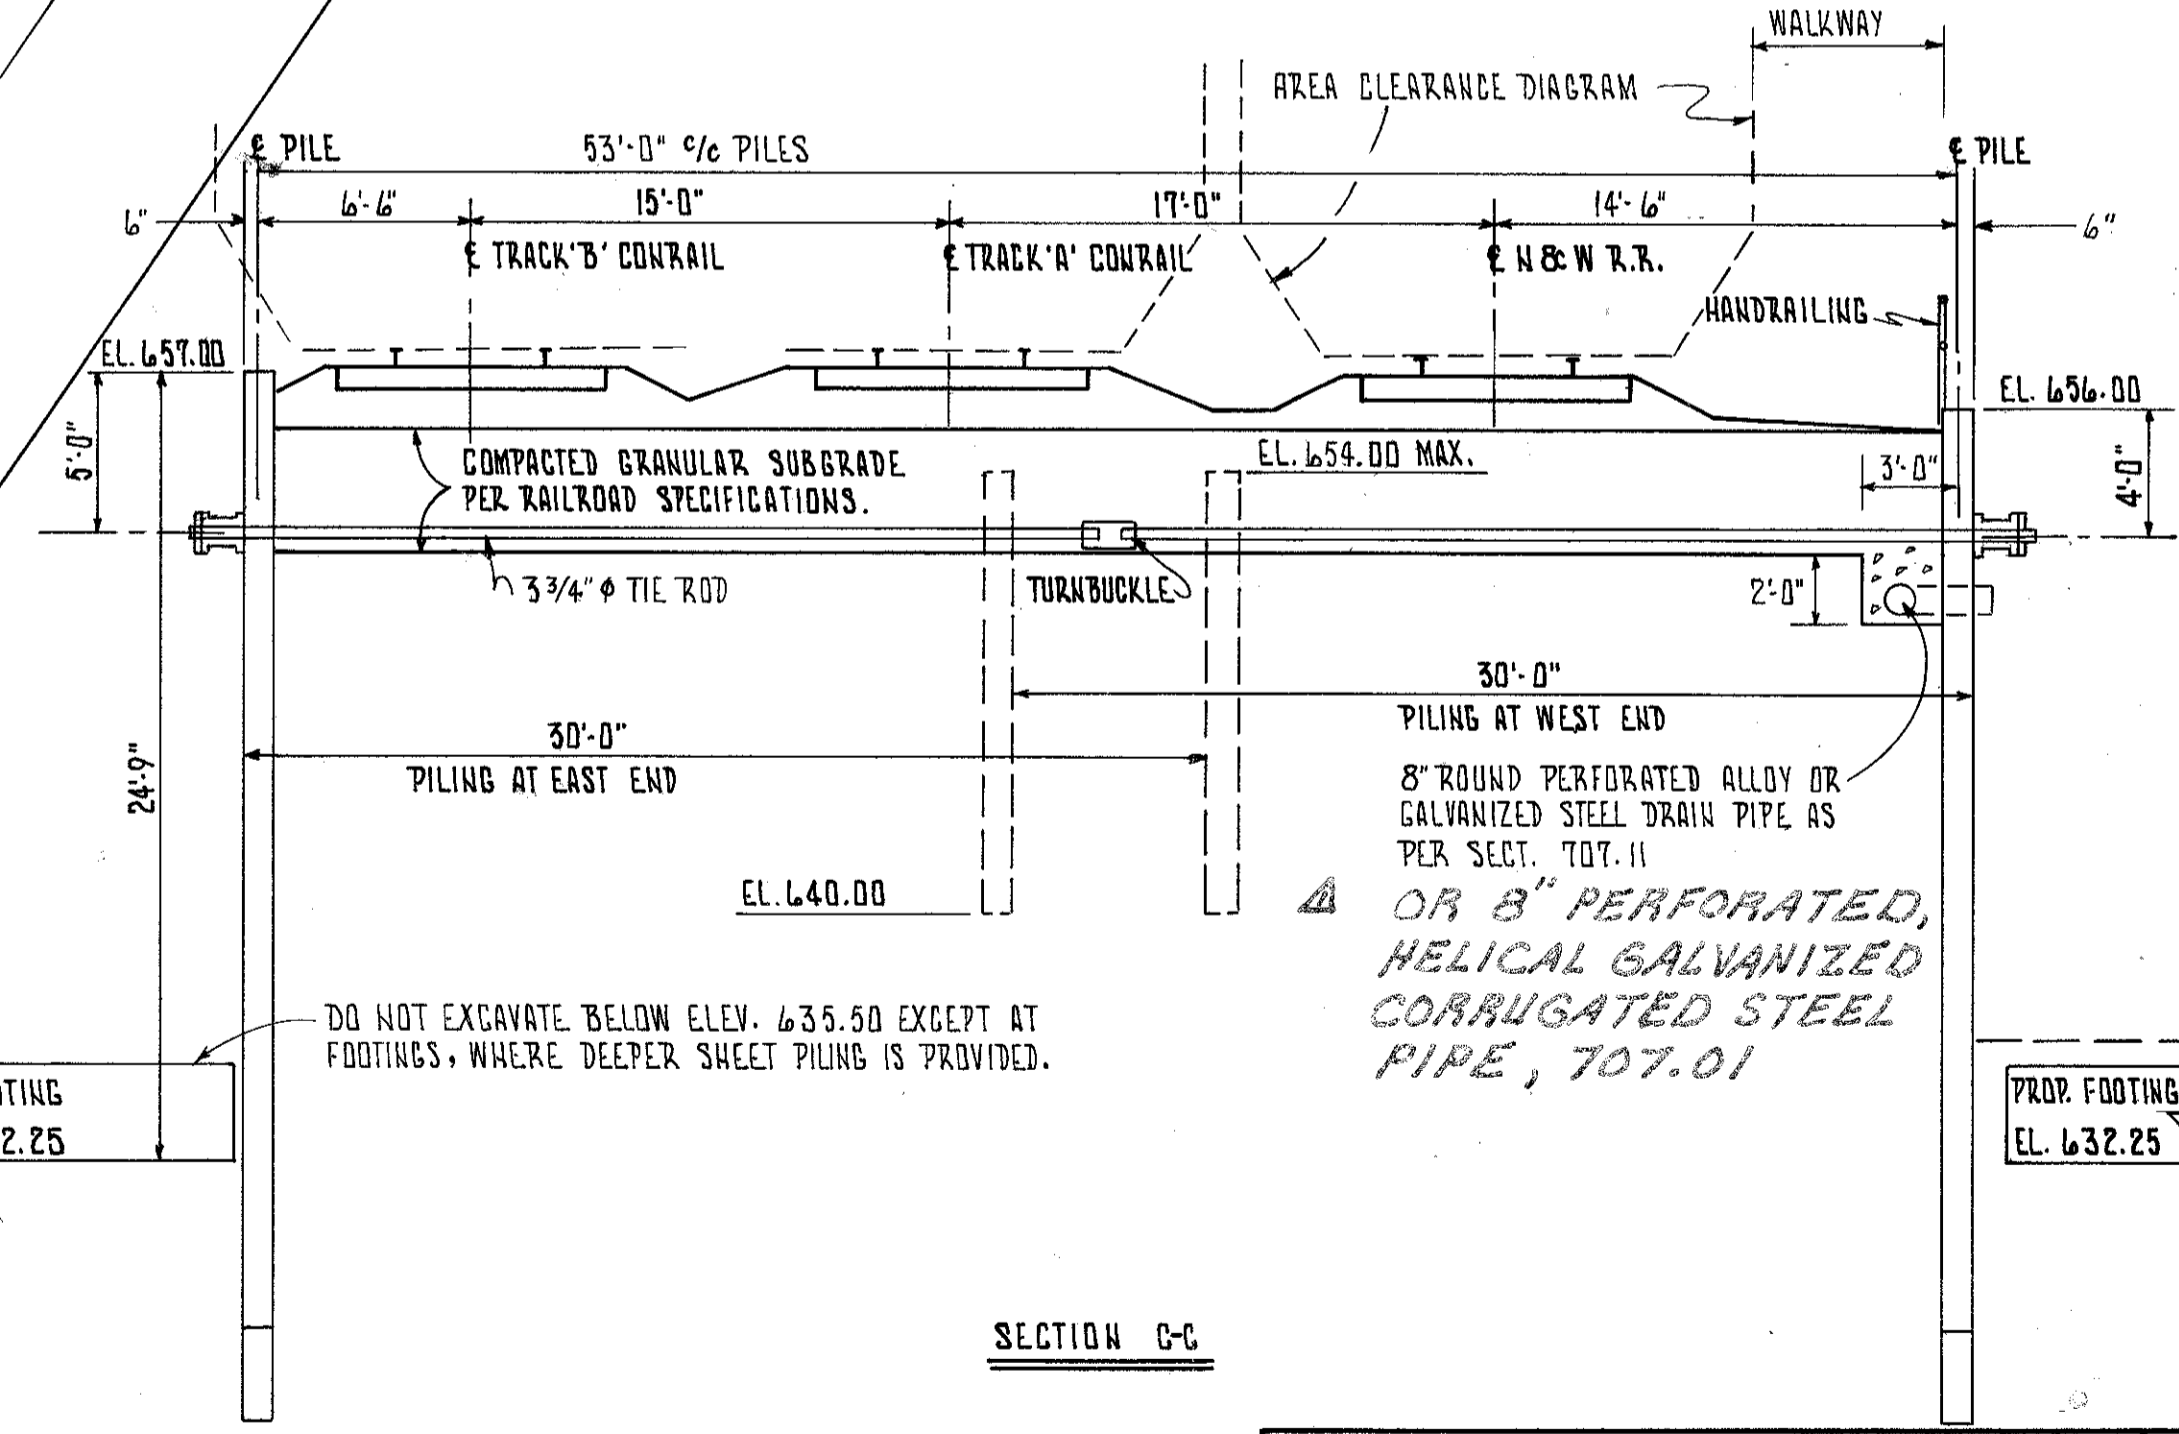

SECTION C-C

FRANKLIN CONSULTANTS INC. 23 / 28						
COLUMBUS, OHIO						
SUPPORTING STRUCTURE						
FOR DETOURED CONRAIL AND N & W RAILROADS						
OVER S.R. 306						
DESIGNED	DRAWN	TRACED	CHECKED	REVIEWED	DATE	REVISED
MM	MM	RM	SM	JF	10/22/79	

Revised 2-5-81

BRUNING 44-132 306-6.15