CALC. BY DATE		LAK - 306 - 7.12	OHIO	423 / 452
CHKD. BY DATE			FHWA REGION 5	

54 / 83

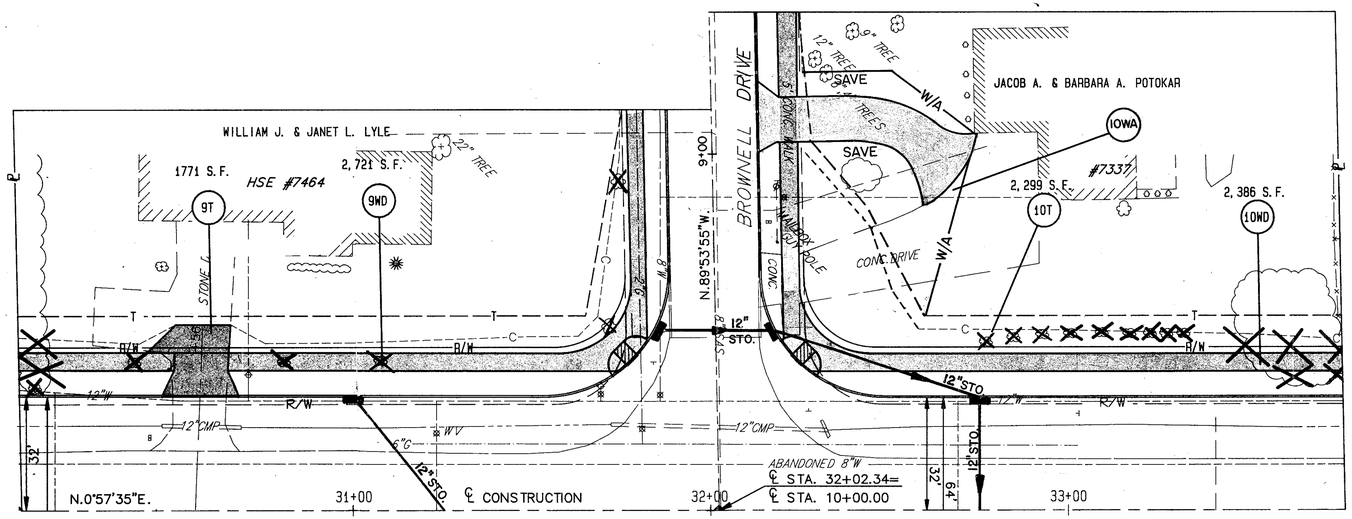

STATE ROUTE 306

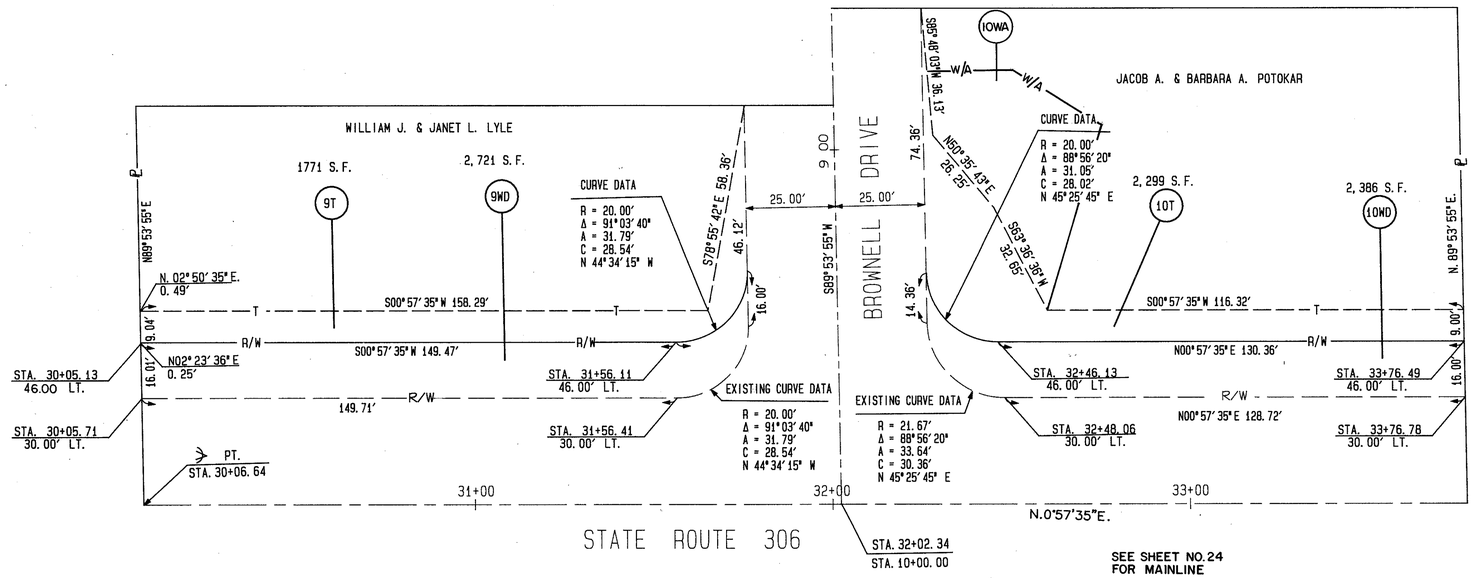

STATE ROUTE 306

SEE SHEET NO.24 FOR MAINLINE

REV.	DATE	
	8-24-90	ADDED DRIVE AND PARCEL 10WA
COMPLETION DATE:		

4-27-90

LAK—306—7.12

RIGHT-OF-WAY PLANS BROWNELL DRIVE