




CALC. BY	
DATE	
CHKD. BY	
DATE	

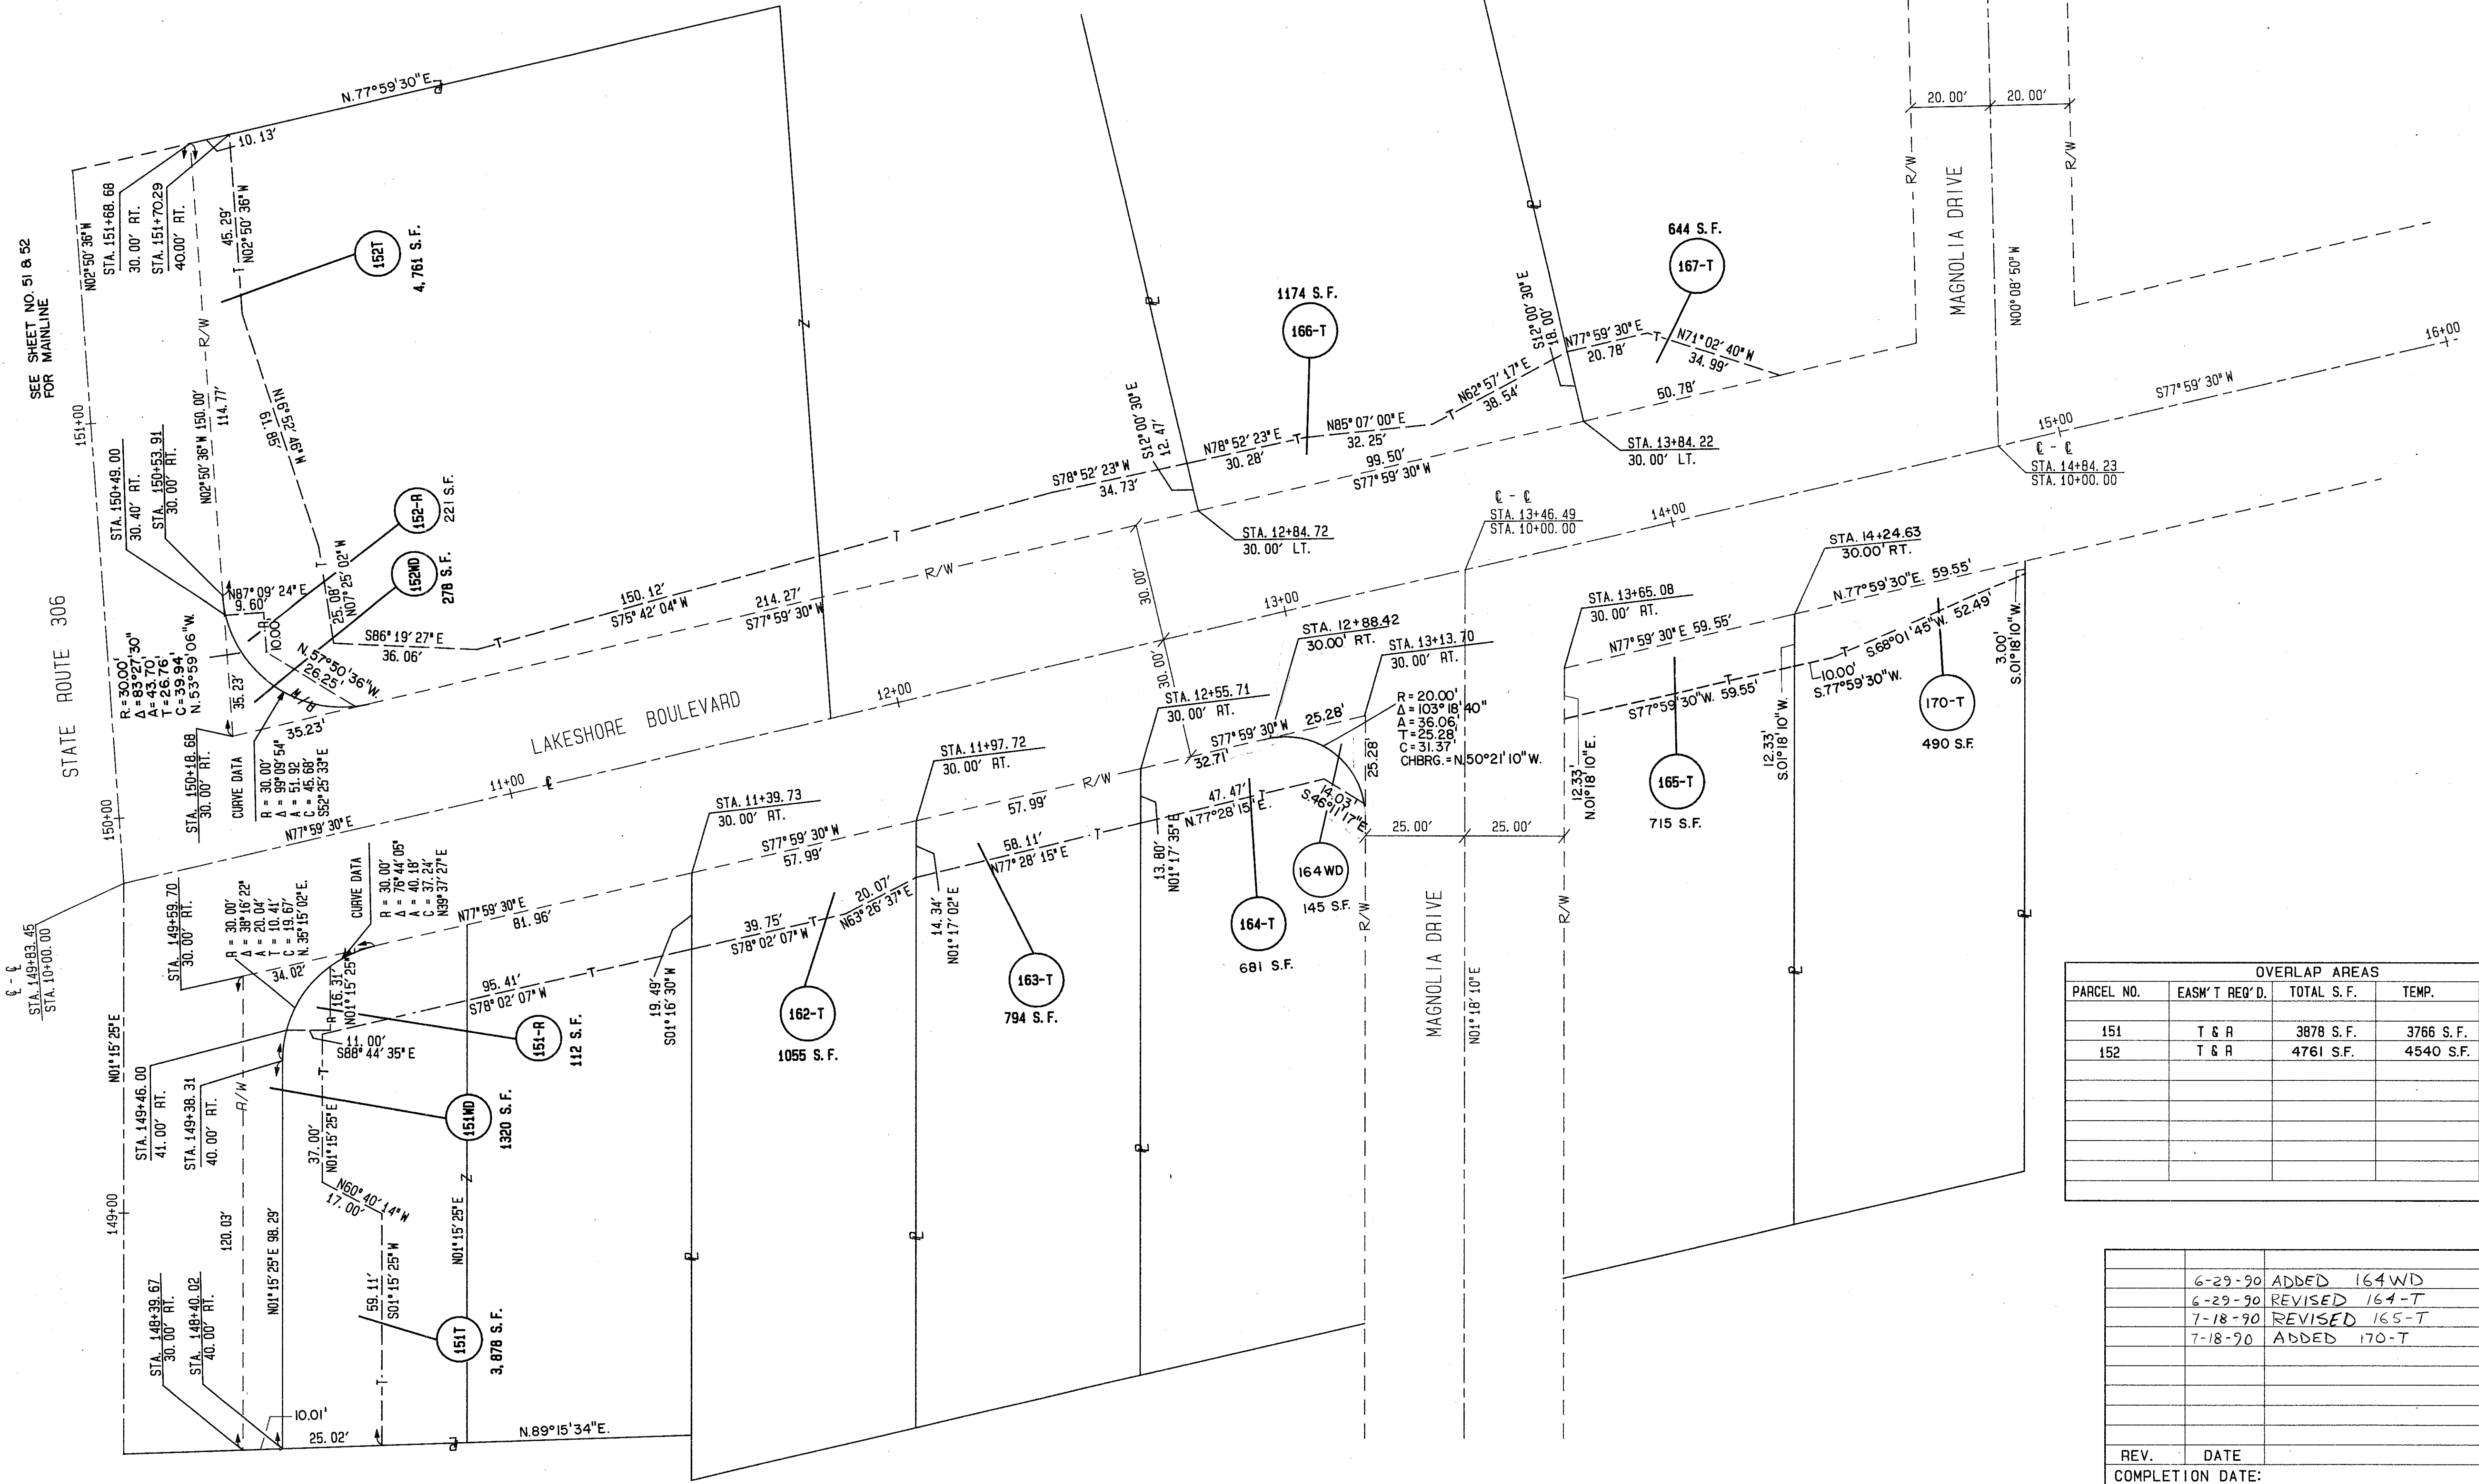

OVERLAP AREAS				
PARCEL NO.	EASM'T REQ'D.	TOTAL S.F.	TEMP.	TRAFFIC
151	T & R	3878 S.F.	3766 S.F.	112 S.F.
152	T & R	4761 S.F.	4540 S.F.	221 S.F.

6-29-90	ADDED 164WD
6-29-90	REVISED 164-T
7-18-90	REVISED 165-T
7-18-90	ADDED 170-T
REV.	DATE
COMPLETION DATE:	